


CORPORATE
BOUNDARY LINE
DONATION LAND
CLAIM (DLC #)

SW 1/4 of the SW 1/4 of SECTION 21
T3S, R1E of the WILLAMETTE MERIDIAN
CLACKAMAS COUNTY, OREGON

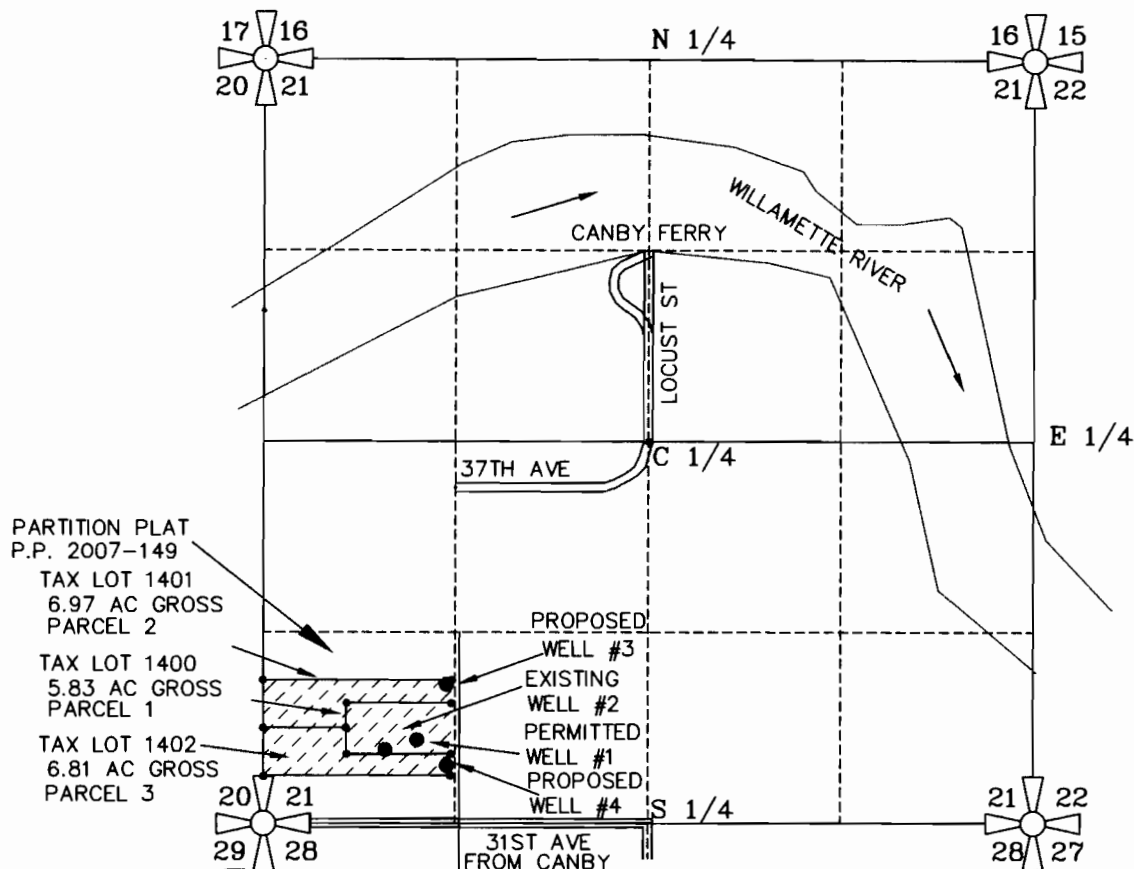

SEC.	1/4 1/4	IRRIG. ACRES	CFS (APPROX. GPM)
21	SW SW	19.5 ACRES NURSERY	0.18 CFS (80.8 GPM) @ 1/108.33 CFS/AC DAY


EXISTING CERTIFICATE 29297 IS FOR 0.18-CFS ON 19.5-ACRES.
(PERMIT G-895 WITH PRIORITY DATE OF JUNE 30, 1958).
(CERTIFICATE DATE JANUARY 31, 1962).
(APPLICATION G-997).
USE: IRRIGATION PRIMARY.

PERMITTED WELL #1: LOCATED 577.5 FEET (8-3/4 CHAINS) NORTH
and 1056.0 FT (16 CHAINS) EAST of the SOUTHWEST CORNER of
SECTION 21, TOWNSHIP 3 SOUTH, RANGE 1 EAST of the WM,
CLACKAMAS COUNTY, OREGON (Located in the SOUTHWEST QUARTER
of the SOUTHWEST QUARTER of said SECTION 21).

EXISTING WELL #2: LOCATED 510 FEET NORTH AND 835 FEET EAST
of the SOUTHWEST CORNER of SECTION 21, TOWNSHIP 3 SOUTH,
RANGE 1 EAST of the WM, CLACKAMAS COUNTY, STATE of OREGON.
(Is located in the SOUTHWEST QUARTER of the SOUTHWEST
QUARTER of said SECTION 21).

PROPOSED WELL #3: Will be located 960 FEET NORTH AND 1260 FT
EAST of the SOUTHWEST CORNER of SECTION 21, TOWNSHIP 3 SOUTH,
RANGE 1 EAST of the WM, CLACKAMAS COUNTY, STATE of OREGON.
(Is located in the SOUTHWEST QUARTER of the SOUTHWEST
QUARTER of said SECTION 21).


PROPOSED WELL #4: Will be located 400 FEET NORTH and 1260 FT
EAST of the SOUTHWEST CORNER of SECTION 21, TOWNSHIP 3 SOUTH,
RANGE 1 EAST of the WM, CLACKAMAS COUNTY, STATE of OREGON.
(Is located in the SOUTHWEST QUARTER of the SOUTHWEST
QUARTER of said SECTION 21).

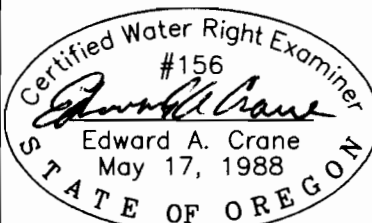

Renewal 12/31/2009
Signed 4/20/2009

SURVEYED APRIL 6, 2009
BY EDWARD A. CRANE, CWRE

PREPARATION OF THIS MAP
WAS FOR THE PURPOSE OF
IDENTIFYING THE LOCATION
OF WATER RIGHTS ONLY &
HAS NO INTENT TO PROVIDE
DIMENSIONS OR LOCATION
OF PROPERTY OWNERSHIP
LINES.

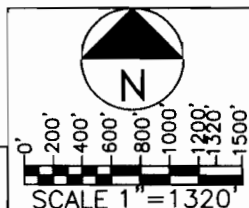

GROUNDWATER TRANSFER APPL.
GROUNDWATER CERT. 29297

DATE

APRIL 2009

PROJECT NO.

555-001



EDWARD A. CRANE
CWRE

13755 SE 119TH DRIVE
CLACKAMAS, OREGON 97015

OFFICE: 503-698-3890
FAX NO: 503-698-3861
CELL: 503-679-3253
E-MAIL: eces1@verizon.net

APPLICATION FOR PERMIT NUMBER G-

PERMIT NUMBER G- IN THE NAME OF:

DUANE L. WEEKS & JANICE M. WEEKS
3185 N. HOLLY STREET (TEL: 503-266-3631)
CANBY, OREGON 97013

SHEET

1/1

T 10857