

RECEIVED
 MAY 08 2009
 MAR 05 2009

WATER RESOURCES DEPT
 SALEM, OREGON

Pleasant View Canal

8TH AVENUE

COUNTY ROAD

Points of Appropriation

T 10849

WELL 1: Authorized POA for Certificate 55107 is well located 640 feet S and 750 feet E from NW Corner of Section 2. Well Log UMAT 3920. This well will be decommissioned upon approval of proposed transfer and construction of replacement well.

WELL 2: Proposed (new) POA is a new drilled well to be located within 10-15 feet of existing, authorized well. No well log (not yet drilled). Proposed well will be cased and sealed into basalt aquifer.



Place of Use

9.8 acres in NW/4 NW/4, S2, T5N, R35E, WM (TL 100). Place of use will not be changed.


T5N, R35E, Section 2, WM
 Umatilla County



1 inch = 400 feet

The purpose of this map is to identify the location of a water right. It is not intended to provide information regarding the location of property ownership boundary lines.

FOUNTAINHEAD
 1204 Alvarado Terrace
 Walla Walla, WA 99362
 (509) 529-2646 phone

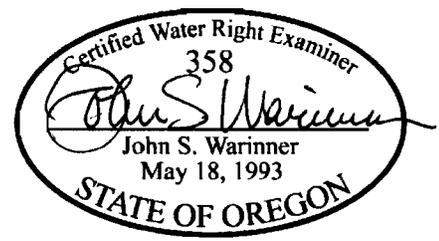

**TRANSFER MAP
 Change POA
 Certificate 55017**

in the name of
RICHARD FUNK
 Revised 26 JAN 2009