


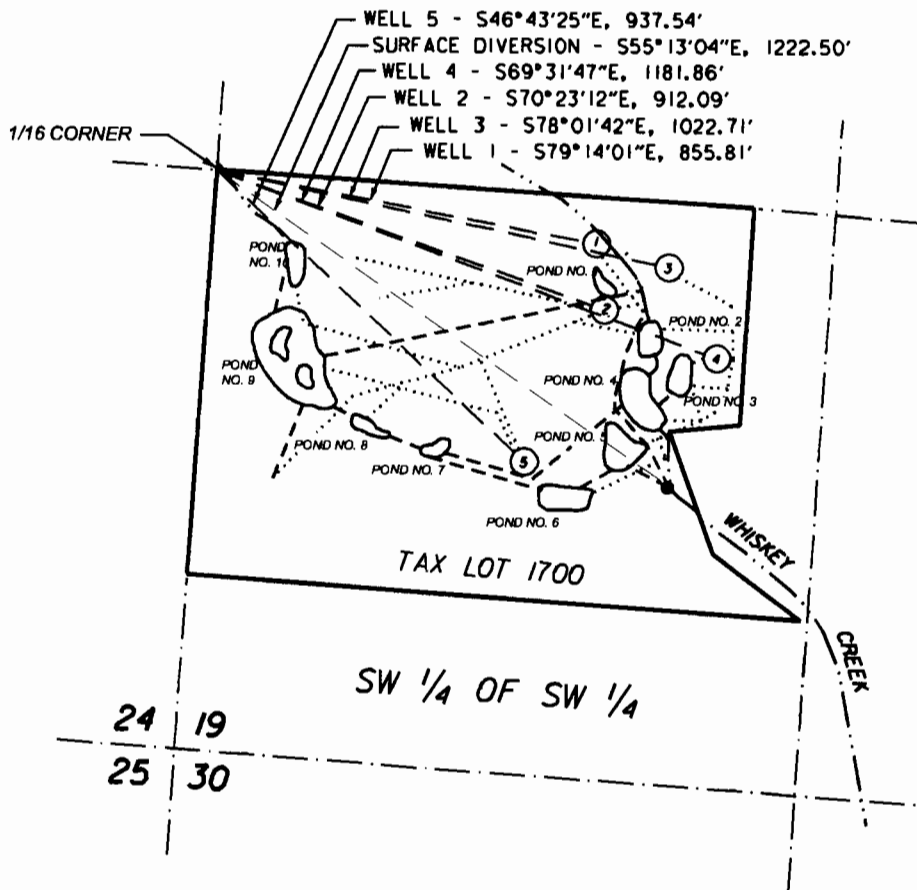


- (X) - WELL IDENTIFICATION NUMBER
 EACH WELL IS EQUIPPED WITH A 1" MASTER METER, INC. MULTI-JET WATER METER IN THE DISCHARGE MANIFOLD, IMMEDIATELY DOWN-STREAM OF THE WELL-HEAD.
- - SURFACE WATER POINT OF DIVERSION
 - PRESSURE PIPING (LESS THAN 3" DIAMETER)
 ----- GRAVITY PIPING (GREATER THAN 6" DIAMETER)



SCALE: 1" = 400'

SECTION 19, T.2S., R.6E., W.M.
 CLACKAMAS COUNTY, OREGON

This drawing is an exhibit for a Water Right Transfer Proof Survey. It is not a Land Survey. Property lines and/or other lines of occupation show hereon are not represented by the undersigned to meet Land Survey accuracy standards.

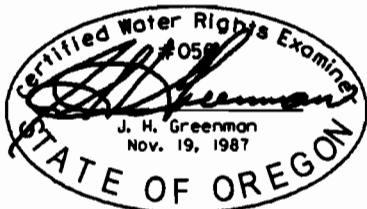


RECEIVED

MAY 11 2009

WATER RESOURCES DEPT
 SALEM, OREGON

Transfer Application No. _____
 Reference Certificate No. 85408

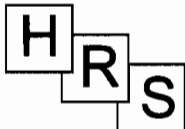

HANER, ROSS &
 SPORSEEN, INC.

15 S.E. 82ND DRIVE
 GLADSTONE, OREGON 97027

MICHAEL D. KAISER
 WATER RIGHT TRANSFER
 APPLICATION

630K