

RECEIVED


MAY 15 2009

WATER RESOURCES DEPT
SALEM, OREGON

WATER RIGHT TRANSFER TO QUASI MUNICIPAL AND PORTION TO NEW P.O.D. IN SECTION 25, T5N, R5W COLUMBIA COUNTY, OREGON

MARCH 20, 2009

CERTIFICATE # 84875

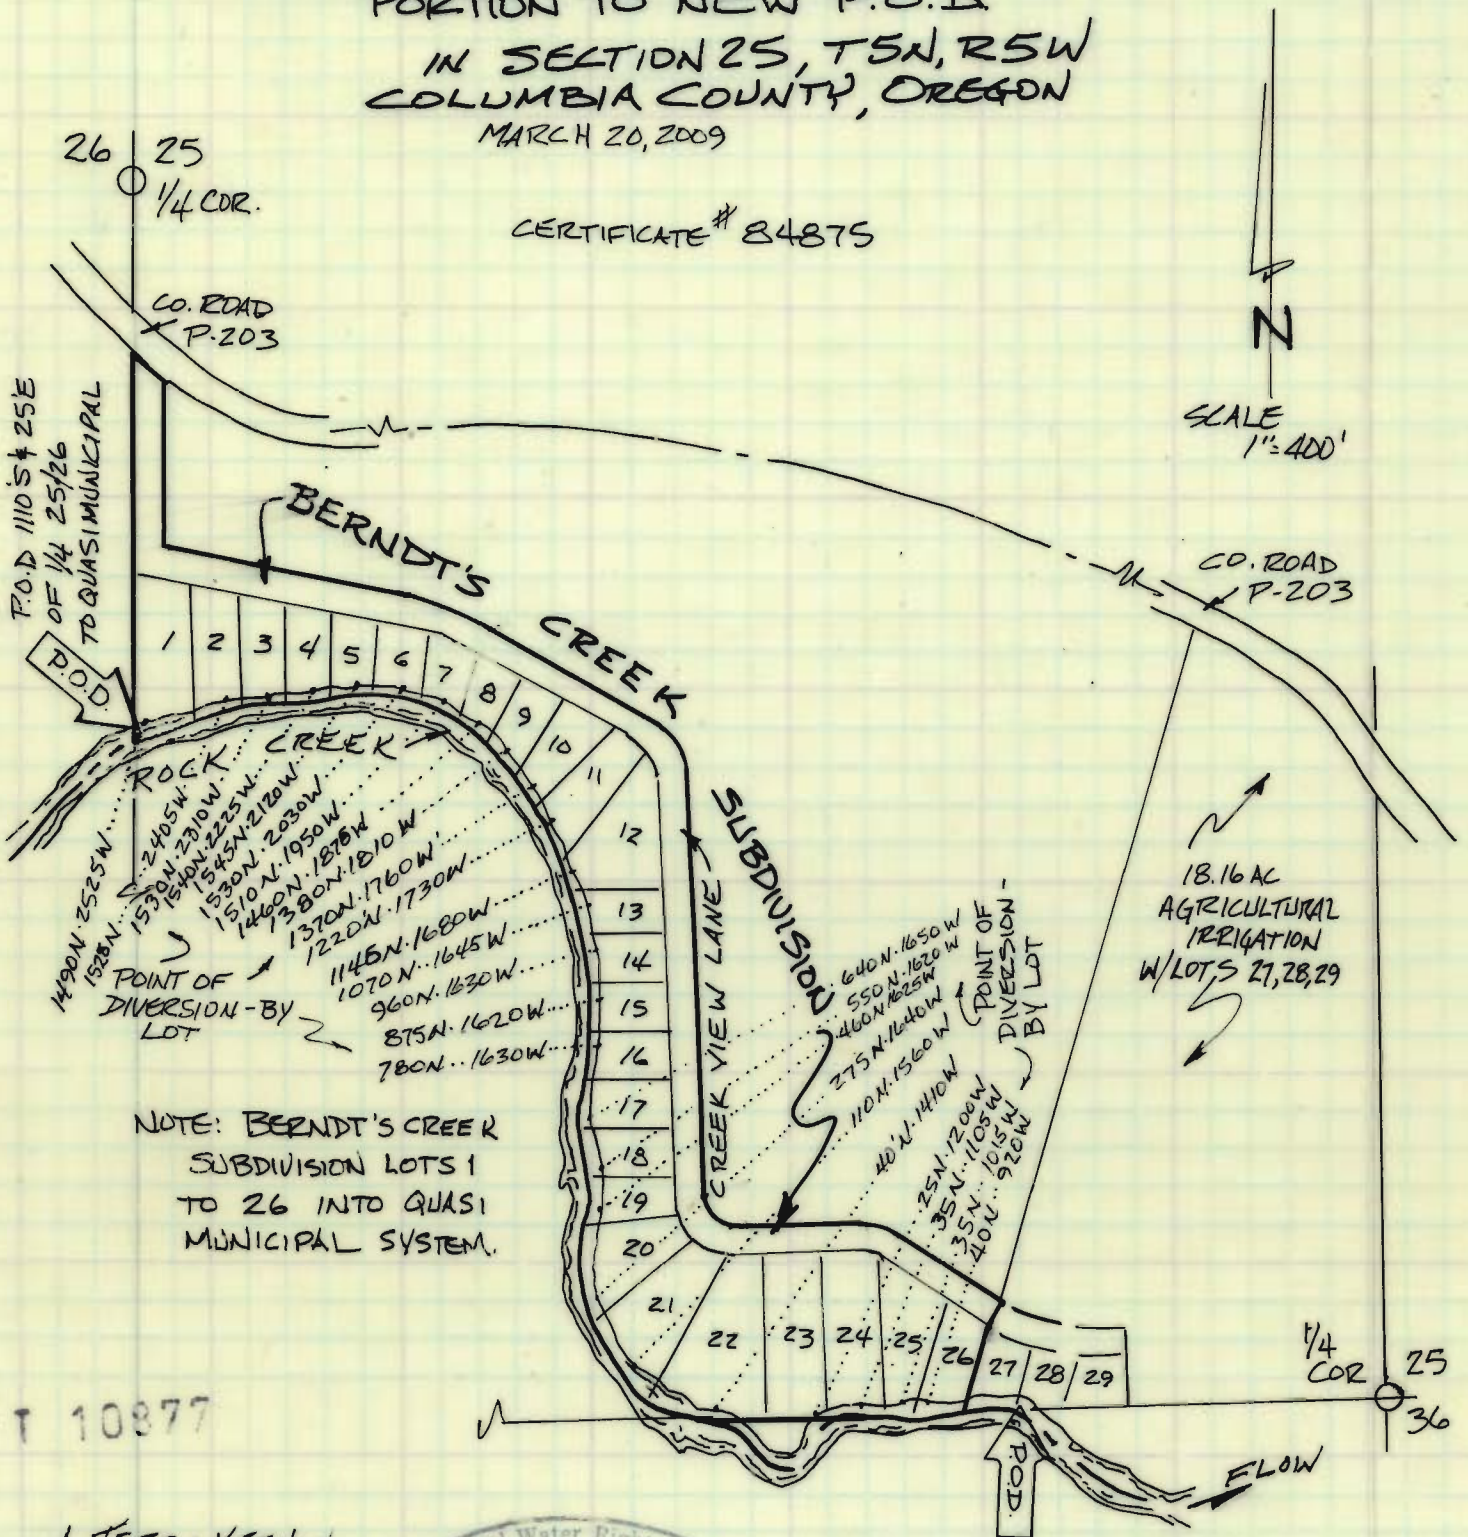

NOTE: BERNDT'S CREEK
SUBDIVISION LOTS 1
TO 26 INTO QUASI
MUNICIPAL SYSTEM.

L JERRY KEENON
16721 NOAKES
VERNONIA, ORE
97064



TRANSFER P.O.D.
760 ft W & 60 ft N
of S 1/4 Sec. 25