

STATE ENGINEER  
Salem, Oregon

T 10081

Well Record **LANE**  
GR- 1169


STATE WELL NO. 17/~~44~~-1F(2)  
COUNTY Lane  
APPLICATION NO. GR- 1209

OWNER: A. J. McManus MAILING ADDRESS: 991 River Loop #2

LOCATION OF WELL: Owner's No. CITY AND STATE: Eugene, Oregon

SE  $\frac{1}{4}$  NW  $\frac{1}{4}$  Sec. 1 T. 17 S., R. 4 W., W.M.

Bearing and distance from section or subdivision corner 9.5 ch. N. & 28 ch. E. from W. cor. Sec. 1.

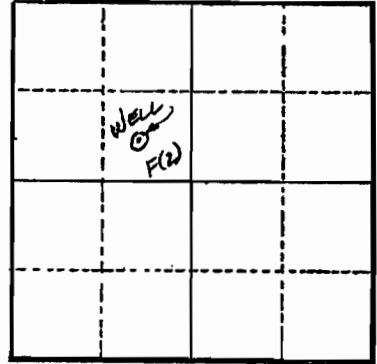

Altitude at well 375 ft.

TYPE OF WELL: Driven Date Constructed 1952

Depth drilled 21 ft. Depth cased 20 ft.

Section 1

CASING RECORD:

4 in. from 0 to 20 ft.

FINISH:

Perforated with  $\frac{1}{2}$  in. holes (3 x 3 in.) from 17 to 20 ft.

AQUIFERS:

WATER LEVEL:

8 ft.

PUMPING EQUIPMENT: Type A. C. 3 x 4 in. H.P. 15  
Capacity \_\_\_\_\_ G.P.M.

WELL TESTS:

Drawdown \_\_\_\_\_ ft. after \_\_\_\_\_ hours \_\_\_\_\_ G.P.M.

Drawdown \_\_\_\_\_ ft. after \_\_\_\_\_ hours \_\_\_\_\_ G.P.M.

USE OF WATER Irrigation Temp. \_\_\_\_\_ °F. \_\_\_\_\_, 19\_\_\_\_

SOURCE OF INFORMATION G. R. Record

DRILLER or DIGGER D. D. Dickenson

ADDITIONAL DATA:

Log N.A. Water Level Measurements \_\_\_\_\_ Chemical Analysis \_\_\_\_\_ Aquifer Test \_\_\_\_\_

REMARKS:

Irrigation of 18 acres.

**RECEIVED**

MAY 15 2009

WATER RESOURCES DEPT  
SALEM, OREGON