


PREPARED FOR
POSE ONLY

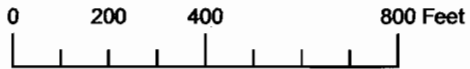


SECTION 29 T02N R10E WM HOOD RIVER COUNTY

1" = 400'

02N 10E 2

CANCELLED NOS.
102
300
400

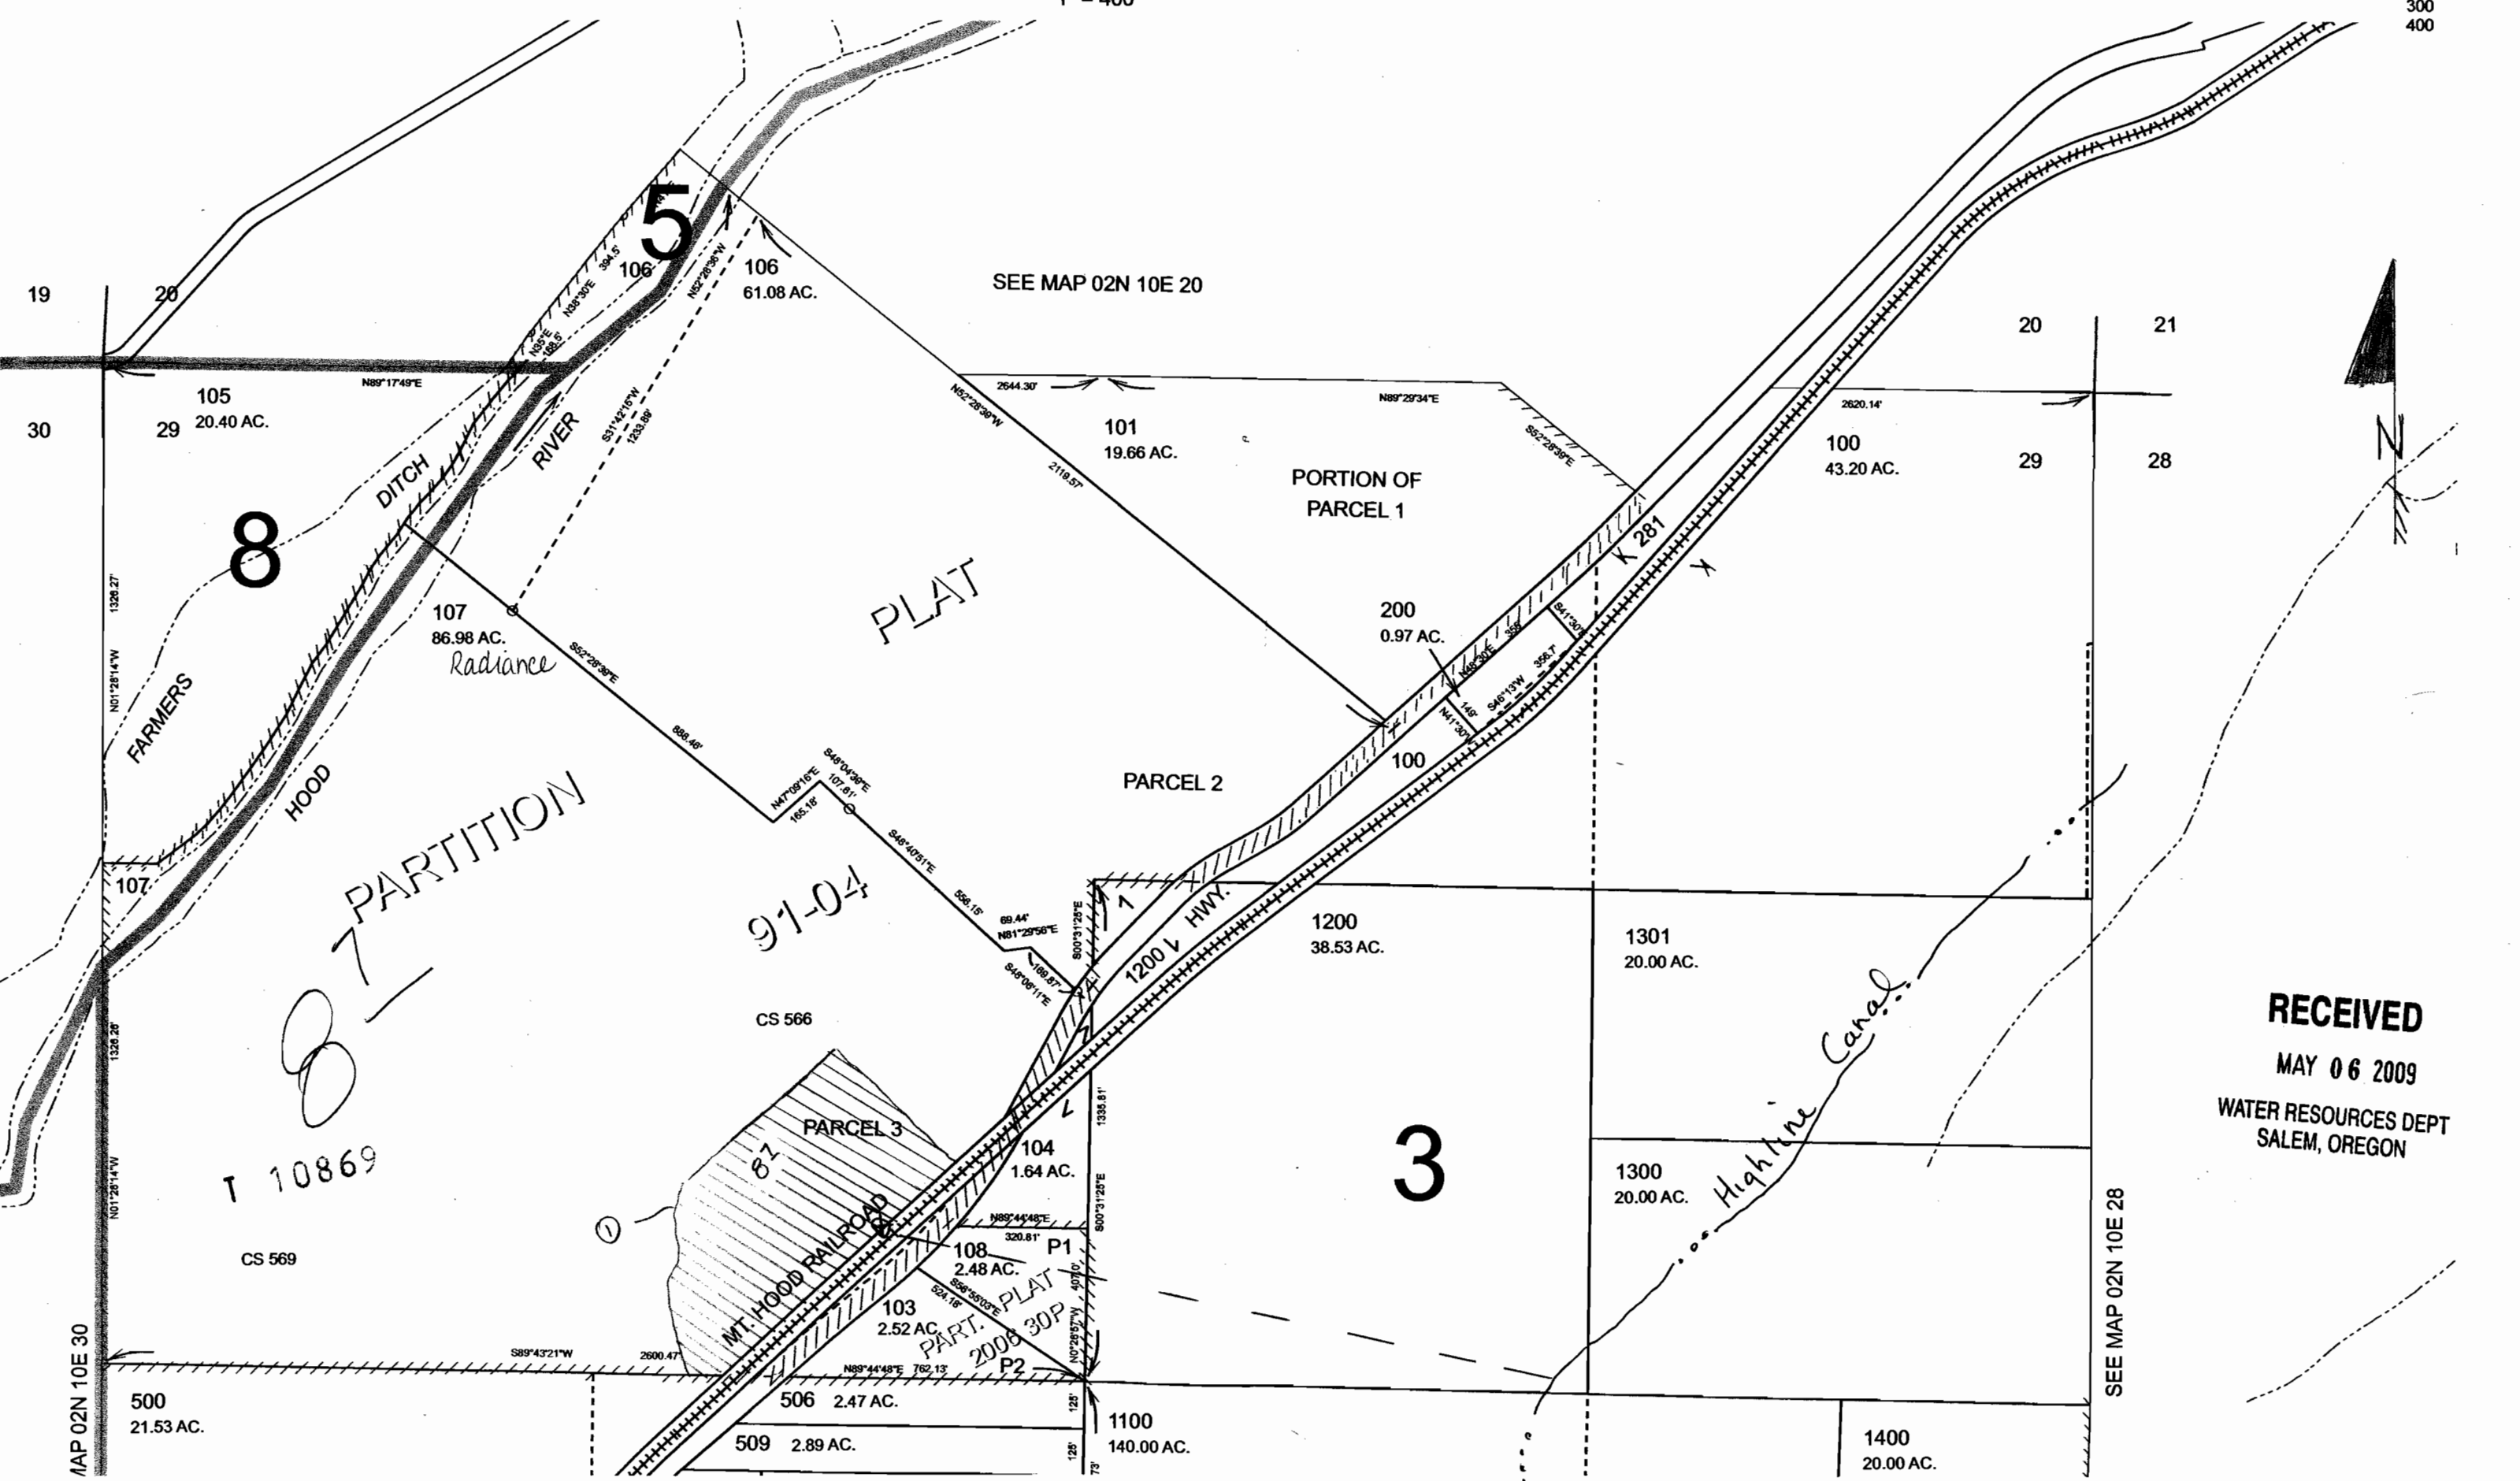

RECEIVED
MAY 06 2009
WATER RESOURCES DEPT
SALEM, OREGON

SEE MAP 02N 10E 28

MAP 02N 10E 30

SEE MAP 02N 10E 20

PLAT

PARCEL 2

PORTION OF
PARCEL 1

87 PARTITION

91-04

T 10869

RADIANCE

Highline Canal


MT. HOOD RAILROAD

2008 30P

3

8

5

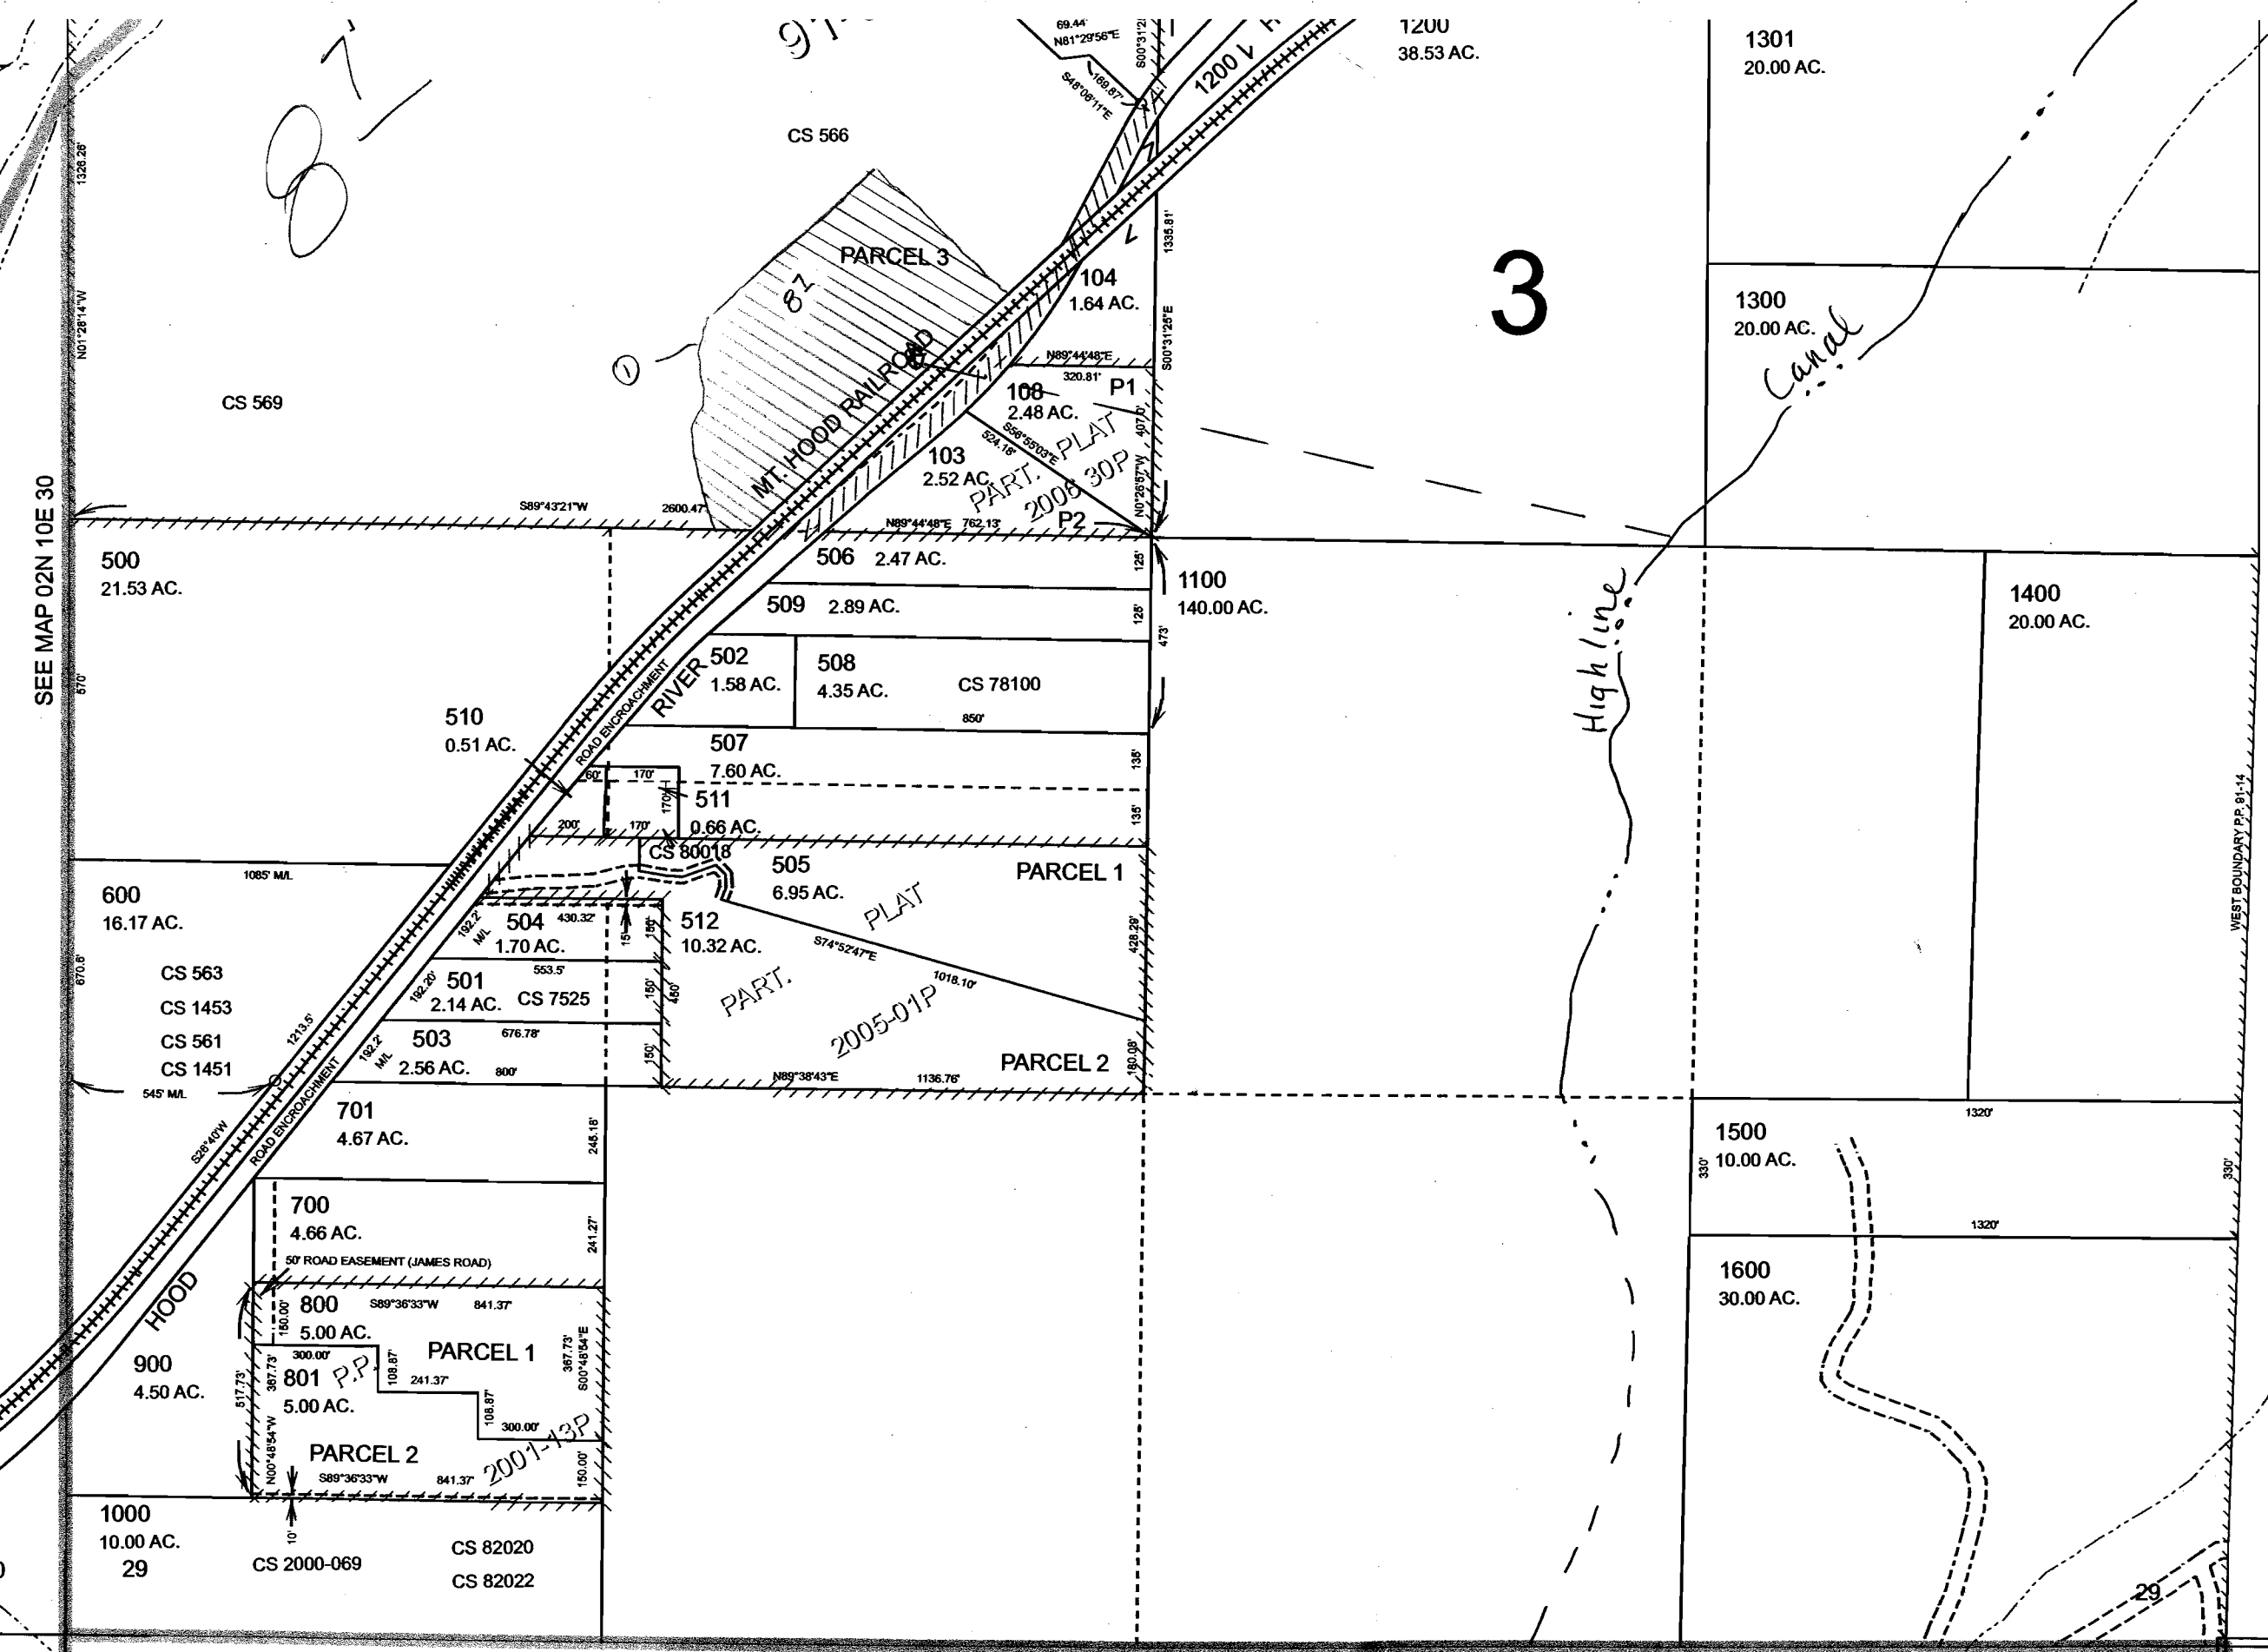

SEE MAP 02N 10E 30

SEE MAP 02N 10E 28

SEE MAP 02N 10E 32

Map Legend	
Map Symbols	
	Valve
	Pipeline
	Property Line
Water Right Certificate	
	C-81340
	Transfer To
	Transfer From
East Fork Irrigation District Hood River, Oregon	
Section 2N-10E-29	
Scale 1" = 400' cms	
0 200 400	

RECEIVED
MAY 06 2009
WATER RESOURCES DEPT
SALEM, OREGON

Revised CMS
4/27/2007

T 10869

Transfer From
C 81340 87 ac

02N 10E 29

SECTION 01 T.01N. R.10E. W.M.
HOOD RIVER COUNTY

1"=400'

01N 10E 01

- CANCELLED NO.
101
401
1200
2200
2501

HIS MAP WAS PREPARED FOR
ASSESSMENT PURPOSE ONLY

SEE MAP 02N 10E 36




RECEIVED
MAY 06 2009
WATER RESOURCES DEPT
SALEM, OREGON


8

3

1200

Map Legend

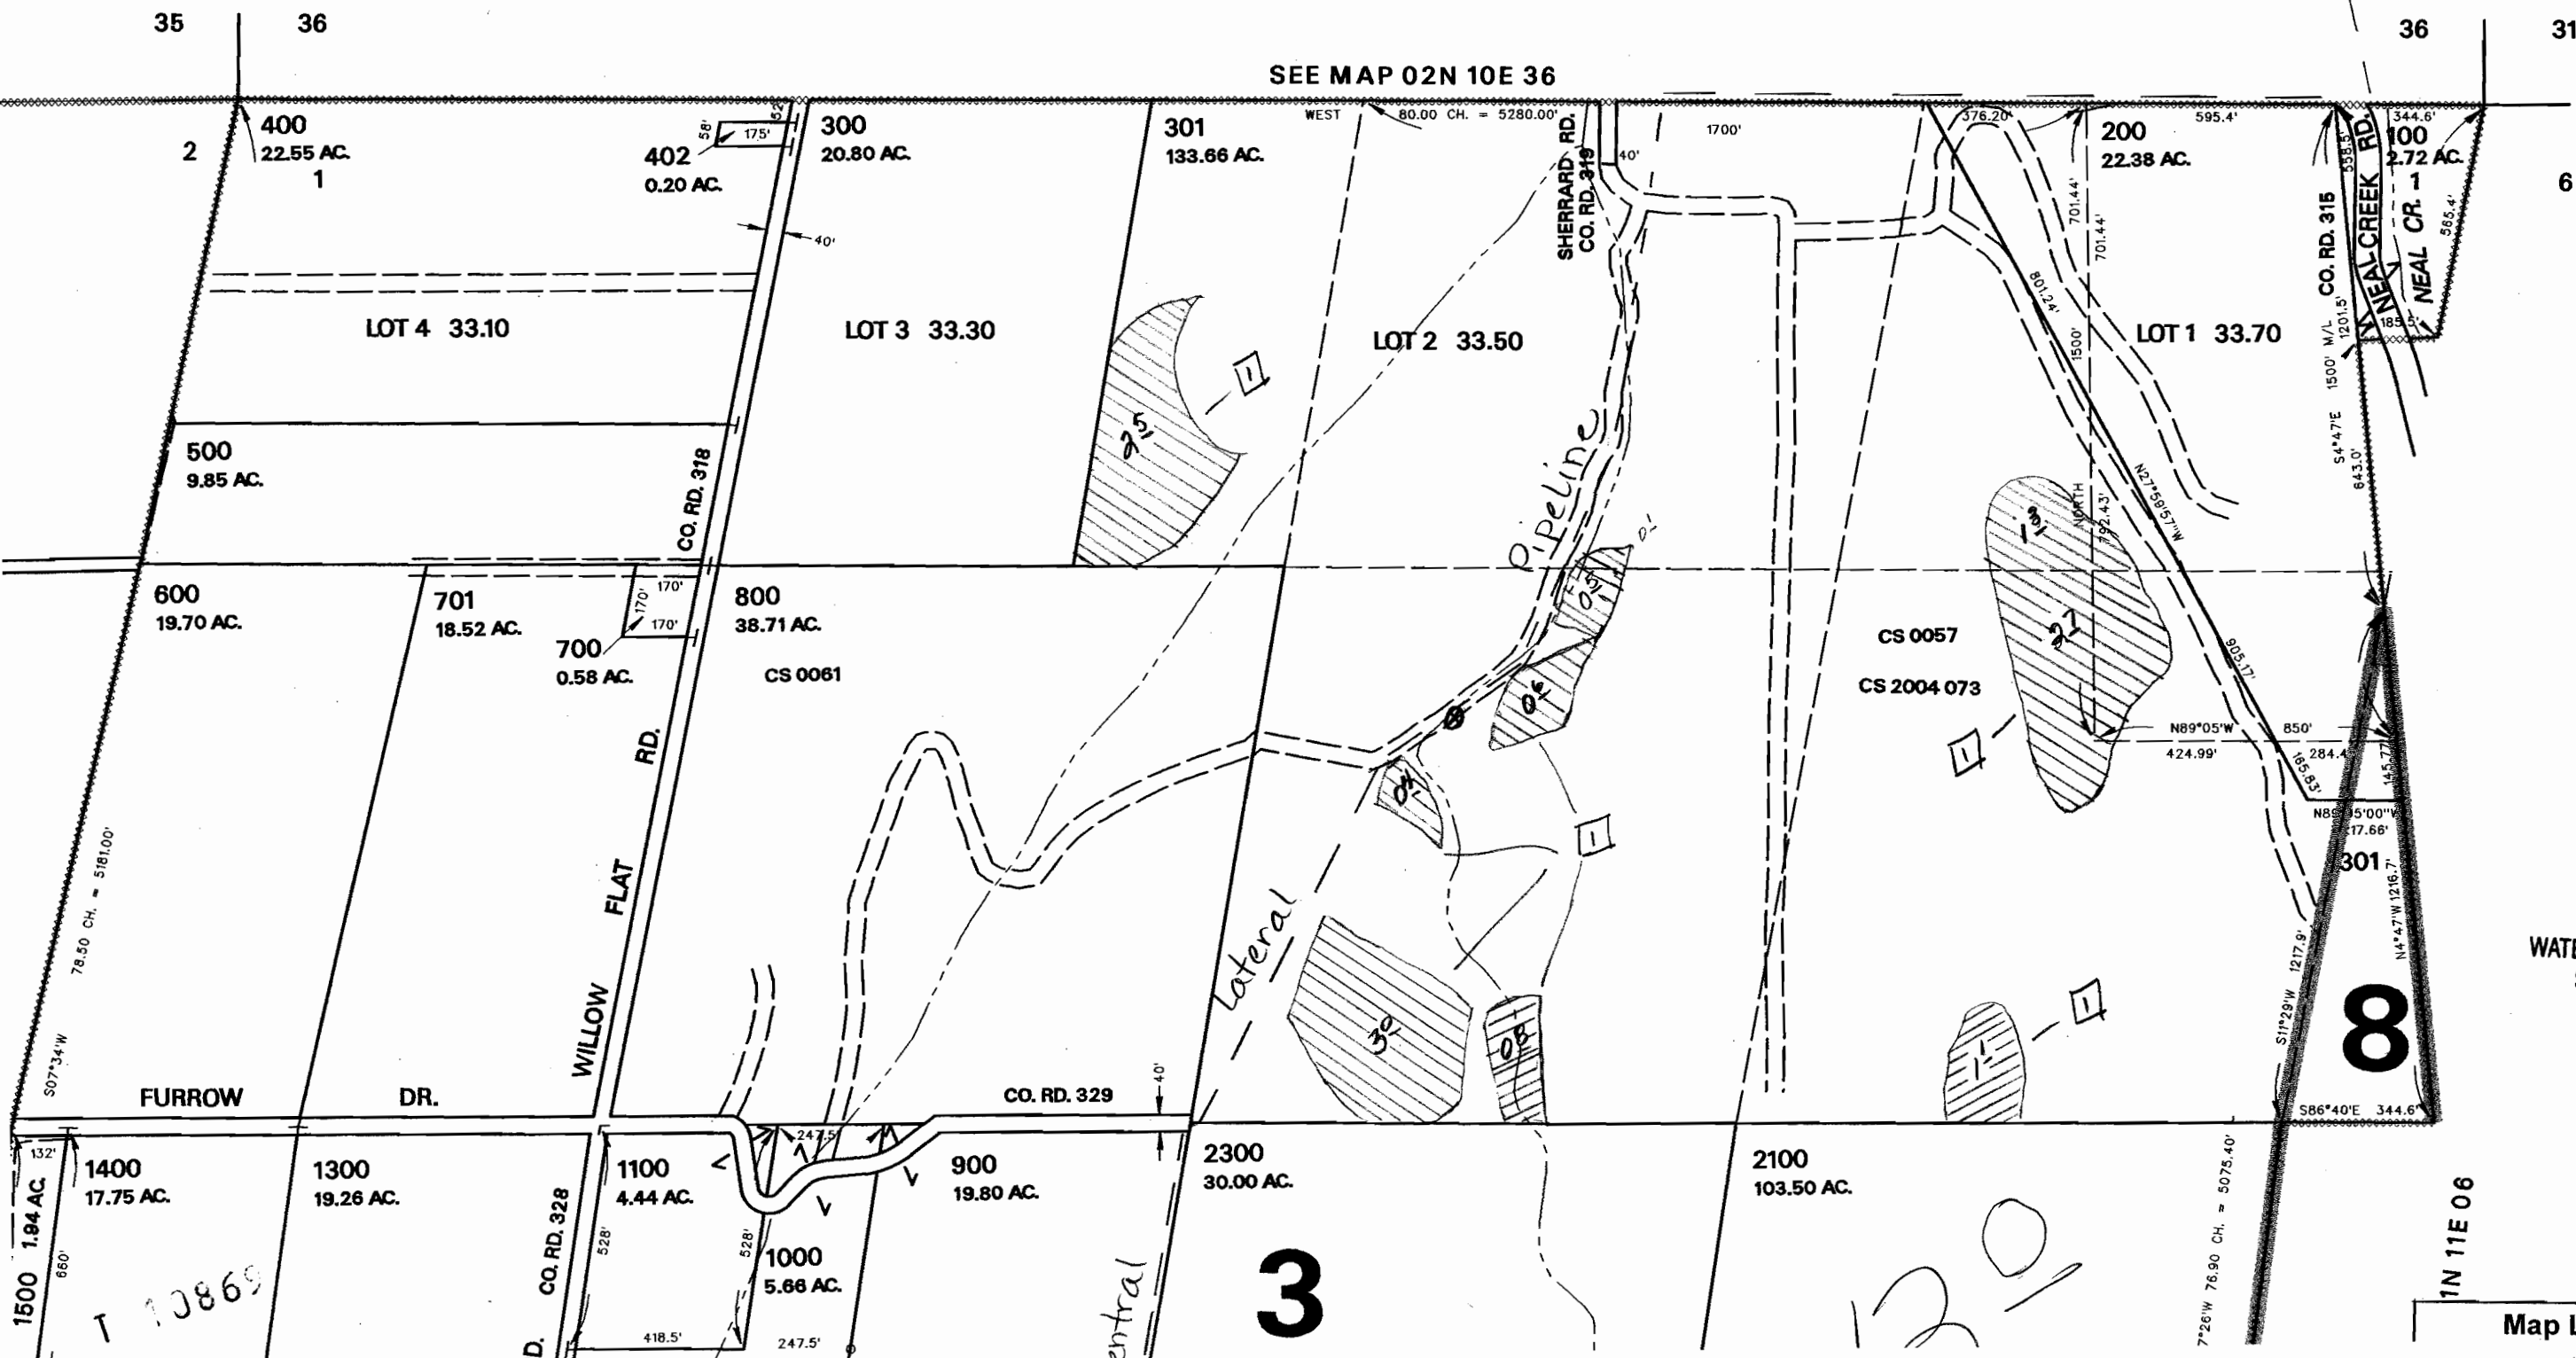

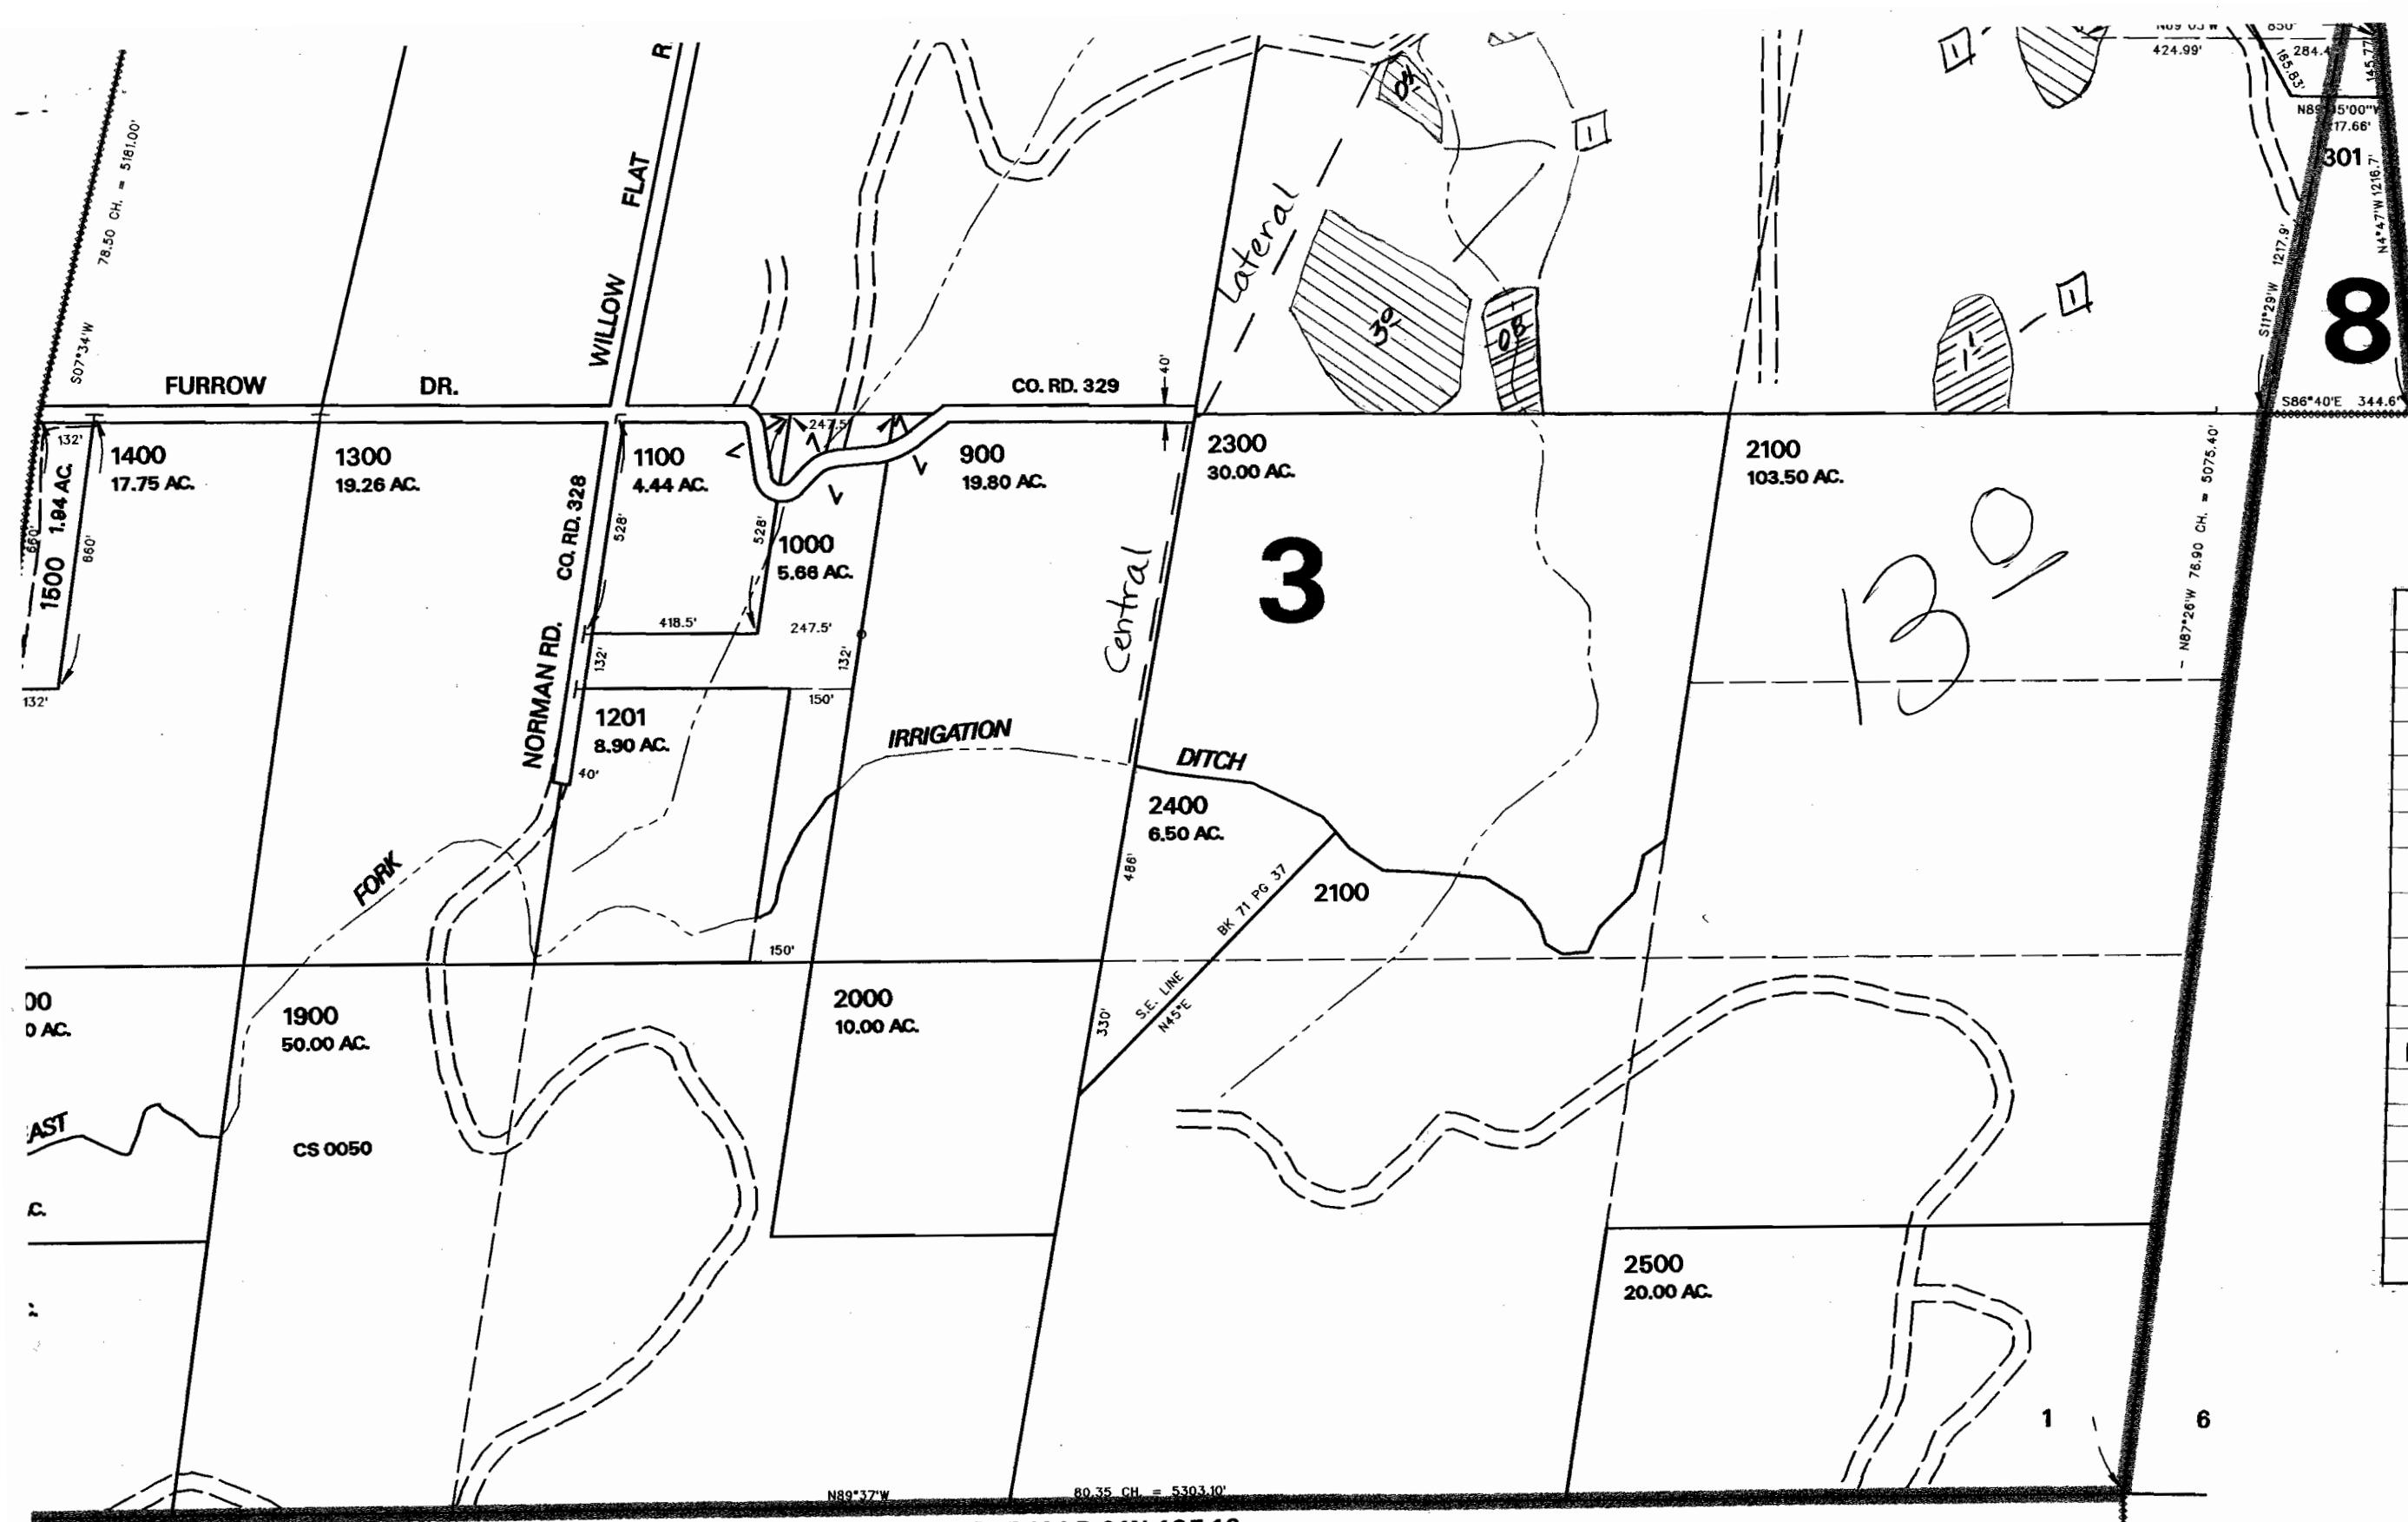

Map Legend	
Map Symbols	
	Valve
	Pipeline
	Property Line
Water Right Certificate	
	C-81340
	C-80929
	Transfer To
	Transfer From
East Fork Irrigation District Hood River, Oregon	
Section 1N-10E-01	
Scale 1" = 400' cms	
0 200 400	

RECEIVED

MAY 06 2009

WATER RESOURCES DEPT
SALEM, OREGON

REVISED: CS
06/15/05

01N 10E 01

SEE MAP 01N 10E 12

Transfer To
C. 81340 11 1/2 ac.
C. 80929 19 ac.


T 10863

RECEIVED

MAY 06 2009

WATER RESOURCES DEPT
SALEM, OREGON

SEE MAP 01N 10E 01

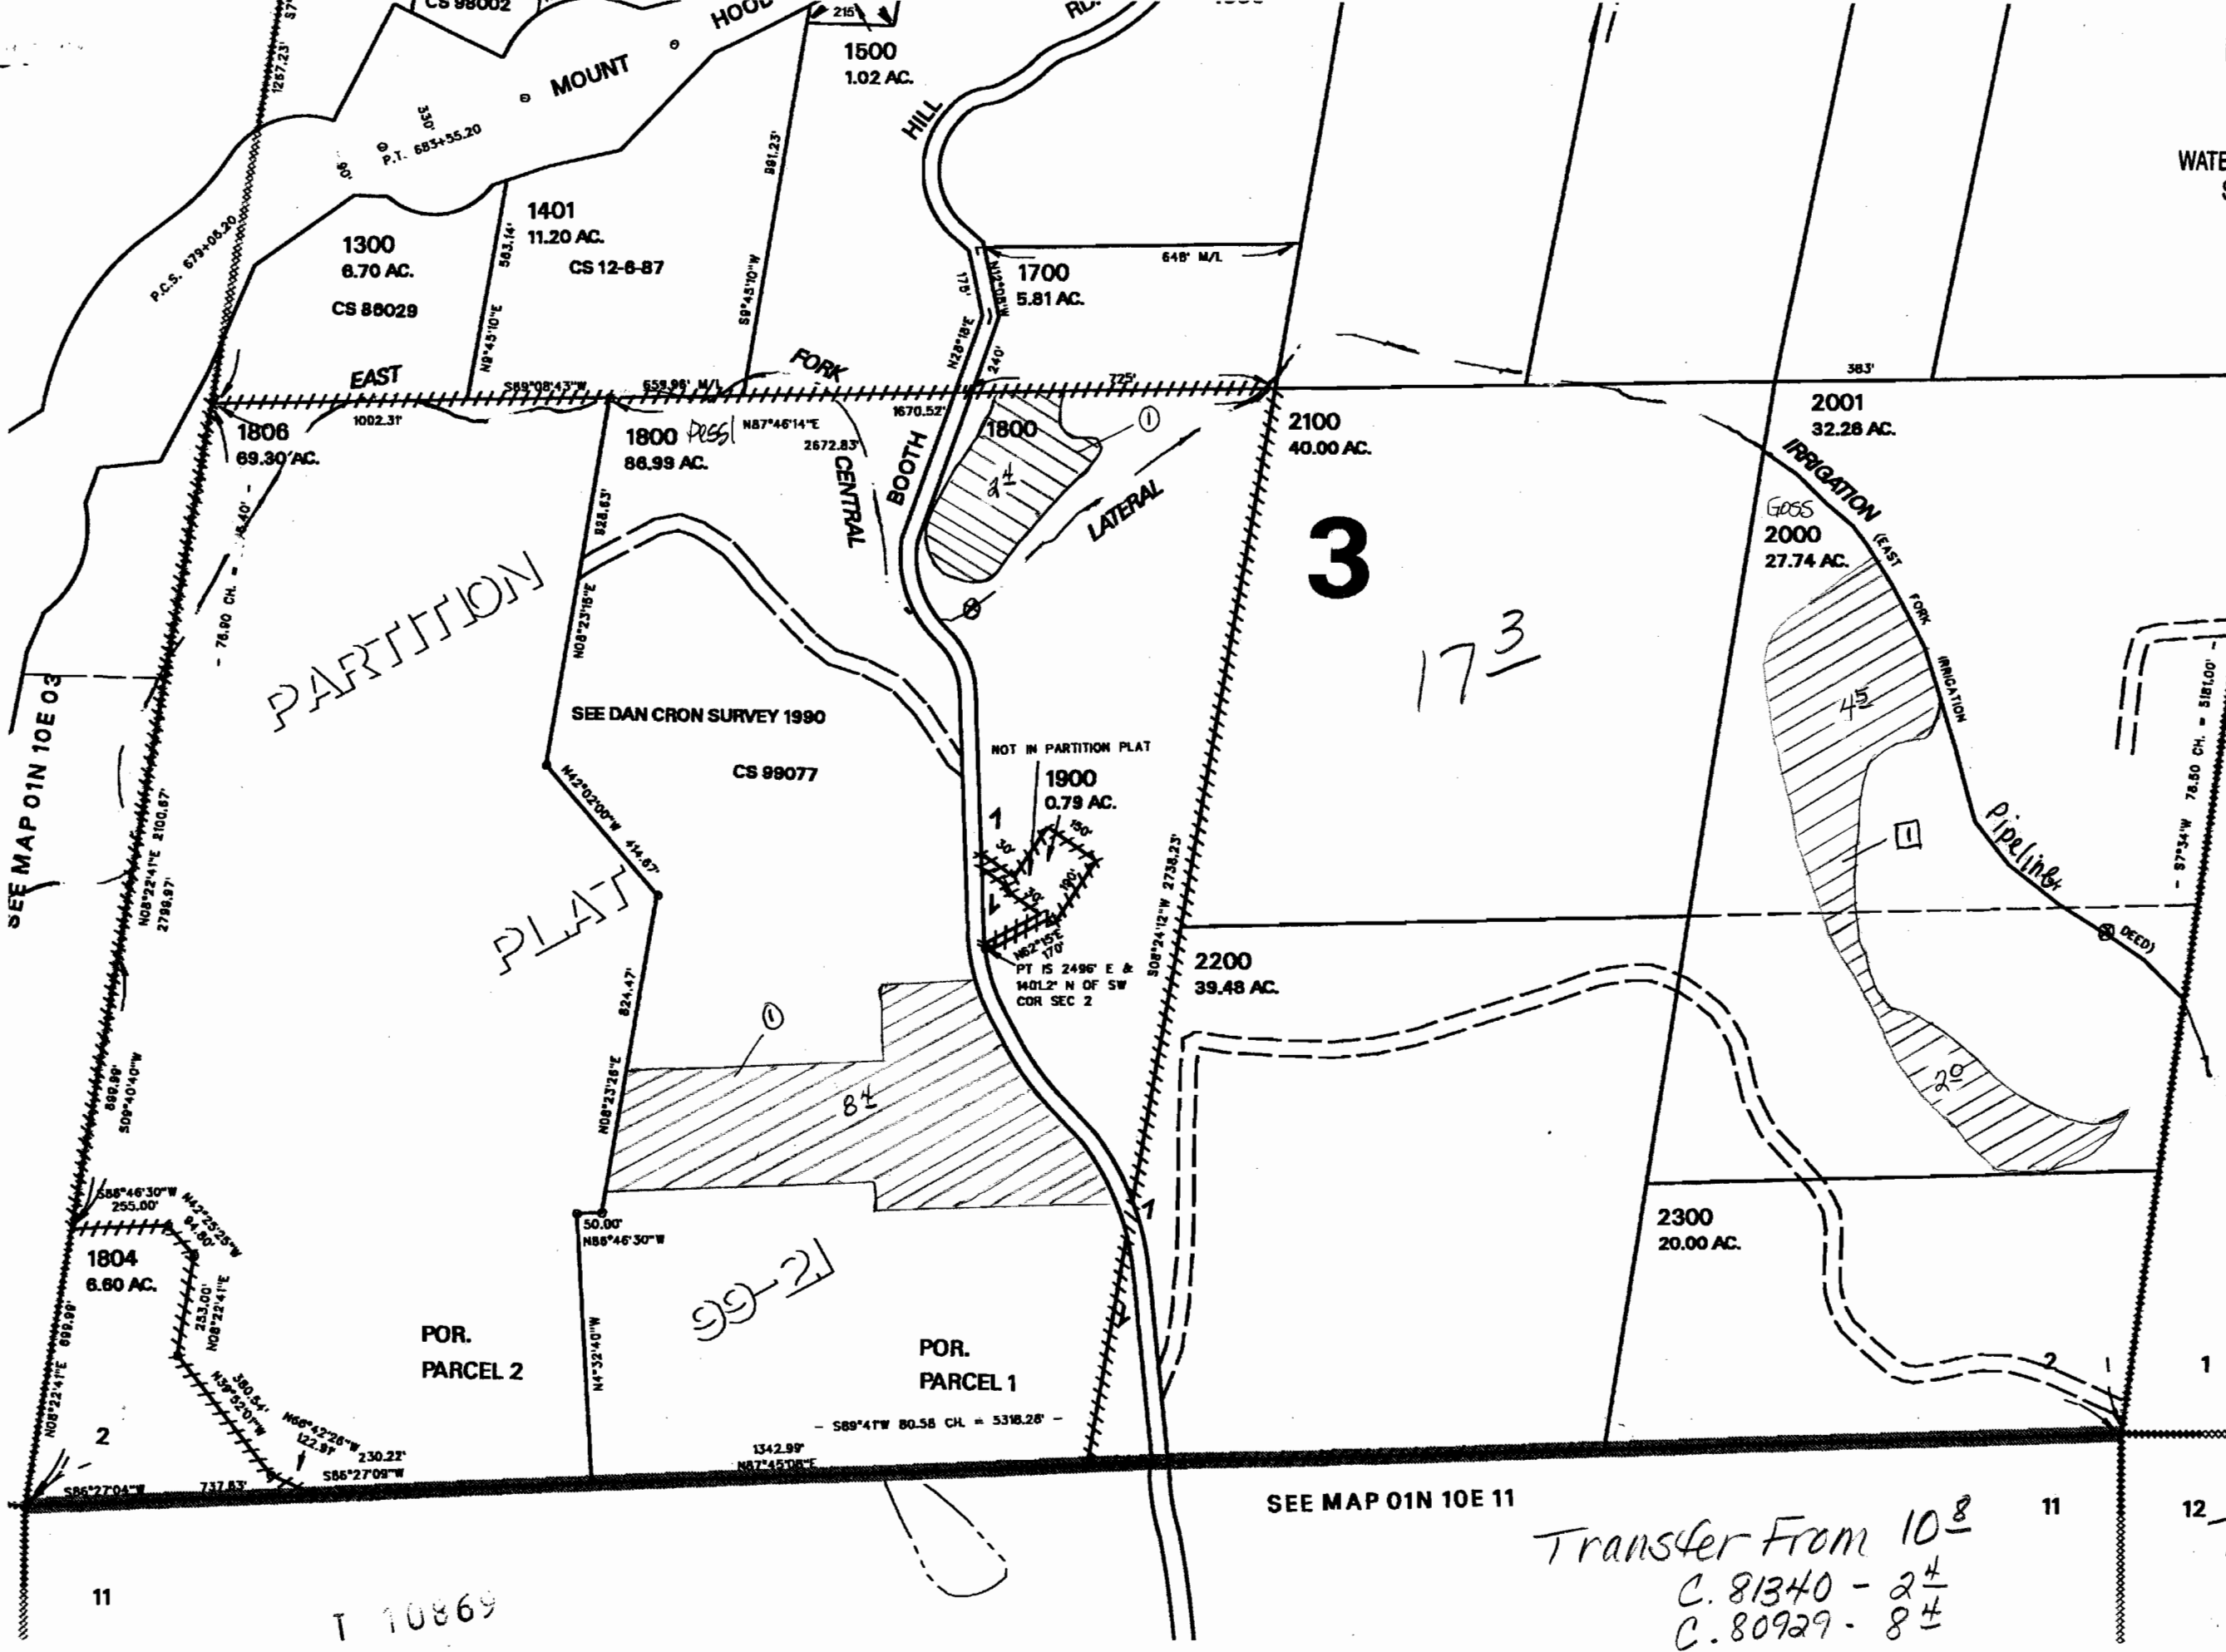

SEE MAP 01N 10E 03

PARTITION

PLAT

3

173

POR. PARCEL 2

POR. PARCEL 1

SEE MAP 01N 10E 11

Map Legend	
Map Symbols	
	Valve
	Pipeline
	Property Line
Water Right Certificate	
	C-81340
	C-80929
	Transfer To
	Transfer From
East Fork Irrigation District Hood River, Oregon	
Section 1N-10E-02	
Scale 1" = 400' cms	

Transfer From 10⁸
C. 81340 - 2⁴/₅
C. 80929 - 8⁴/₅

12 Transfer To 6⁵
C. 80929 - 6⁵

T 10869

01N

THIS MAP WAS PREPARED FOR
ASSESSMENT PURPOSE ONLY

SECTION 02 T.01N. R.10E. W.M. HOOD RIVER COUNTY

1"=400'

01N 10E 02

CANCELLED NO.
1402
1801
1802
1803
1805
1901

