


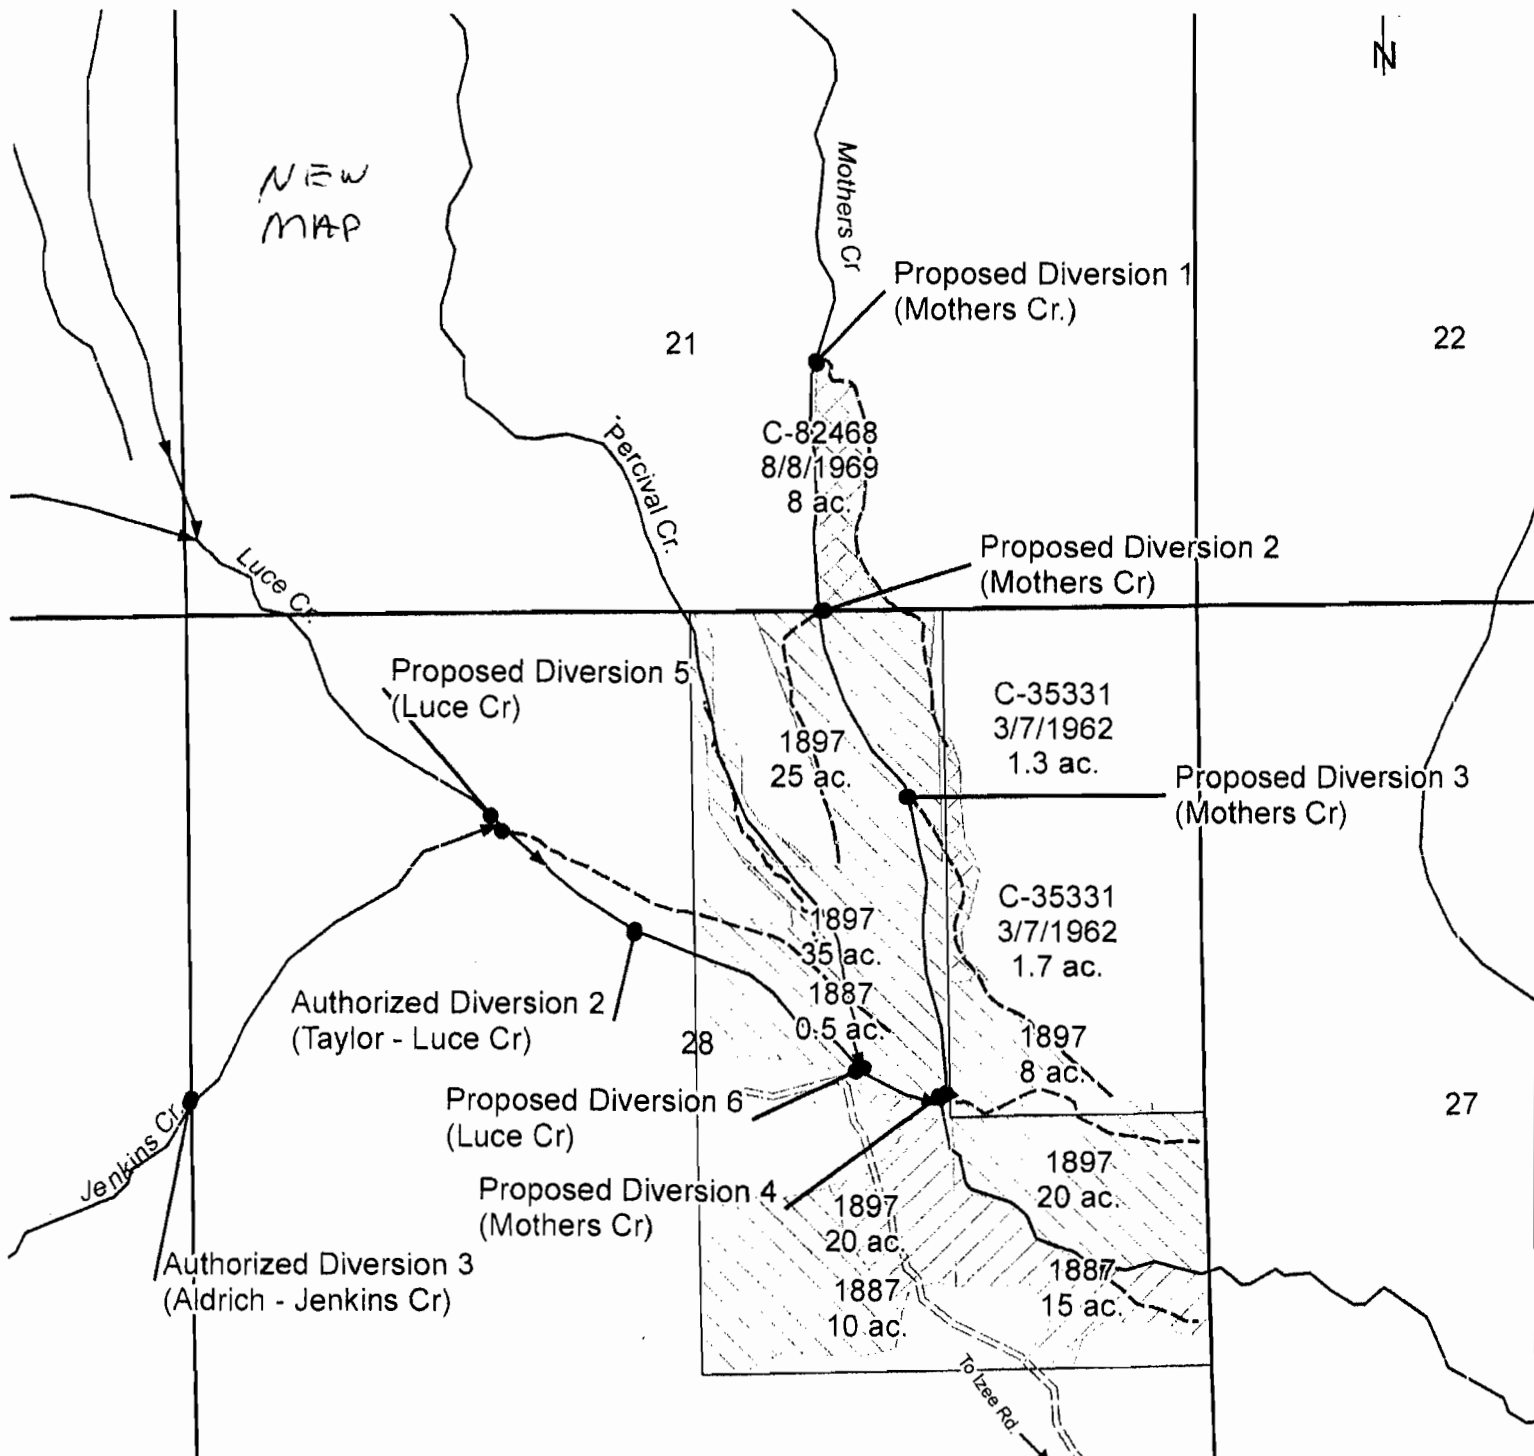

Authorized PODs

- #1 - 3320' E & 1320' N from the SW corner, Sec. 21
- #2 - 1660' S & 2285' E from the SW corner, Sec. 21
- #3 - 2520' S & 10' W from the SW corner, Sec. 21

Proposed PODs

- #1 - 1290' N & 3280' E from the SW corner, Sec. 21
- #2 - 15' N & 3265' E from the SW corner, Sec. 21
- #3 - 977' S & 3690' E from the SW corner, Sec. 21
- #4 - 2545' S & 3870' E from the SW corner, Sec. 21
- #5 - 1106' S & 2710' E from the SW corner, Sec. 21
- #6 - 2397' S & 3394' E from the SW corner, Sec. 21

RECEIVED

JUN 01 2009

WATER RESOURCES DEPT
SALEM, OREGON

Legend

- Luce and Mothers Cr.
- Jenkins, Luce, and Mothers Cr. (may not need transfer)
- Mothers Cr.

C:\Dist_10\Bear_Valley\Mother.mxd (revised 4/21/09) jds.

T 10392

Name and Postoffice Address of Appropriator	Date of Relative Priority	Amount Cubic Feet Per Second	Number Acres	Use	Name of Ditch	Stream	Description of Land or Place of Use
Aldrich, Dessie E. Canyon City, Ore. (Estate of Elgy Frank Aldrich)	1897	1.77	106	Irrigation	Jenkins Taylor Luce Lower & Lemons	Jenkins & Luce & Lemon Creeks	25 acres in NW-NE- 35 acres in SW-NE- 8 acres in SE-NE- 20 acres in NE-SE- 20 acres in NW-SE- Section 28, T. 15 S.R. 30 E.W.M.
	1887	.43	25.5	Irrigation	Aldrich	Luce & Lemmon	.5 acres in SW-NE- 15 acres in NE-SE- 10 acres in NW-SE- Section 28, T. 15 S.R. 30 E.W.M.
Ansmus, C. B. <i>Modified by Supreme Court. Vol. 10, Page 215</i>	1896	.89	70.1	Irrigation	Ansmus & Ritter Bush Slough	Main	27 acres in NE-SE- (Lot 6) 3.91 acres in NW-SE- (Lot 7) 40 acres in SE-SE- Section 24, T. 25 S.R. 32 E.W.M.
Baker, E. D.	1889	5.14	410.81	Irrigation	No name	Sage Hen Creek & West Fork Silvies River	40 acres in NE-NE- 40 acres in NW-NE- 35 acres in SW-NE- 40 acres in SE-NE- 40 acres in NE-NW- 40 acres in NW-NW- 22 acres in SW-NW- 25 acres in SE-NW- 40 acres in NE-SE- 10 acres in NW-SE- Section 19, 24 T. 24 S.R. 31 E.W.M.
Baker, J. T. Burns, Oregon.	1892	2.00	160	Irrigation	Dams, ditches & over- flow	Foley Slough	40 acres in NE-NW- 40 acres in SE-NW- 40 acres in SW-NW- 40 acres in NW-NW-
	1898	2.00	160	Irrigation	Dams, ditches & over- flow	Foley slough	40 acres in NE-SW- 40 acres in SE-SW- 40 acres in SW-SW- 40 acres in NW-SW- Section 10, T. 23 S.R. 31 E.W.M.
	1884	4.00	320	Irrigation	Dams, ditches overflow	Poison Creek	40 acres in SW-NE- 40 acres in NW-NE- 40 acres in NE-NW- 40 acres in SE-NW- 40 acres in SW-NW- 40 acres in NW-NW- 40 acres in NE-SW- 40 acres in NW-SW-
	1908	2.00	160	Irrigation	Dams ditches overflow	Poison Creek	40 acres in NE-NE- 40 acres in SE-NE- 40 acres in NE-SE- 40 acres in SE-SE- Section 34, T. 22 S.R. 31 E.W.M.


T 10392

RECEIVED

JUN 01 2009

WATER RESOURCES DEPT 138
SALEM, OREGON

SILVIES RIVER - 60.

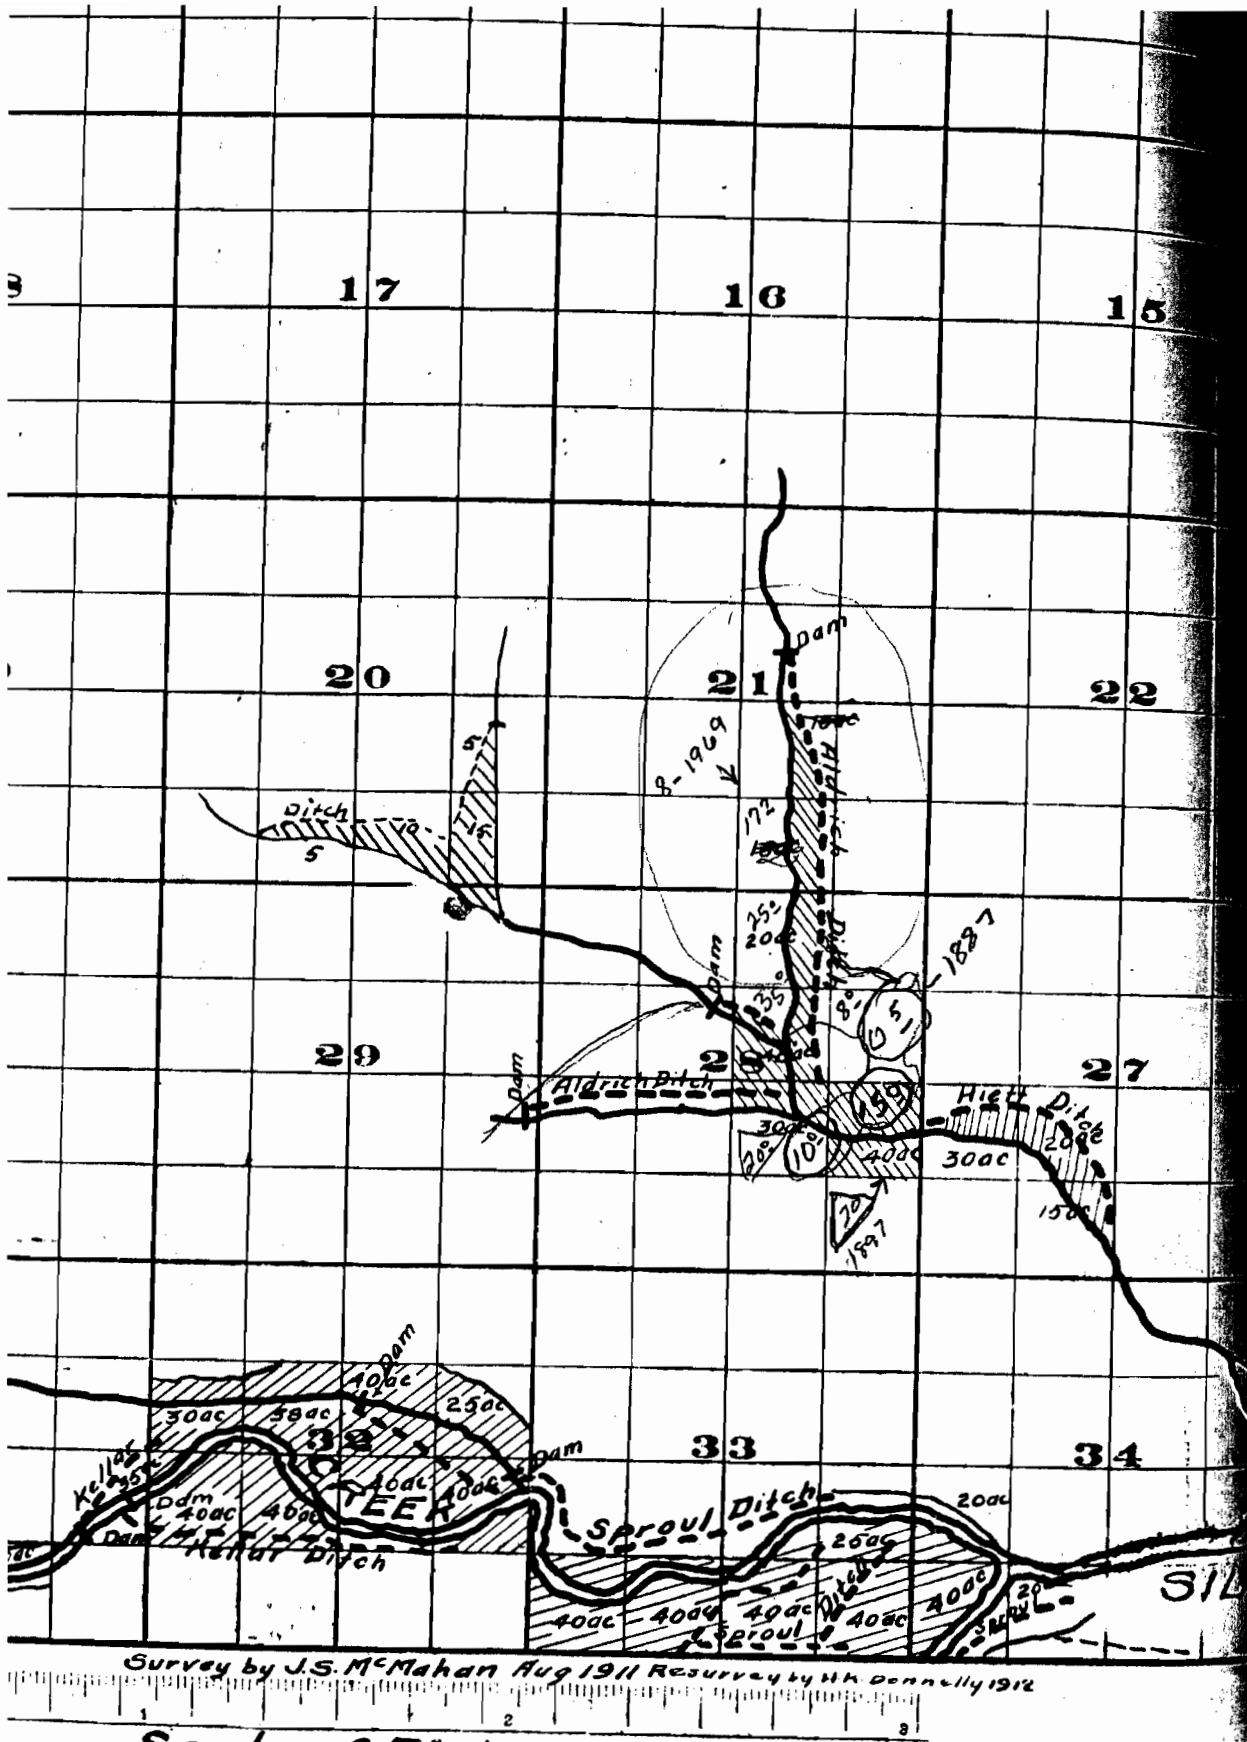

END

T 10992

RECEIVED

JUN 01 2009

WATER RESOURCES DEPT
SALEM, OREGON

ated Land with Area

hes