



From

T.9S., R.3W., W.M.

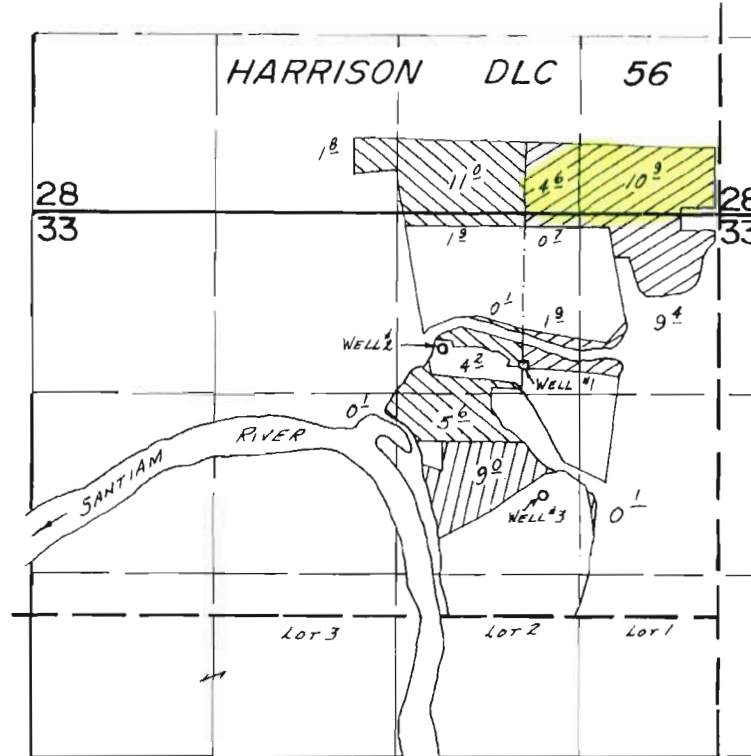

SCALE: 1" = 1320'

WELLS LOC.: #1-1850' N. & 1400' W., #2-1970' N. & 2000' W., #3-880' N. & 1270' W. ALL FROM SE. COR. HARRISON DLC 56.

-  Well No. 1
-  Well No. 2
-  Well No. 3

FINAL PROOF SURVEY UNDER

Application No. G-7787, Permit No. G-7238....
IN NAME OF

.....ELMER L. COOK.....

Surveyed Apr. 23... 19.80, by C.L. HUGHES.....

T 10205

14-65 NE 1/4 & ZTS

3-28-85
BWB