

RECEIVED
 JUN 29 2009
 WATER RESOURCES DEPT
 SALEM, OREGON

Pleasant View Canal

COUNTY ROAD

8TH AVENUE

WINESAP ROAD

T6N
T5N

R34 R35
3 2

101 100

200

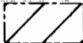
300

15.0

○ **Points of Appropriation**

WELL 1: Authorized POA for Claim GR-3856. Dug and drilled well. Actual location is 1,285 feet S and 1,337 feet E from NW Corner of Section 2. Location indicated on GR-3856 is 1,305 feet S and 1,300 feet E from NW Corner of Section 2. Well Logs UMAT 3937 and UMAT 3931. Apparently draws water from basalt aquifer.

● WELL 2: Proposed (additional) POA is a new drilled well to be located 1,249 feet S and 1,295 feet E from NW Corner of Section 2. No well log (not yet drilled). Proposed 8-inch well diameter, and 250-foot depth, cased and sealed into basalt aquifer.

 **Place of Use**
 15.0 acres in NW/4 NW/4, S2, T5N, R35E, WM (TL 300).
 No changes proposed for place of use.

T 10920

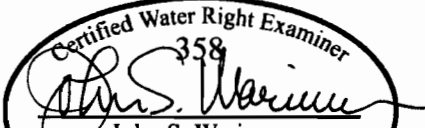
T5N, R35E, Section 2, WM
 Umatilla County

N
 W — E
 S

1 inch = 400 feet

The purpose of this map is to identify the location of a water right. It is not intended to provide information regarding the location of property ownership boundary lines.

FOUNTAINHEAD
 1204 Alvarado Terrace
 Walla Walla, WA 99362
 (509) 529-2646 phone

Certified Water Right Examiner
 358

 John S. Warinner
 May 18, 1993
 STATE OF OREGON

GR CLAIM MODIFICATION
Claim GR-3856
 in the name of
ROBERT BAKER
 Revised 24 NOV 2008