

STATE ENGINEER
Salem, Oregon

UMAT
3937

Well Record

STATE WELL NO. 5N/35-2D
COUNTY Umatilla
APPLICATION NO. OR-3856

OWNER: Gust Seibold MAILING ADDRESS: Route 2, Box 570
CITY AND STATE: Milton-Freewater, Oregon

LOCATION OF WELL: Owner's No. _____
NW ¼ NW ¼ Sec. 2 T. 5 N. E. R. 35 W., W.M.
Bearing and distance from section or subdivision
corner 1300' E. & 1305' S. of NW cor. Sec. 2

Altitude at well _____
TYPE OF WELL: ^{Dug} Drilled Date Constructed 1918
Depth drilled 344 ft. Depth cased 61 ft.

Section 2

CASING RECORD:

8 inch standard pipe casing set from 12 to 61 feet

FINISH:

AQUIFERS:

WATER LEVEL:

95 feet below surface

PUMPING EQUIPMENT: Type Fairbanks Morse H.P. 10
Capacity 400 G.P.M.

WELL TESTS:

Drawdown _____ ft. after _____ hours _____ G.P.M.
Drawdown _____ ft. after _____ hours _____ G.P.M.

USE OF WATER Irrigation Temp. _____ °F. _____ 19
SOURCE OF INFORMATION Well Registration Statement - Cert. # GR-3512

DRILLER or DIGGER

ADDITIONAL DATA:

Log X Water Level Measurements _____ Chemical Analysis _____ Aquifer Test _____

REMARKS:

RECEIVED

JUN 29 2009

WATER RESOURCES DEPT
SALEM, OREGON

T 10920

STATE ENGINEER
Salem, Oregon

State Well No. 5N/35-2D
County Umatilla
Application No. GR-3856

Well Log

Owner: Gust. Seibold Owner's No. _____

Driller: _____ Date Drilled 1918

CHARACTER OF MATERIAL	(Feet below land surface)		Thickness (feet)
	From	To	
Old dug well pit	0	25	25
Drilled previously	25	28	3
Coarse loose gravel	28	55	27
Gravel	55	95	40
Black basalt rock	95	105	10
Brown porous rock	105	147	42
Brown rock	147	150	3
Black basalt	150	189	39
Crevice @ 189'			
Black basalt	189 —	218	29
Hard black basalt	218	253	35
Porous basalt	253	292	39
Firm basalt	292	304	12
Black basalt	304	308	4
Red basalt, firm	308	331	23
Hard black basalt	331	337	6
Very hard black basalt	337	344	7

First deepening

Second deepening

RECEIVED

JUN 29 2009

WATER RESOURCES DEPT
SALEM, OREGON

STATE ENGINEER
Salem, Oregon

UMAT
3931

Well Record

STATE WELL NO. 5N/35-2D(1)
COUNTY Umatilla
APPLICATION NO. GR-3856

OWNER: Gust Seibold

MAILING ADDRESS:


LOCATION OF WELL: Owner's No. _____

CITY AND STATE:

Milton-Freewater, Oregon

NW 1/4 NW 1/4 Sec. 2 T. 5 N. 35 E. W.M.

Bearing and distance from section or subdivision corner _____

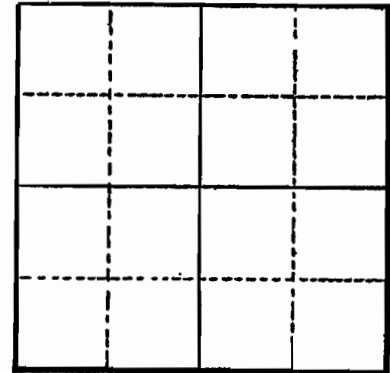

Section 2

Altitude at well 950'

TYPE OF WELL: Drilled Date Constructed 1946

Depth drilled 314' Depth cased 100'

CASING RECORD:

- 8 inch set from 12 to 160 feet
- 6 inch open hole below 150 feet

FINISH:

AQUIFERS:

Basalt

RECEIVED

JUN 29 2009

WATER LEVEL:

53 feet (March 1946)

WATER RESOURCES DEPT
SALEM, OREGON

PUMPING EQUIPMENT: Type Turbine

H.P. _____

Capacity 150 G.P.M.

WELL TESTS:

Drawdown _____ ft. after _____ hours _____ G.P.M.

Drawdown _____ ft. after _____ hours _____ G.P.M.

USE OF WATER Irrigation

Temp. _____ °F. _____, 19 _____

SOURCE OF INFORMATION USGS GR-3512

DRILLER or DIGGER A.A. Durand & Son

ADDITIONAL DATA:

Log Water Level Measurements _____ Chemical Analysis _____ Aquifer Test _____

REMARKS:

- Dug well, no record 0 to 28
- Gravel, coarse, loose 28 to 95
- Basalt, black 95 to 105
- Basalt, brown, porous 105 to 150
- Basalt, black, creviced 189-190 & 214-218 ---- 150 to 253
- Basalt, porous 253 to 292
- Basalt, firm, black 292 to 308
- Basalt, red 308 to 331
- Basalt, black 331 to 314

T 10920