


T4S, R3W WM

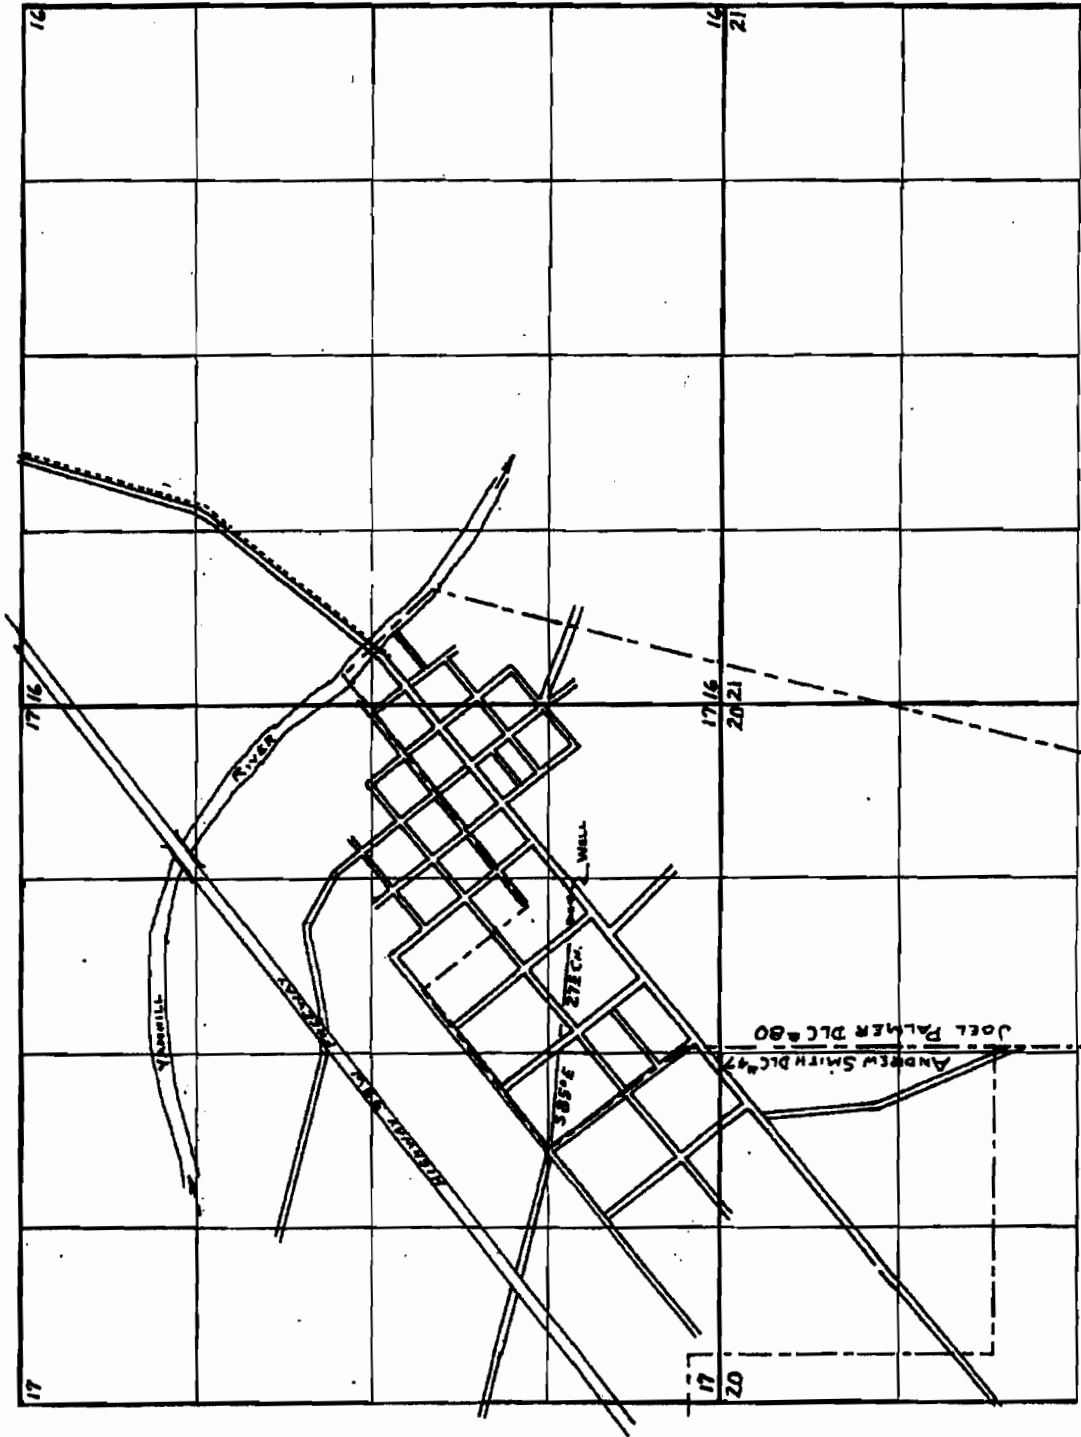

DWG 2 of 2

CITY OF DAYTON MUNICIPAL WATER SUPPLY
No. G-1819 & G-1820
G-1663 & G-1664

34218
26950

RECEIVED

JUN 30 2009

WATER RESOURCES DEPT
SALEM, OREGON

10926