


# T.19S. R.1W.W.M.



Historical Point of Diversion Change

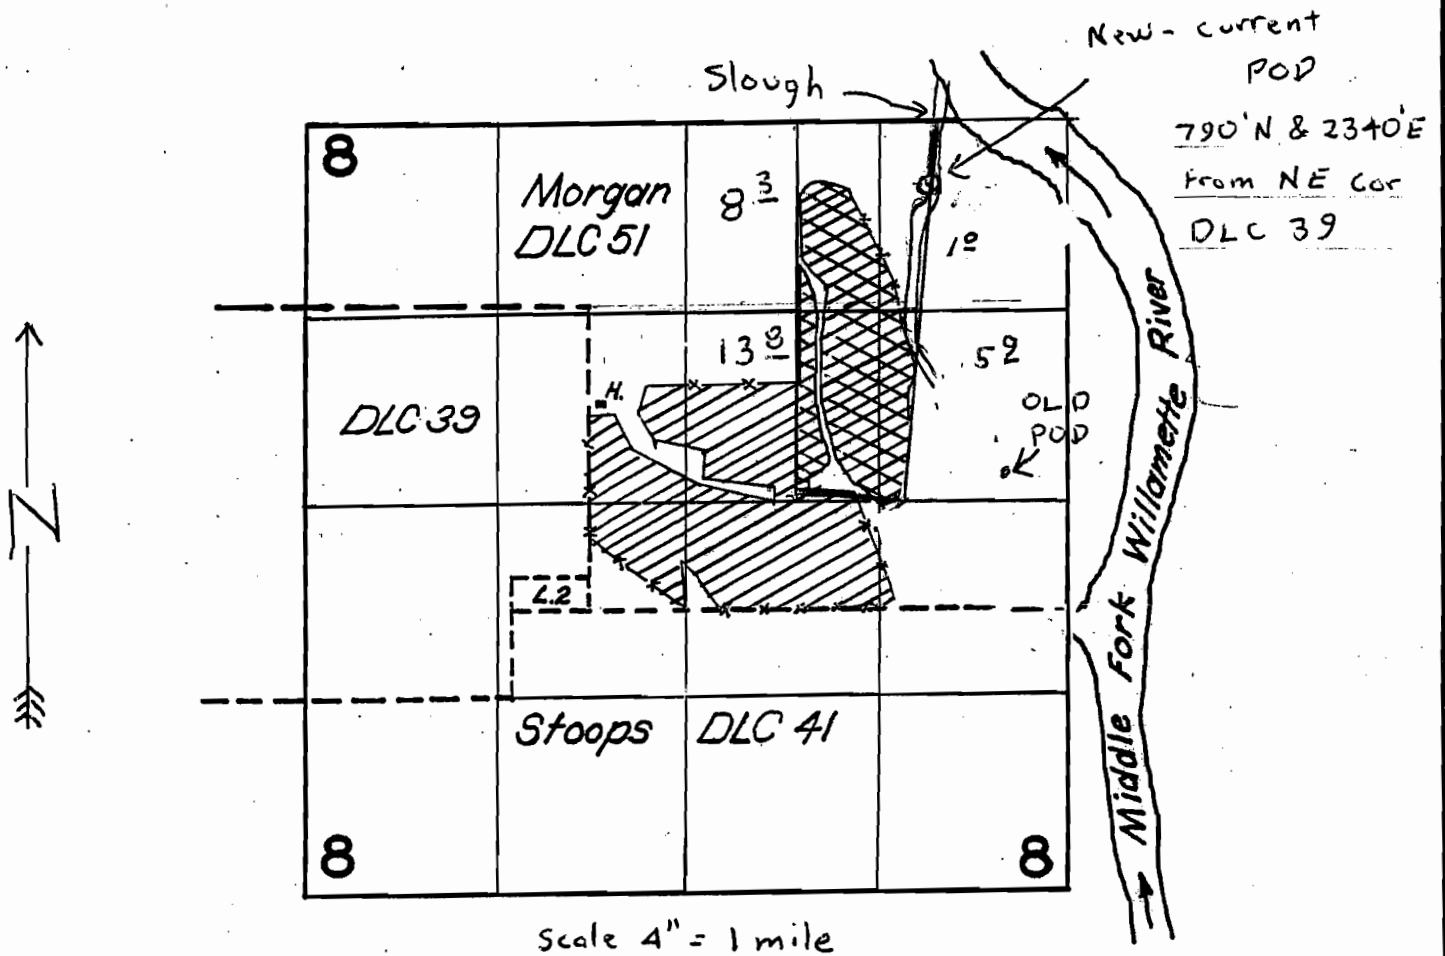

Affecting These Lands

All on TL 103

**RECEIVED**

OCT 29 2007

WATER RESOURCES DEPT  
SALEM, OREGON

Permit S-25217  
cert 44405

1 10483