



T 23 S, R 32 1/2 E, WM

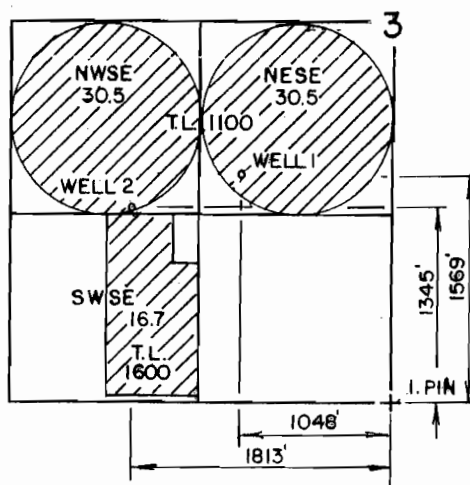

THE PURPOSE OF THIS MAP IS TO IDENTIFY THE LOCATION OF THE WATER PIONEER. IT IS NOT INTENDED TO PROVIDE INFORMATION RELATIVE TO THE LOCATION OF PROPERTY OWNERSHIP.

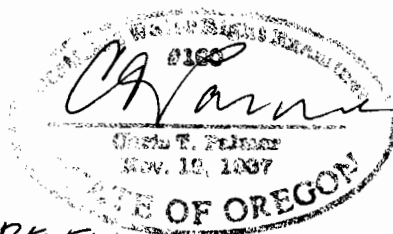

REVIEW 1-1-2009

RECEIVED

APR 06 2007


WATER RESOURCES DEPT
SALEM, OREGON

10361

RECEIVED

OCT 30 2006

WATER RESOURCES DEPT
SALEM, OREGON

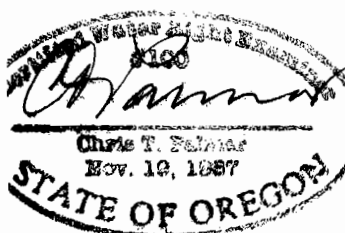

REVIEW 1-1-2007

FINAL PROOF SURVEY

UNDER
APPLICATION G-8128
PERMIT G-7639

IN THE NAME OF
HARRY T. & CECILIA MCCALL

Scale: 4" = 1 MILE

Date: OCT. 2006

Job: 2268-06

Dsn:

Drn: CHRIS

Ckd:



M.A. PALMER & SONS, INC.
ENGINEERING & SURVEYING
711 Ponderosa Village • Box 61
Burns, Oregon 97720

Sht. No.

of 1