

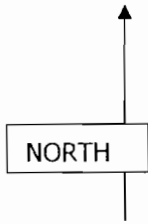


PERMIT AMENDMENT APPLICATION MAP
MT. JEFFERSON FARMS, INC.
T 9 & 10 S R 2 W, W.M.
 Scale 4" = 1 mile

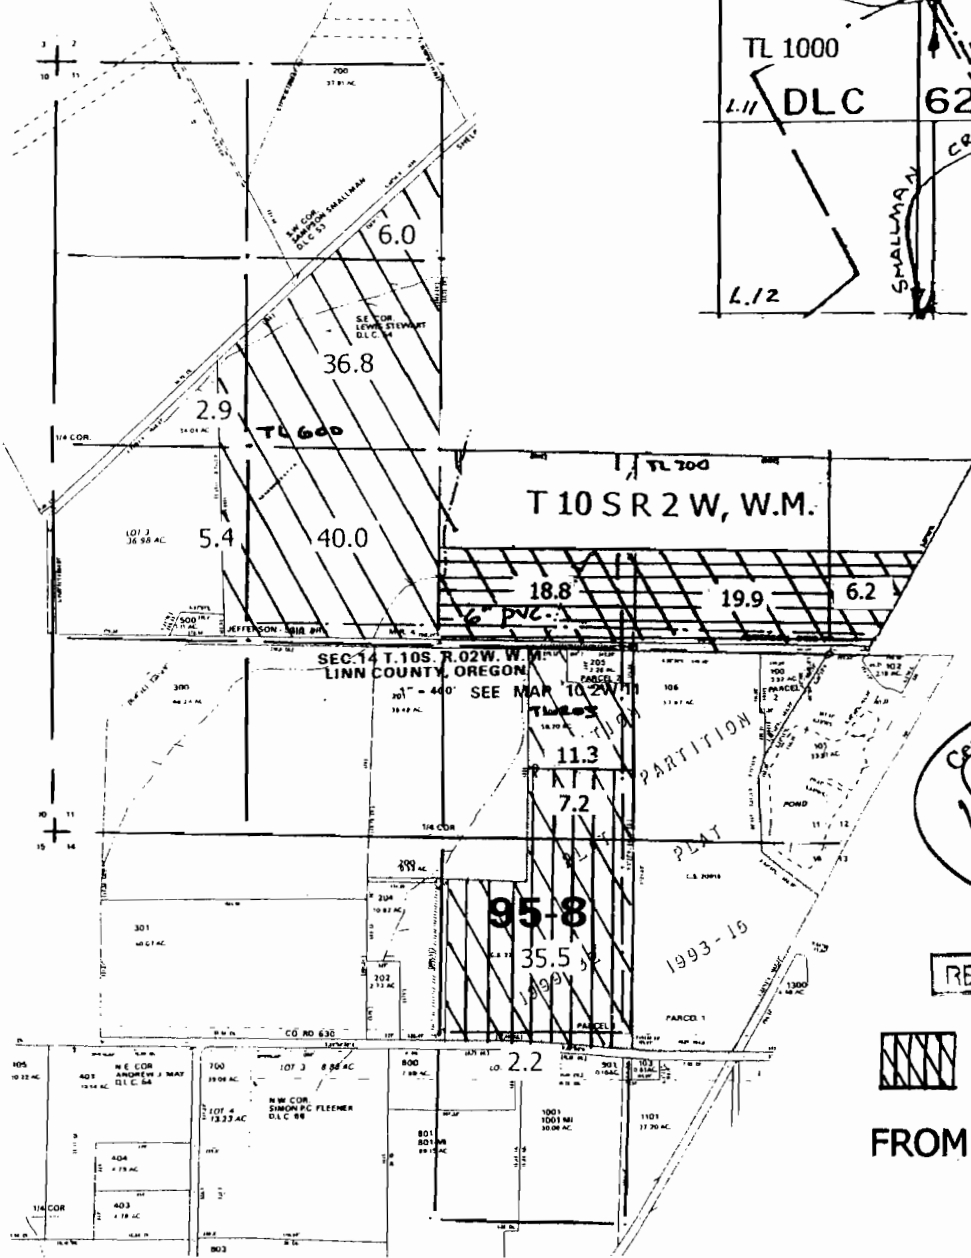


T 9 S R 2 W, W.M.

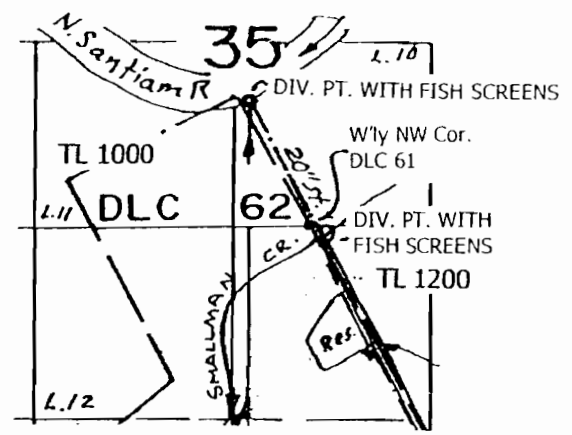


RECEIVED

SEP - 9 2009
 WATER RESOURCES DEPT
 SALEM, OREGON

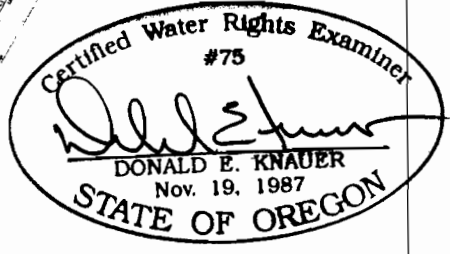

RENEWAL DATE: 6/30/2011

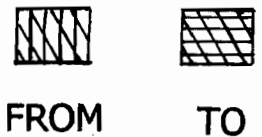

N. Santiam Rvr. Div. Pt.: 850' N & 400' W from the W'ly NW corner DLC 61

This map is for water right purposes only.

T 10950

Don Knauer Consulting