


Permit Amendment Map
 Permit G-18247

Section 22 T5S R3W W.M.
 Yamhill County, Oregon

15
 22 sections
 14
 23

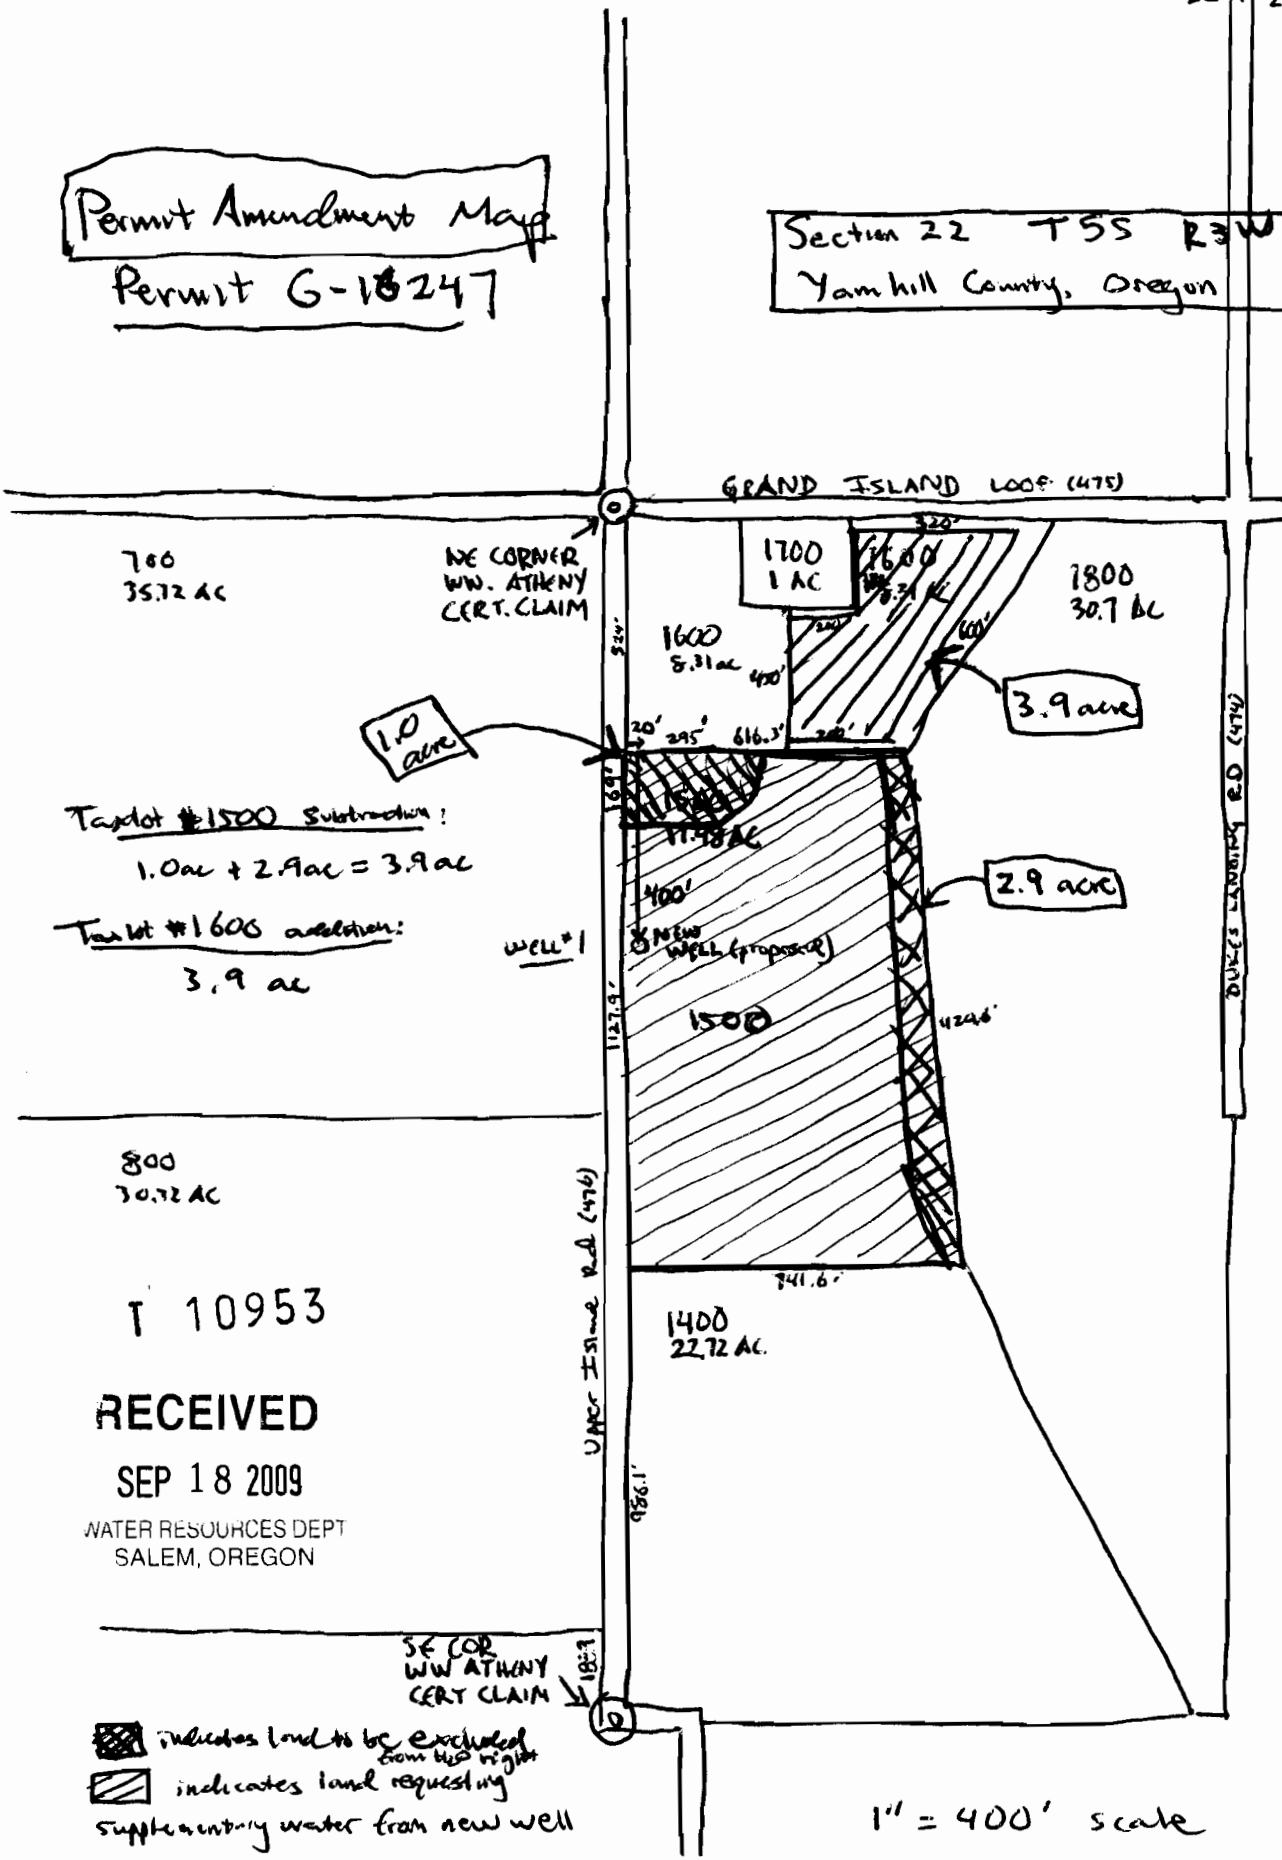

Taxlot #1500 Subtraction:
 1.0 ac + 2.9 ac = 3.9 ac
 Taxlot #1600 addition:
 3.9 ac

T 10953
RECEIVED
 SEP 18 2009
 WATER RESOURCES DEPT
 SALEM, OREGON

indicates land to be excluded from this right
 indicates land requesting supplementary water from new well

APPLICATION MAP for WATER RIGHT: CASEY KULLA, APPLICANT 10-30-06
 TAXLOT 5-3-22-01500, in SE 1/4 NE 1/4