


Map of Additional POD T 36 S, R 2 W, Section 13

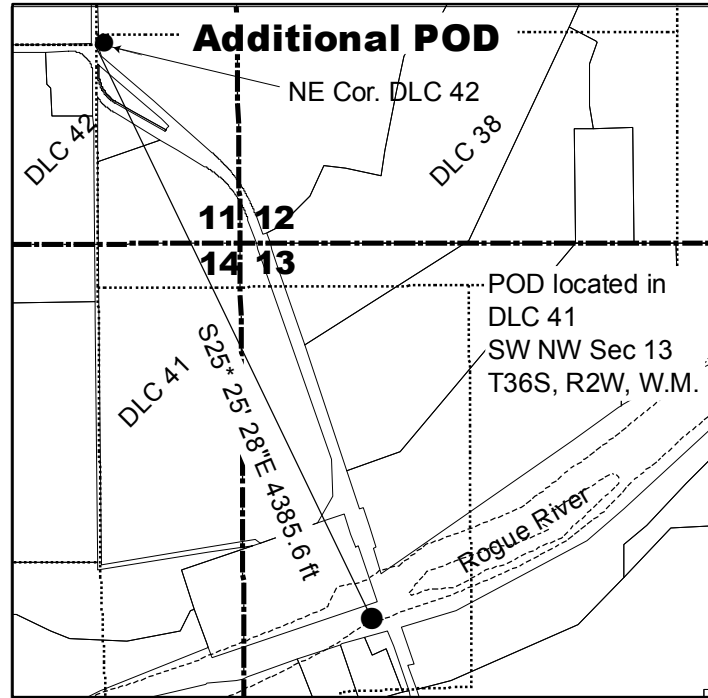

0 1,320 Feet

Note: This map is not to be used for property line location. It is for water right proposes only.



PO Box 5286
Central Point, Oregon 97502
Phone 541-664-5599
Fax 541-664-5603
Email hafarber@charter.net

Farber & Sons, Inc.
431 Oak Street
Central Point, Oregon
Tax ID; 93-1057173