


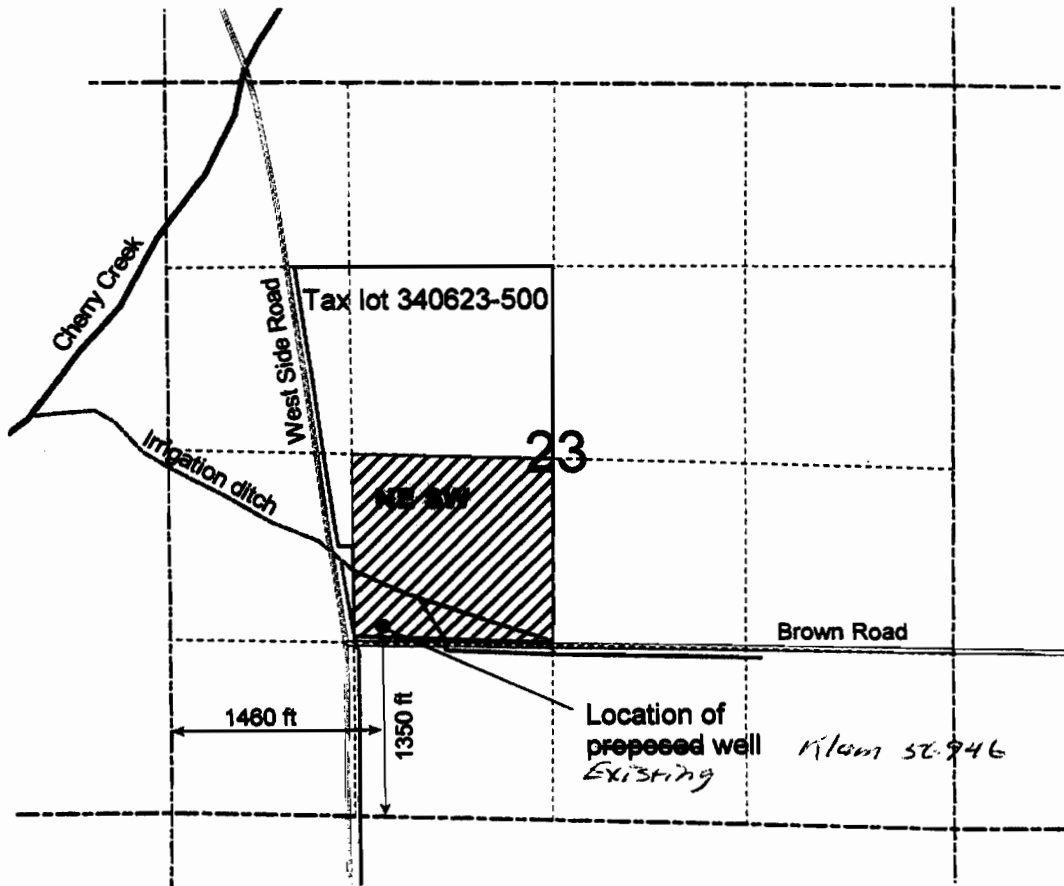


Cherry Creek Aggregate LLC
Permit G-15494
Permit Amendment to
Change Point of Appropriation
T 34 S, R 6 E, Sec 23, W.M.



Legend

-  Area of Industrial use
-  Section Line
-  Quarter-quarter line



Scale 1" 1320'

RECEIVED

OCT 09 2009

WATER RESOURCES DEPT
 SALEM, OREGON

T 10963