


T.6S. R.1E. Sec. 6, W.M.

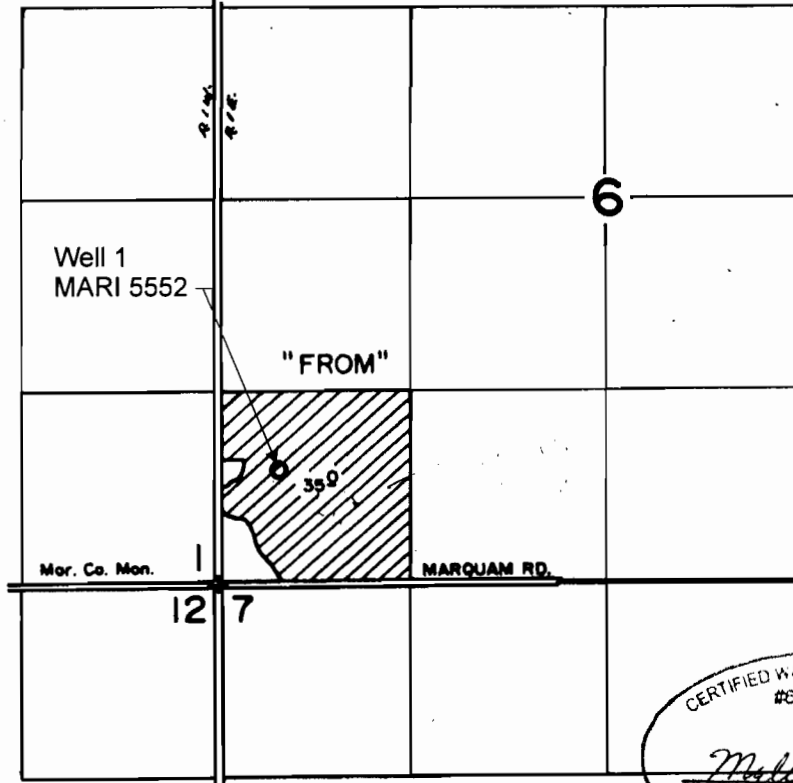

T 10959

RECEIVED
 OCT 01 2009
 WATER RESOURCES DEPT
 SALEM, OREGON

CERTIFIED WATER RIGHTS EXAMINER
 #60772WRE
Melvin R. Kerpella
 MELVIN R. KERPELLAS
 JUNE 16, 1966
 STATE OF OREGON


EXPIRATION DATE: 6/30/2011

Well 1 (MARI 5552) is located 790 feet north and 420 feet east from the SW corner of Section 6.

 Area (35.0 Acres) irrigated under Application GR-243, Permit GR-219.

----- Tax lot boundary

Note: This was the map used for T-6948 that transfers the overlying water right. Therefore, this map is also being used to modify GR-243

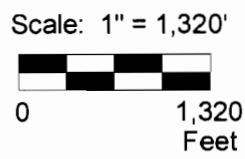

This map was prepared for the purpose of identifying the location of a water right only and is not intended to provide legal dimensions or location of property ownership lines.



Ground Water Registration Modification
 Application GR-243, Permit GR-219

Pacific Hydro-Geology Inc.

Kraemer Farms

3/2005

HankGRMod.cdr