

SECTION PLAT

Section 29 Township 23S Range 33E
County of Harney State of Oregon

NORTH

Prepared: Babe Hawk
Asst. Watermaster, Dist 10

RECEIVED

OCT 14 2009

WATER RESOURCES DEPT
SALEM, OREGON

29

Tax Lot 600

NWSE

NESE

40ac

40ac

SWSE

SESE

40ac

40ac


T 10965

New map For Permit Amendment on G 16378

Vonne Leach
4153 NE Collins Dr
Madras OR 97741

Original map w/ App. G 16917

T 23 S, R 33 E, WM

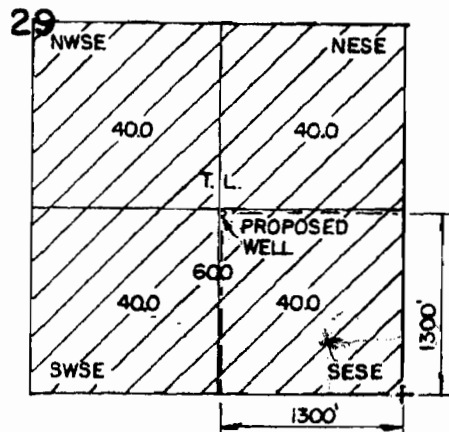

RECEIVED

OCT 14 2009

WATER RESOURCES DEPT
SALEM, OREGON

RECEIVED

AUG 20 2007

WATER RESOURCES DEPT
SALEM, OREGON

THE PURPOSE OF THIS MAP IS TO
IDENTIFY THE LOCATION OF THE
WATER RIGHT. IT IS NOT INTENDED
TO PROVIDE INFORMATION RELATIVE
TO THE LOCATION OF PROPERTY
OWNERSHIP.

T 10965

Chris T. Palmer Nov. 19, 2007 STATE OF OREGON RENEW 1-1-2009	VONNE LEACH		
	WATER RIGHT APPLICATION MAP		
	Scale: 4 = 1 MILE	Date: JULY 2007	Job: 2387
	Dsn:	M.A. PALMER & SONS, INC. ENGINEERING & SURVEYING 711 Ponderosa Village • Box 61 Burns, Oregon 97720	Sht. No.
Dm: CHRIS	of 1		
Ckd:			

App No G-16917