


**Authorized POD Locations**

Straw Ranch Cr; SENW, S 33  
 Low Ditch #2; NESE, S 33  
 Low Ditch #3; NWSW, S 34  
 Rizor Upper N Side; SWSE, S 34  
 Rizor S Side; SESE, S 34  
 Rizor N Side; SESE, S 34  
 E Hill Cr; SWSE, S 34 (NO POD CHANGE)  
 W Hill Cr; SESW, S 34 (NO POD CHANGE)

ALL WITHIN T 10 S, R 42 E, W.M.

**Authorized Place of Use for Wayne Troy  
 Map 1 of 2**

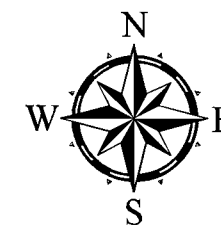


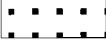
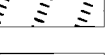
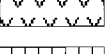




1 inch = 1,000 feet



1960 1


● Authorized Points of Diversion

The decree map was found to be inaccurate. The lands on this map redescribe and clarify the authorized places of use within Certificates 5961, 6005 and 6042. Current GIS technology and 2005 aerial photography were used to define the places of use. The railroad was constructed prior to the construction of I-84. This railroad was used as reference in redescribing the places of use. This map more accurately reflects the places of use at that

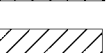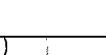-  C-5961, 1863 Alder Cr, Low #2 POD  
POD CHANGE ONLY
-  C-5961, 1863 Alder Cr, Low #2 POD  
POU/POD
-  C-5961, 1864 Hill Cr, West & East Hill Cr POD  
NO CHANGE REDESCRIPTION ONLY
-  C-5961, 1868 Alder Cr, Low #3 POD  
POD CHANGE ONLY
-  C-5961, 1868 Alder Cr, Low #3 POD  
POU/POD
-  C-6005, 3/1877 Alder Cr, Rizor N & S  
side POD (POU/POD)
-  C-6042, 1862 Straw Cr  
REMAINING RIGHT
-  C-6042, 1862 Straw Cr,  
POU CHANGE ONLY
-  C-6042, 1864 Alder Cr, Troy POD  
POU/POD CHANGE
-  C-6042, 1864 Alder Cr, Troy POD  
POD CHANGE ONLY


Township 10 South Range 42 East W.M.

Township 11 South Range 42 East W.M.

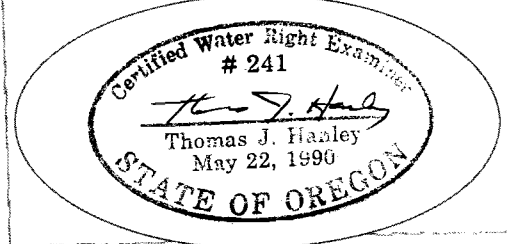

THIS MAP IS FOR THE PURPOSE OF LOCATING A WATER RIGHT ONLY AND HAS NO INTENT TO PROVIDE LEGAL DIMENSIONS OR THE LOCATION OF PROPERTY LINES

RECEIVED  
 OCT 02 2009  
 WATER RESOURCES DEPT  
 SALEM, OREGON

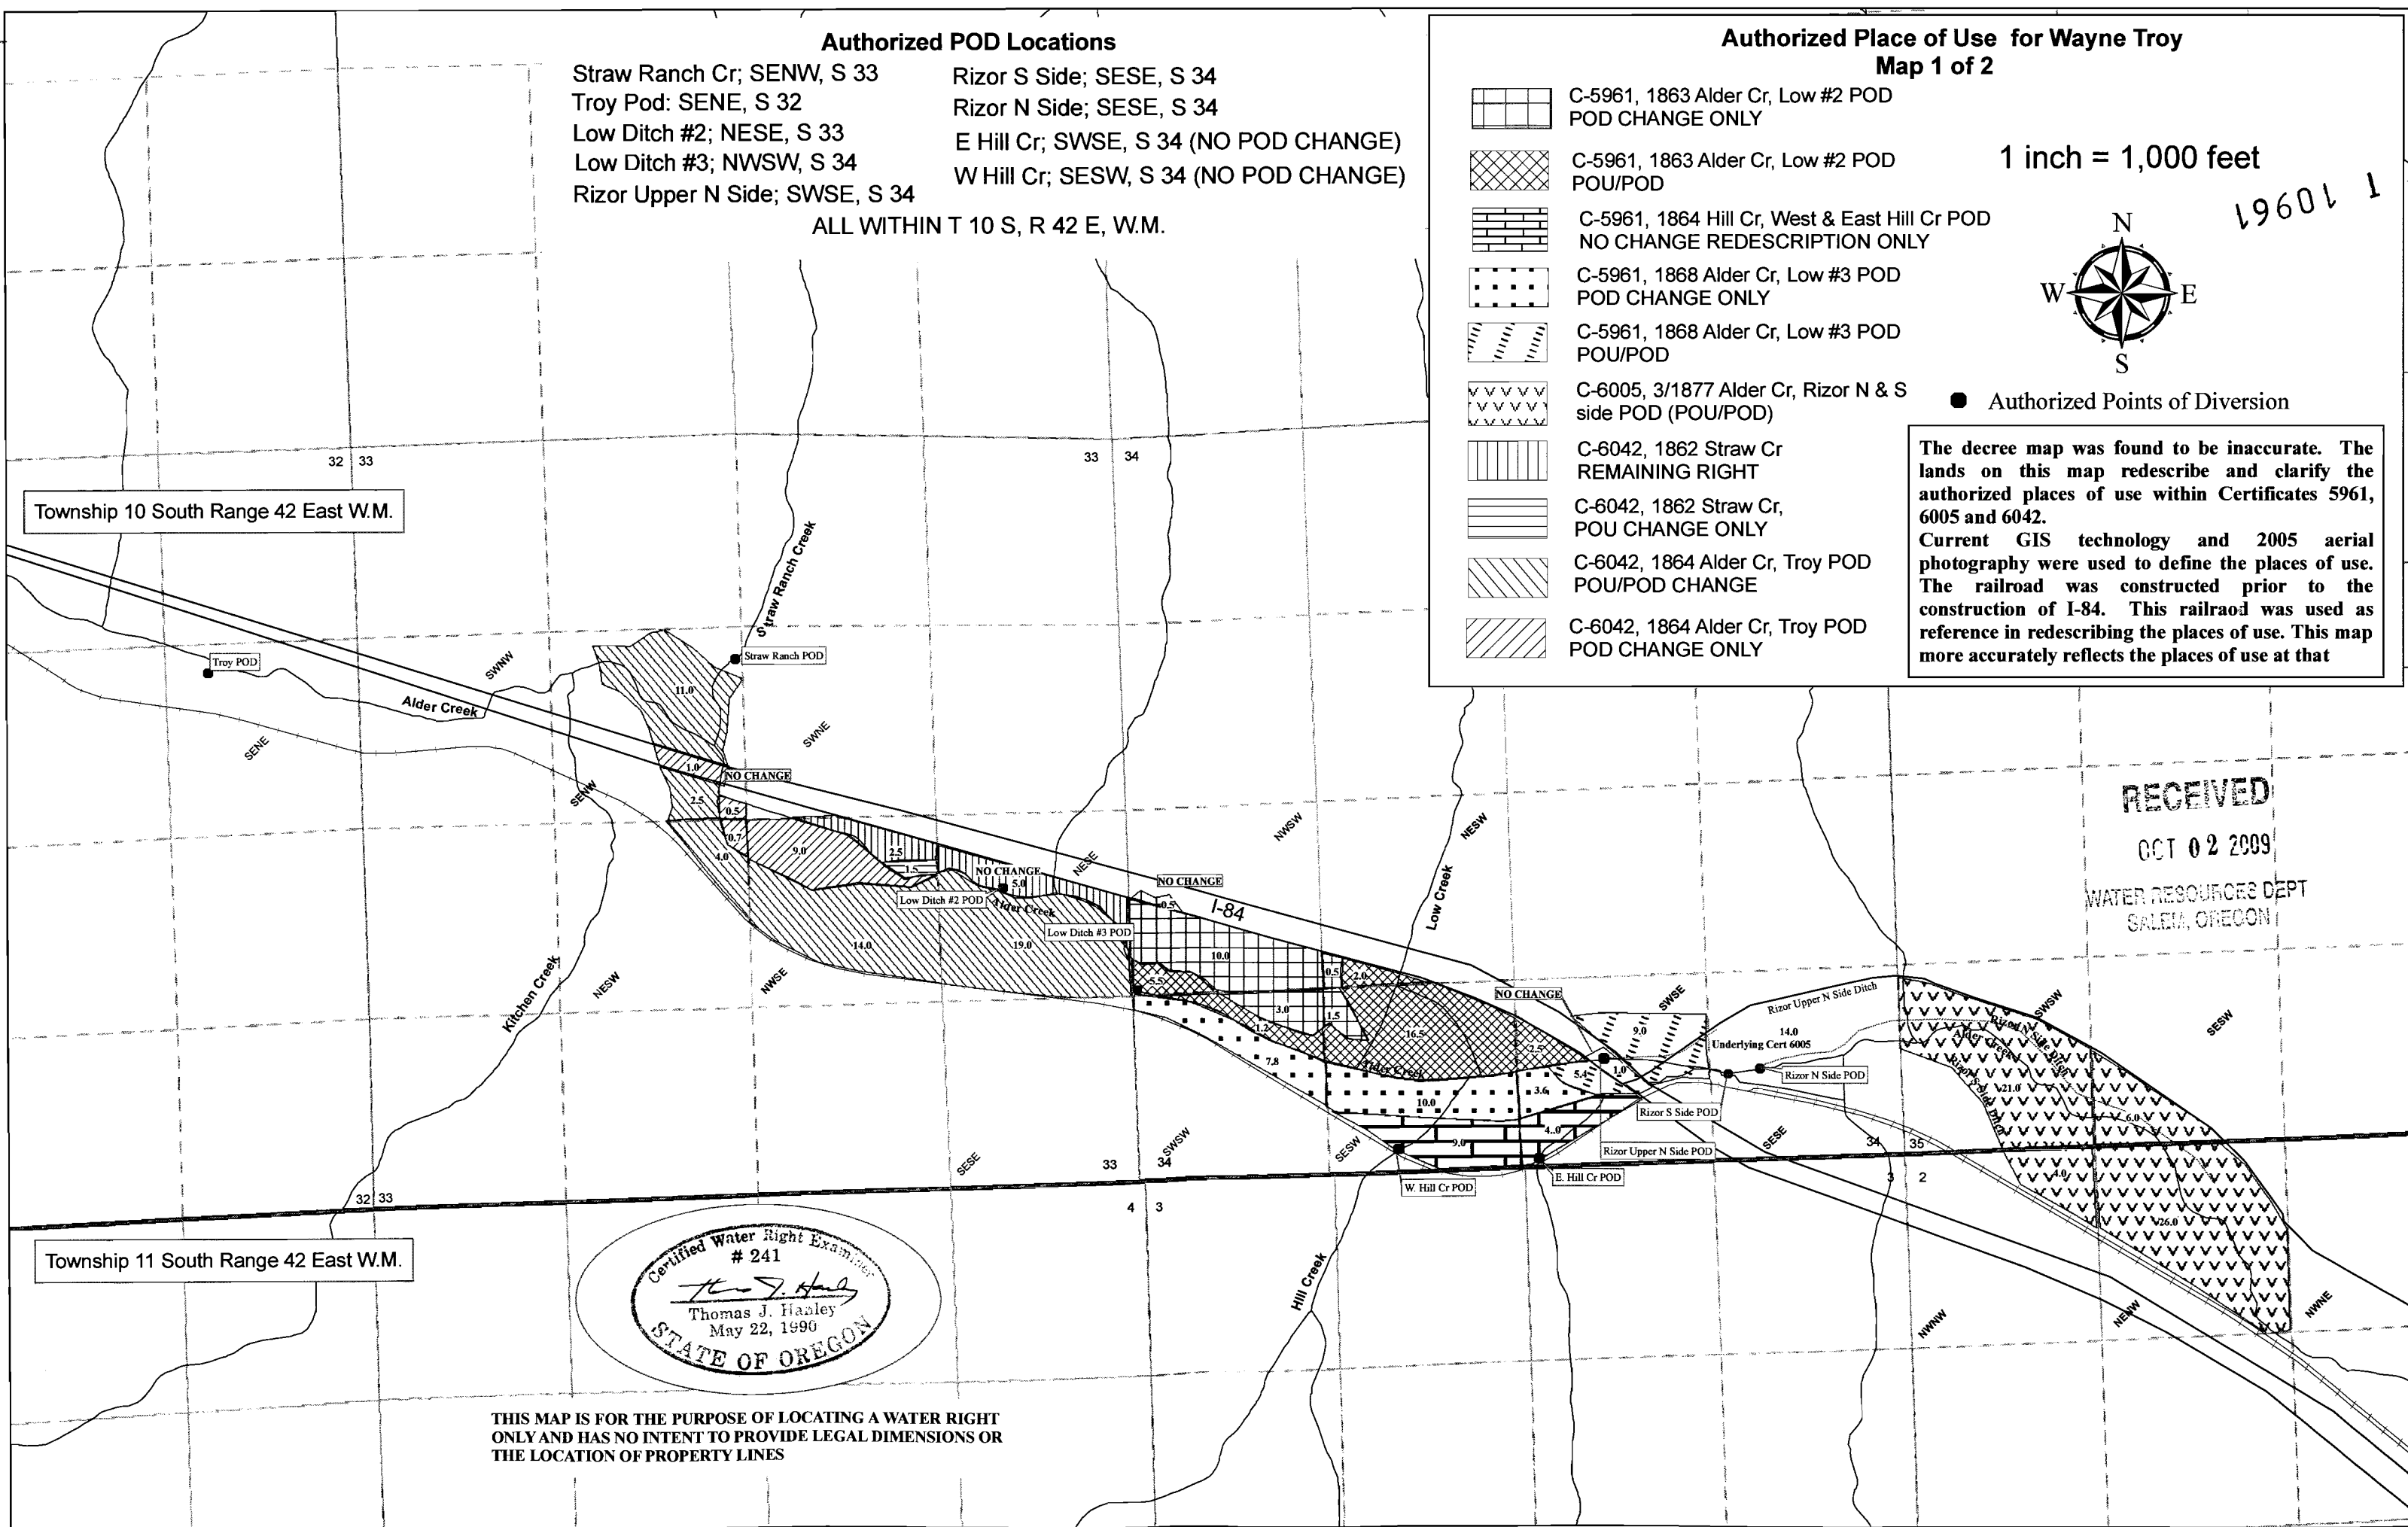

Proposed POD Locations

Wendt Pod #1: 1938 feet N & 244 feet W from the SE corner Sec 33

Wendt Pod #2: 1271 feet N & 600 feet W from the SW corner Sec 34

Wendt Pod #3: 905 feet N & 1673 feet E from the SW corner Sec 34

Briskey Pod #1: 508 feet N & 1850 feet W from the SE corner, Sec 34

Briskey Pod #2: 620 feet N & 1347 feet W from the SE corner, Sec 34




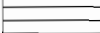

Troy Pod: 1708 feet S and 3271 feet W from the NE corner Sec 33

ALL WITHIN T 10 S, R 42 E, W.M.


Proposed Place of use and POD's for Wayne Troy


MAP 2 OF 2


1 inch = 1,000 feet

-  C-5961, 1863 Alder Cr  
Briskey #1, Wendt #1 POD
-  C-5961, 1868 Alder Cr  
Wendt #2, Troy POD
-  C-6005, 3/1877 Alder Cr  
Troy, Wendt #3 POD
-  C-6042, 1862 Straw Cr
-  C-6042, 1864 Alder Cr  
Troy, Briskey #2 POD




Proposed Points of Diversion 

Points of Diversion as indicated on the decree map 

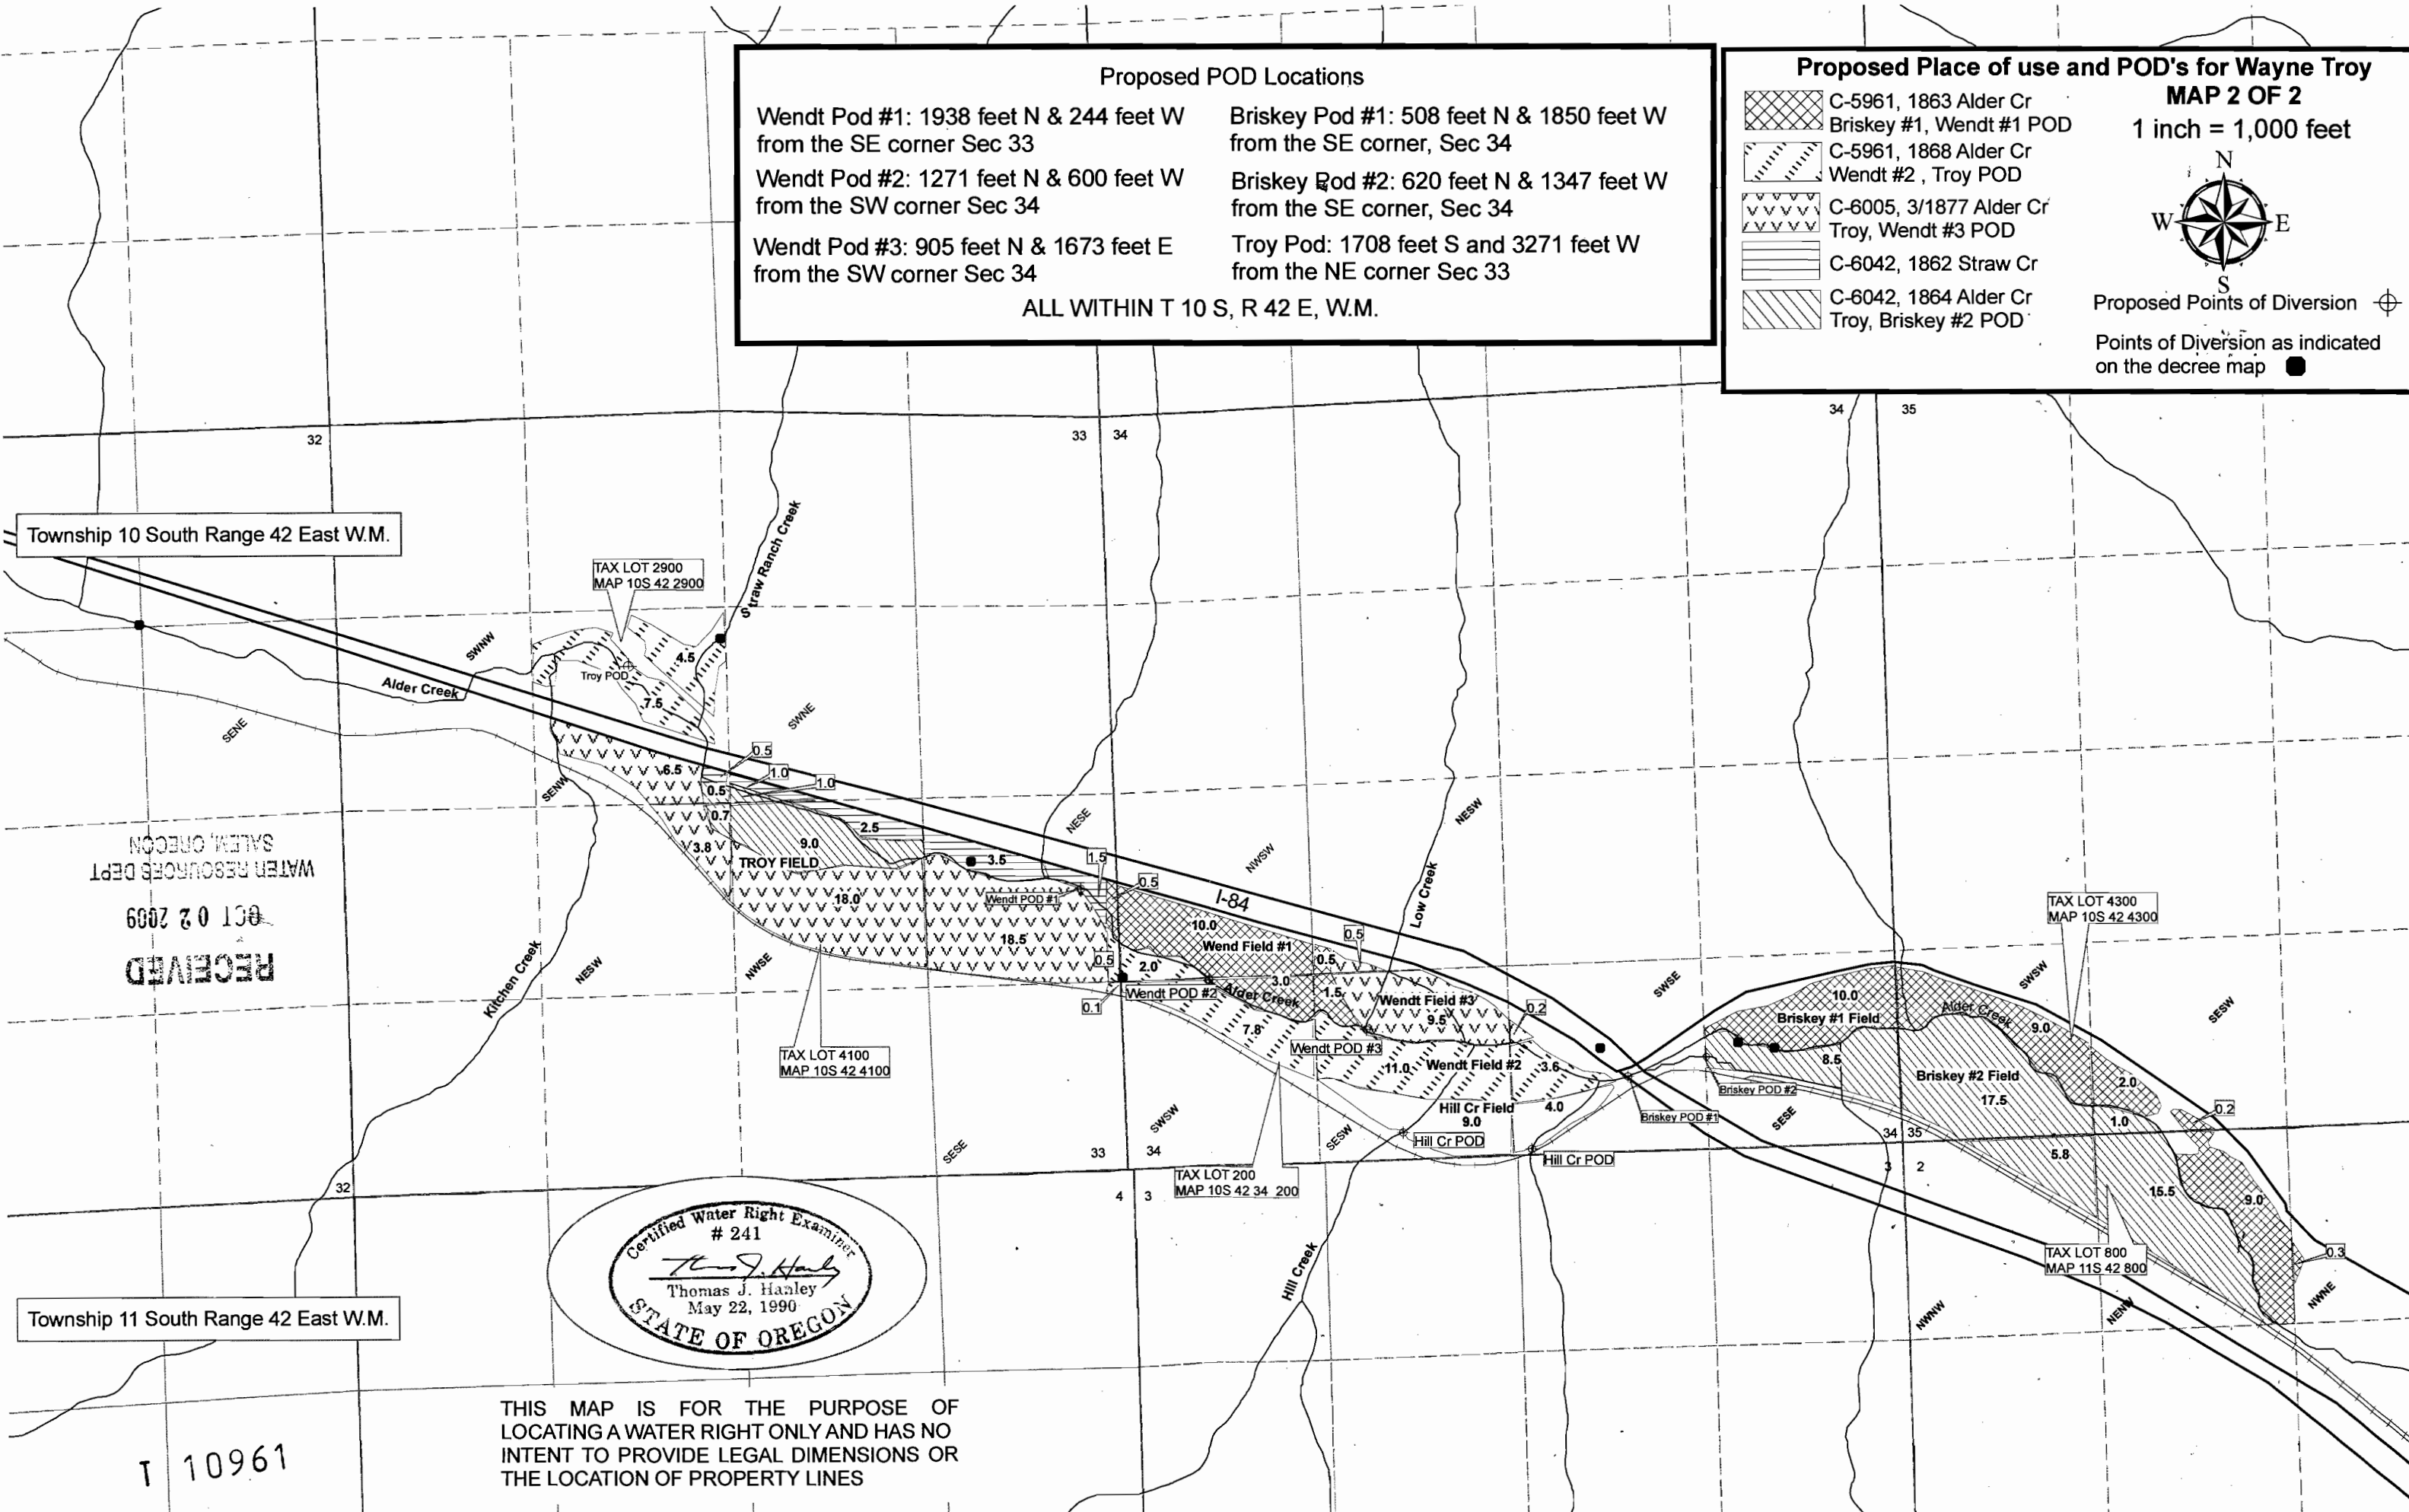

RECEIVED  
OCT 02 2009  
WATER RESOURCES DEPT  
SALEM, OREGON

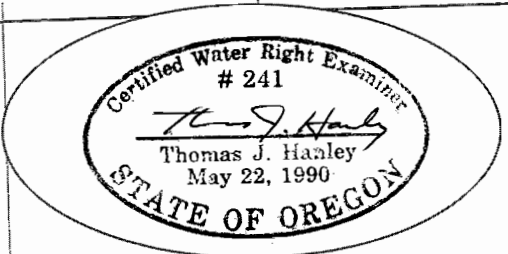

THIS MAP IS FOR THE PURPOSE OF LOCATING A WATER RIGHT ONLY AND HAS NO INTENT TO PROVIDE LEGAL DIMENSIONS OR THE LOCATION OF PROPERTY LINES

Township 10 South Range 42 East W.M.

Township 11 South Range 42 East W.M.

T 10961