

CERTIFICATE NO. 36701


PREPARED FOR

BY

217 N. CANYON BLVD.

MAP

## HISTORIC POD CHANGE

 

REQUESTED :

\* POD AT IRRIGATION  
POND R-87213

RECEIVED

OCT 20 2009

WATER RESOURCES DEPT  
SALEM, OREGON


POD#1 IS 30 FEET SOUTH AND 460 FEET WEST OF THE  
NE CORNER OF SECTION 15, T.9S., R.21E.

POD#2 IS 60 FEET SOUTH AND 430 FEET WEST OF THE  
NE CORNER OF SECTION 15, T.9S., R.21E.

POD#3 IS 3560 FEET SOUTH AND 1980 FEET WEST OF  
THE NE CORNER OF SECTION 15, T.9S., R.21E.

NOTE:  
THE PREPARATION OF THIS MAP WAS FOR THE PURPOSE  
OF IDENTIFYING THE LOCATION OF THE WATER RIGHT  
AND HAS NO INTENT TO PROVIDE DIMENSIONS OR  
LOCATION OF PROPERTY OWNERSHIP LINES.

T 10971

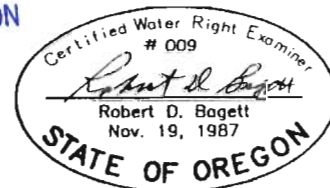

# Giottonini Trust

## T 9S R 21E Section 15 & 22



0 650 1,300 2,600 Feet

1 inch equals 800 feet

**RECEIVED**

OCT 20 2009

**WATER RESOURCES DEPT  
SALEM, OREGON**




This product is for informational purposes and may not have been prepared for, or be suitable for legal, engineering, or surveying purposes. Users of this information should review or consult the primary data and information sources to ascertain the usability of the information.

T 10971

--OWRD GIS jtc, WMdistrict21: GiottoniniTrust\_081027.mxd

**WATER RIGHT MAP**  
 CERTIFICATE NO. 25892  
 SITUATED IN SECTION 22, T.9S., R.21E., W.M.  
 WHEELER COUNTY, OREGON  
 MARCH 19, 2007

PREPARED FOR  
**LOU GIOTTONINI**  
 BY  
**BAGETT, GRIFFITH & BLACKMAN**  
 PROFESSIONAL LAND SURVEYORS  
 217 N. CANYON BLVD.  
 JOHN DAY, OREGON

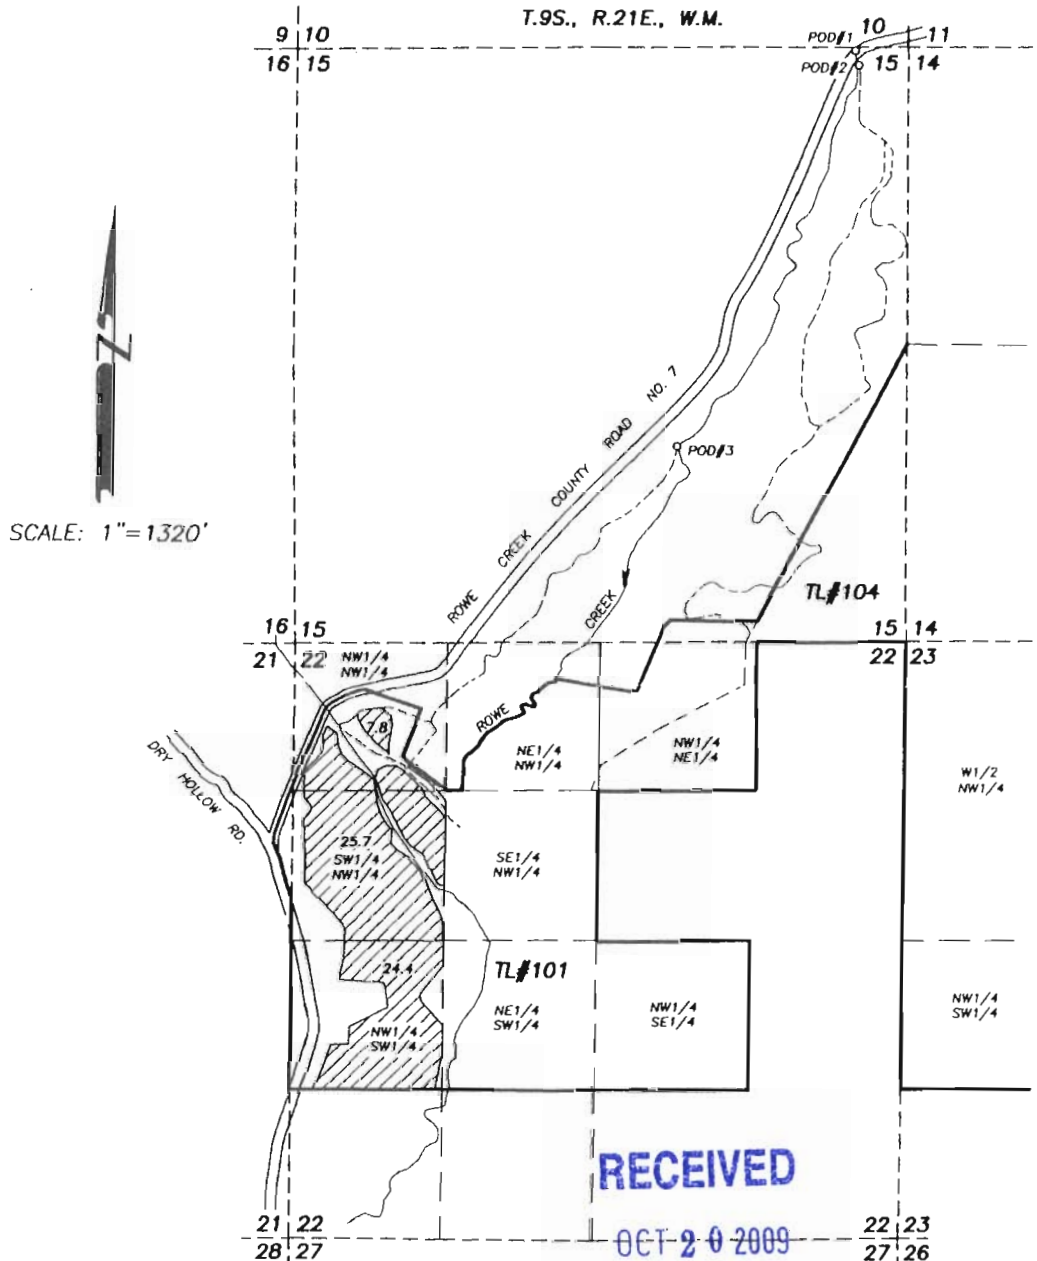

POD#1 IS 30 FEET SOUTH AND 460 FEET WEST OF THE NE CORNER OF SECTION 15, T.9S., R.21E.

POD#2 IS 60 FEET SOUTH AND 430 FEET WEST OF THE NE CORNER OF SECTION 15, T.9S., R.21E.


POD#3 IS 3560 FEET SOUTH AND 1980 FEET WEST OF THE NE CORNER OF SECTION 15, T.9S., R.21E.

NOTE:  
 THE PREPARATION OF THIS MAP WAS FOR THE PURPOSE OF IDENTIFYING THE LOCATION OF THE WATER RIGHT AND HAS NO INTENT TO PROVIDE DIMENSIONS OR LOCATION OF PROPERTY OWNERSHIP LINES.

**WATER RESOURCES DEPT  
 SALEM, OREGON**

Certified Water Right Examiner  
 # 009  
*Robert D. Bagett*  
 Robert D. Bagett  
 Nov. 19, 1987  
**STATE OF OREGON**

T. 10971

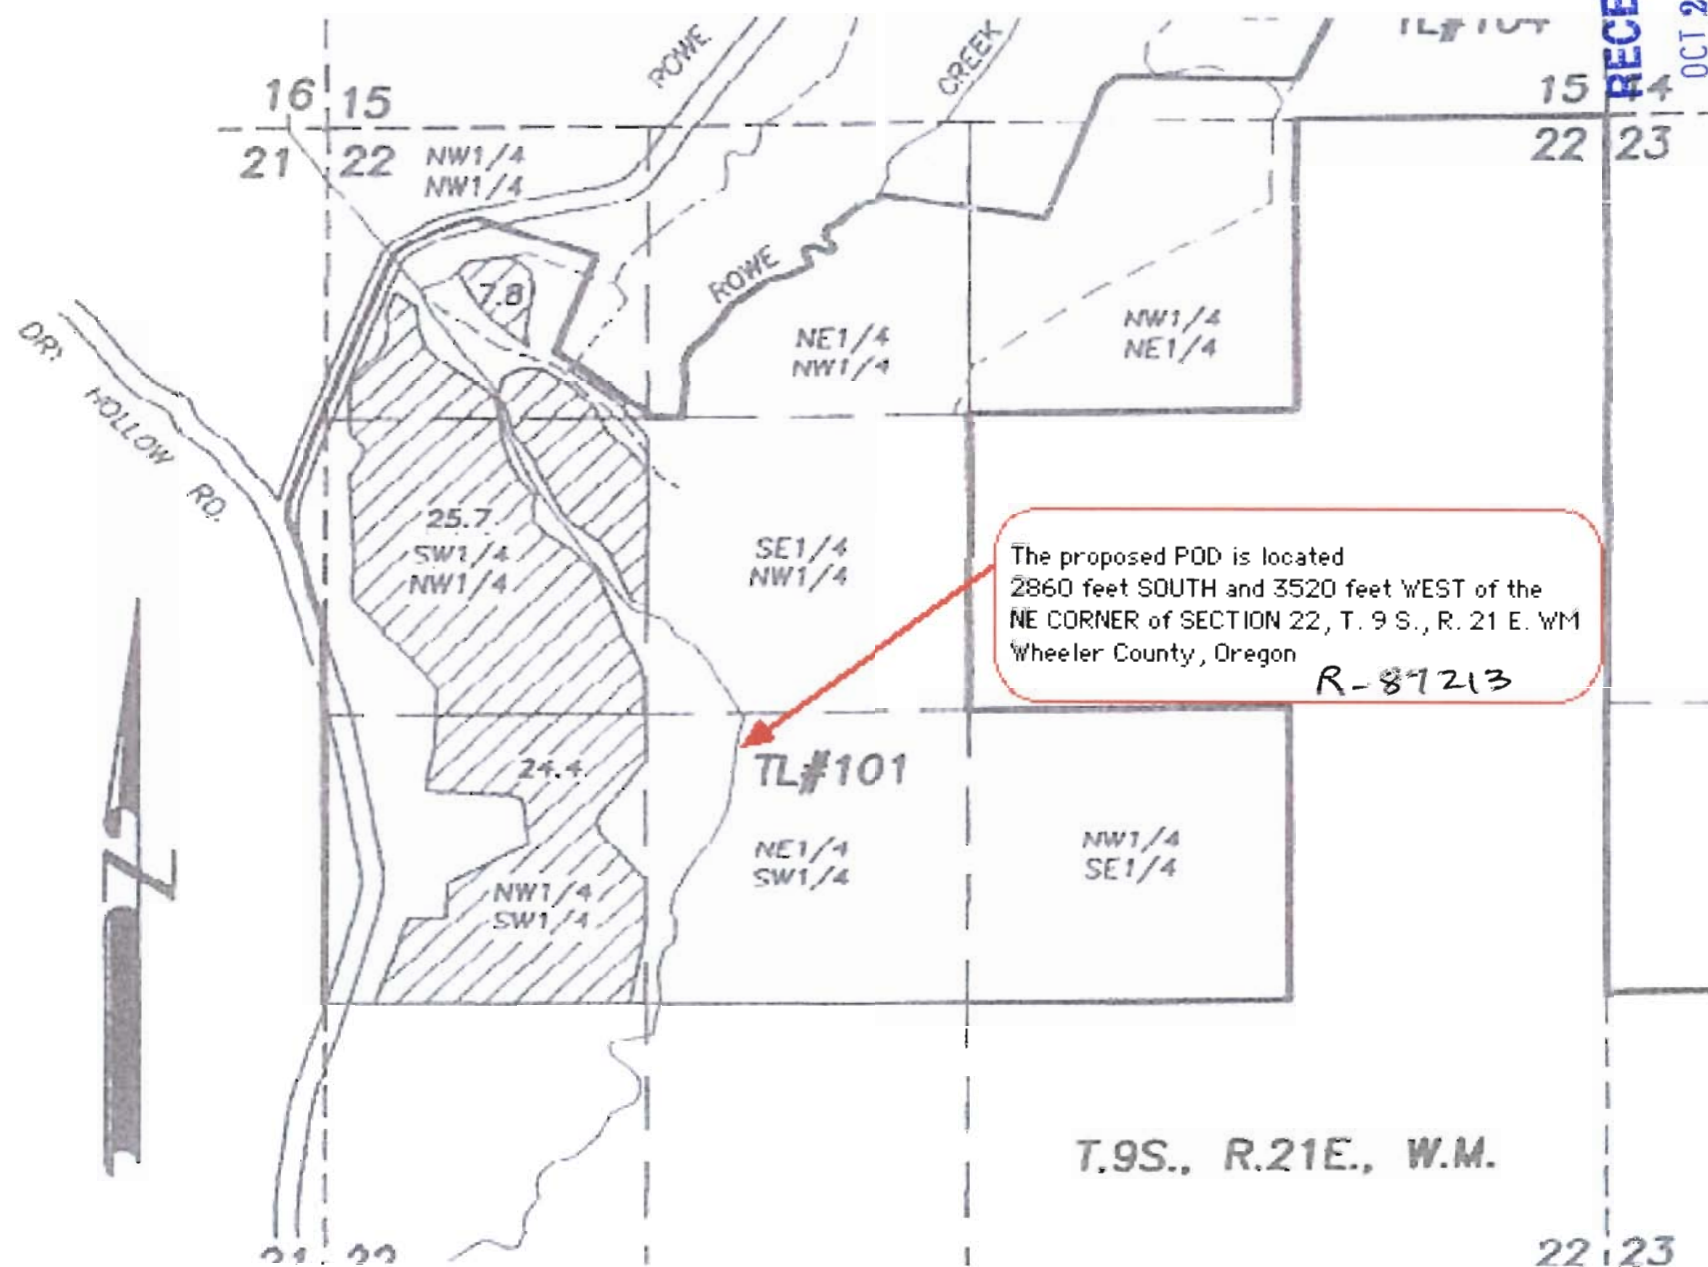

RECEIVED

OCT 20 2009

WATER RESOURCES DEPT.  
SALEM, OREGON

T 10971

CERTIFICATE NO. 25892

SITUATED IN SECTION 22, T.9S., R.21E., W.M.

WHEELER COUNTY, OREGON

MARCH 19, 2007

PREPARED FOR


LOU GIOTTONINI

BY

BAGETT, GRIFFITH & BLACKMAN  
PROFESSIONAL LAND SURVEYORS

217 N. CANYON BLVD.

JOHN DAY, OREGON

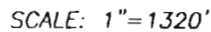


POD#1 IS 30 FEET SOUTH AND 460 FEET WEST OF THE  
NE CORNER OF SECTION 15, T.9S., R.21E.

POD#2 IS 60 FEET SOUTH AND 430 FEET WEST OF THE  
NE CORNER OF SECTION 15, T.9S., R.21E.

POD#3 IS 3560 FEET SOUTH AND 1980 FEET WEST OF THE NE CORNER OF SECTION 15, T.9S., R.21E.

NOTE:  
THE PREPARATION OF THIS MAP WAS FOR THE PURPOSE  
OF IDENTIFYING THE LOCATION OF THE WATER RIGHT  
AND HAS NO INTENT TO PROVIDE DIMENSIONS OR  
LOCATION OF PROPERTY OWNERSHIP LINES.

WATER RESOURCES DEPT  
SALEM, OREGON

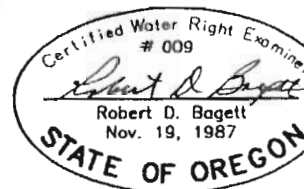

T 10971

# WATER RIGHT MAP

CERTIFICATE NO. 25422

SITUATED IN SECTIONS 15 AND 22, T.9S., R.21E., W.M.

WHEELER COUNTY, OREGON

MARCH 19, 2007

PREPARED FOR


LOU GIOTTONINI

BY

BAGETT, GRIFFITH & BLACKMAN  
PROFESSIONAL LAND SURVEYORS

217 N. CANYON BLVD.

JOHN DAY, OREGON

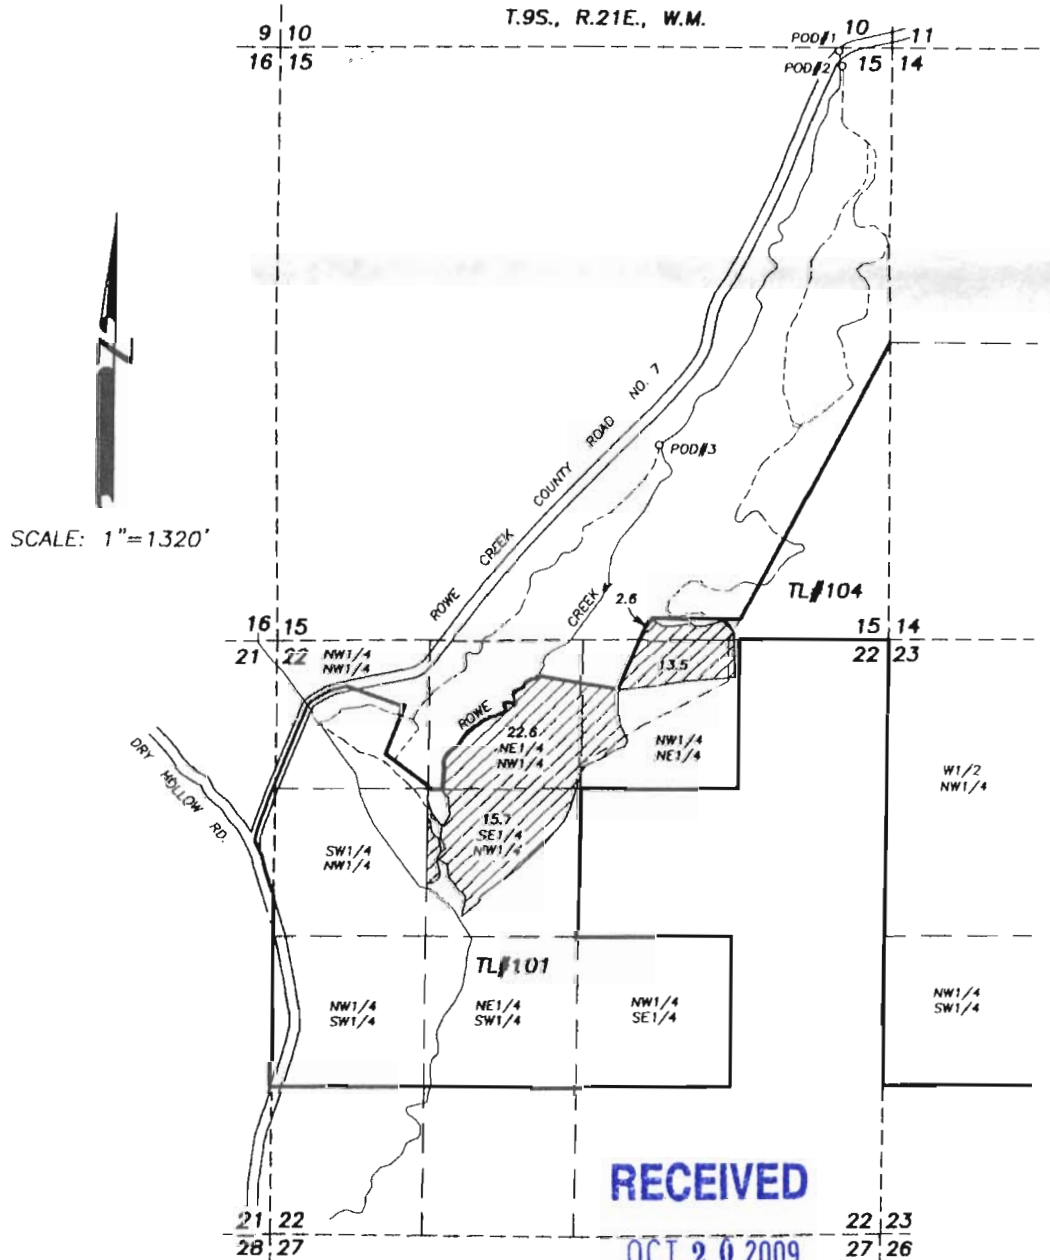

RECEIVED

OCT 20 2009


POD#1 IS 30 FEET SOUTH AND 460 FEET WEST OF THE NE CORNER OF SECTION 15, T.9S., R.21E.

POD#2 IS 60 FEET SOUTH AND 430 FEET WEST OF THE NE CORNER OF SECTION 15, T.9S., R.21E.

POD#3 IS 3560 FEET SOUTH AND 1980 FEET WEST OF THE NE CORNER OF SECTION 15, T.9S., R.21E.

NOTE:  
THE PREPARATION OF THIS MAP WAS FOR THE PURPOSE OF IDENTIFYING THE LOCATION OF THE WATER RIGHT AND HAS NO INTENT TO PROVIDE DIMENSIONS OR LOCATION OF PROPERTY OWNERSHIP LINES.

WATER RESOURCES DEPT  
SALEM, OREGON

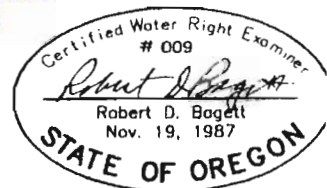

T 10971

## Revised Map of Reservoir as POD

T.9S., R.21E., W.11W.

9 10  
16 15

10 11  
15 14

POD#1  
POD#2  
POD#3

ROWE CREEK  
COUNTY ROAD NO. 7

16 15  
21 22

NW1/4  
NW1/4

7.8

22.6  
NE1/4  
NW1/4

15.7  
SE1/4  
NW1/4

25.7  
SW1/4  
NW1/4

24.4

NW1/4  
SW1/4

15.5  
NW1/4  
NE1/4

2.6

TL#104

15 14  
22 23

W1/2  
NW1/4

DRY HOLLOW RD.

RESERVOIR - located from  
NW corner of Section 22  
2550 feet south  
1,600 feet east

TL#101

NE1/4  
SW1/4

NW1/4  
SE1/4

NW1/4  
SW1/4

21 22  
28 27

22 23  
27 26

SCALE: 1"=1320'

REGISTERED  
PROFESSIONAL  
LAND SURVEYOR

Bert D. Baggett

OREGON  
JULY 12, 1983  
BERT D. BAGGETT  
598

RECEIVED  
JUN 30 2008  
WATER RESOURCES DEPT.  
SALEM, OREGON

RECEIVED  
DEC 1  
WATER RESOURCES  
SALEM, OREGON

12/31/05

Renewal Date: 12/31/03

WATER RESOURCES DEPT  
SALEM OREGON 22

WATER RESOURCES DEPT  
SALEM, OREGON