

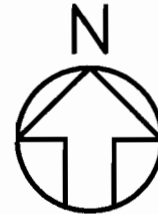


T.20S., R16E., W.M. SECTIONS 5 AND 6


Located in NE 1/4 NW 1/4, SE 1/4 NW 1/4, NE 1/4 SW 1/4, and NW 1/4 SW 1/4 of
Section 5, TAX LOTS 20-16-00-1206, 1212, and 1213,
And in NE 1/4 NE 1/4, SE 1/4 NE 1/4, and NE 1/4 SE 1/4 OF Section 6,
TAX LOT 20-16-00-1204

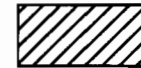

SCALE: 1" = 1320'

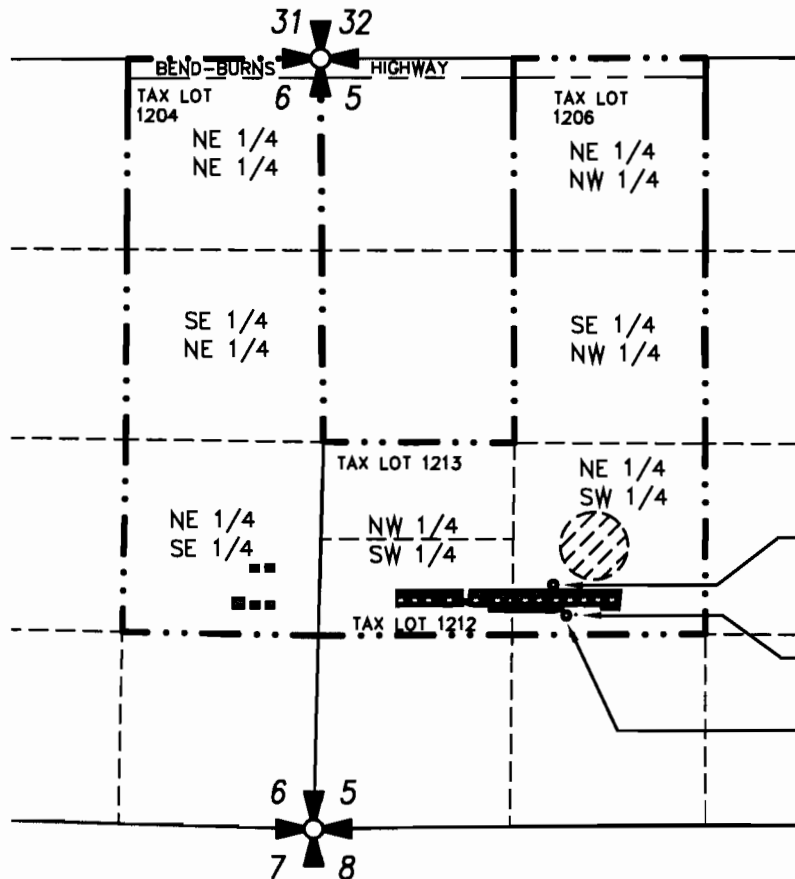

Authorized Place of Use

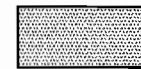

Proposed Place of Use

NE 1/4 SW 1/4 Section 5- 1.84 acres
NW 1/4 SW 1/4 Section 5- 1.66 acres
NE 1/4 SE 1/4 Section 6- 0.39 acres

Total = 3.89 Acres

Authorized POD 3660 feet South,
1520 feet East of Northwest Corner
of Section 5, T 20 S, R 16 E

Meter, approximately 5 feet East of
proposed POD

Proposed POD 3825 feet South,
1682 feet East of Northwest Corner
of Section 5, T 20 S, R 16 E

RECEIVED

NOV 03 2009

WATER RESOURCES DEPT
SALEM, OREGON

PERMIT AMENDMENT MAP UNDER



Application No.G-16873 Permit No.G-16505
IN NAME OF

BEND TRAP CLUB

Prepared: November 2, 2009 by Hickman Williams & Associates, Inc.
1201 NW Wall Street, Ste. 100, Bend, Oregon, 97701
Phone: 541-389-9351, Fax: 541-388-5416

This map is for the purpose of identifying the location of water right only and is
not intended to provide legal dimensions or locations of property ownership lines.

T 10973

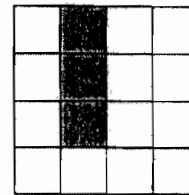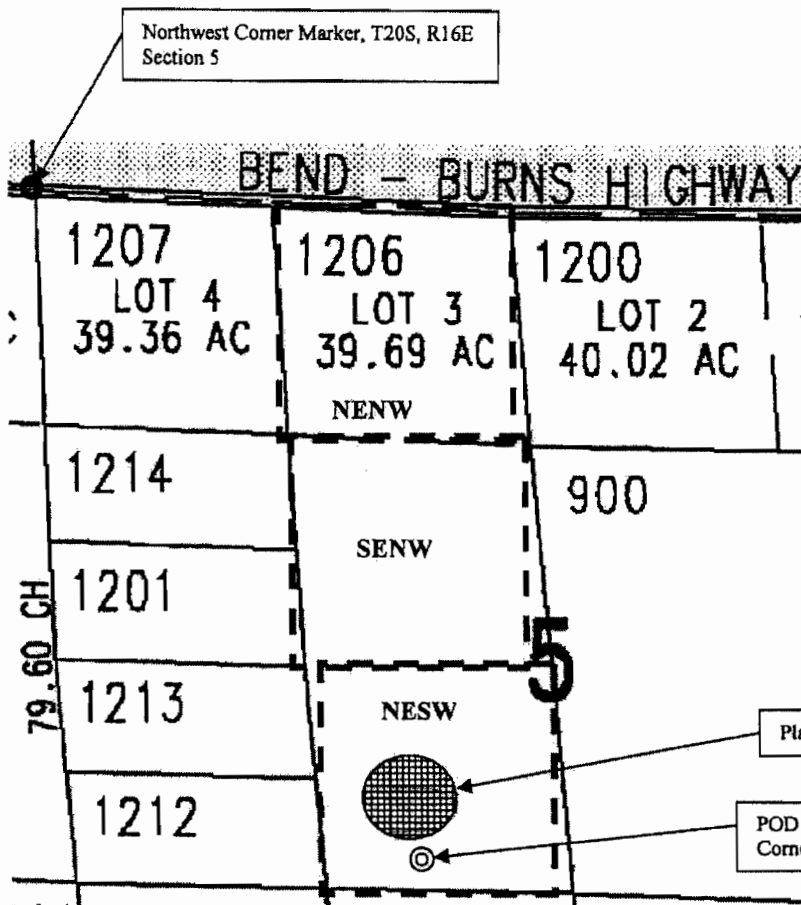

T20S, R16E Section 5

RECEIVED

NOV 03 2009

WATER RESOURCES DEPT
SALEM, OREGON


Groundwater Application Map For Bend Trap Club

Proposed Place of Use Approximate Well Location Corner Marker

T20S R16E, Tax Lot 1206

1 inch equals 1,000 feet

June 13, 2007

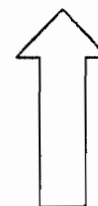

NORTH

Deschutes Irrigation, LLC

P.O. Box 1830
Bend, OR 97709
541-389-2837
waterrights@usa.com

RECEIVED

JUN 18 2007

WATER RESOURCES DEPT
SALEM, OREGON

App No G-16873 Permit No G-16505

MODIFICATION OF APPROVAL FOR SITE PLAN SP-07-32

LOCATED IN A PORTION OF SECTION 5 AND A PORTION OF SECTION 6,
TOWNSHIP 20 SOUTH, RANGE 18 EAST, DESCHUTES COUNTY, OREGON

OWNER/DEVELOPER:
BILL GRANTON, PRESIDENT
PO BOX 7444
BEND, OREGON 97708
(503) 383-1448

DESIGNER:
HICKMAN, WILLIAMS & ASSOCIATES
1201 NW WALTON STREET, SUITE 100
BEND, OREGON 97701
(503) 386-9351

TAX LOT	AREA	ZONE
201600 00-01204	121.5 AC	EVU-UR
201600 00-01205	11.4 AC	EVU-UR
201600 00-01212	20.1 AC	EVU-UR
201600 00-01213	19.9 AC	EVU-UR

WATER SUPPLY: BEND-DA PINE
SCHOOL DISTRICT: BEND-DA PINE
TELEPHONE SERVICE: BEND-DA PINE
IRIGATION DISTRICT: BEND-DA PINE

PROPOSED AREA OF USE: APPROX 100 ACRES

REQUIRED LANDSCAPE: 50 AC (50%)

PROPOSED LANDSCAPE: 5 AC (5%)

TOTAL LANDSCAPE: 55 AC (55%)

REQUIREMENT OF 40 PARKING SPACES REQUIRED BY SP-07-32

EXISTING GRAVEL PARKING LOT (T. 1208) 53 SPACES

EXISTING GRAVEL OVERFLOW LOT (T. 1208) 50 SPACES

PROPOSED GRAVEL PARKING LOT (T. 1212) 12 SPACES

FUTURE GRAVEL PARKING LOT (T. 1212) 24 SPACES

TOTAL PROPOSED PARKING 139 SPACES

(NONE OF THE PROPOSED STRUCTURES WILL HAVE THE SPRAWLWILDS)

BUILDING	AREA	HEIGHT	TYPE	OCCUPANCY
BTC CLUBHOUSE	5,040 SF	23'	V-B	A-3
BTC STORAGE	1,800 SF	10'	V-B	S-2
VAULT TOILET (42)	50 SF	8'	V-B	U
VAULT TOILET (42)	50 SF	8'	V-B	U

VICINITY MAP
NOT TO SCALE

LEGEND

- EXISTING GRAVEL SURFACE
- PROPOSED GRAVEL SURFACE
- EXISTING ASPHALT PAVEMENT
- EXISTING GRASS AREA
- PROPOSED GRASS AREA
- PROPOSED EARTHEN BANK

PROPOSED EXPANSION TO GENERATE
APPROXIMATELY 400' x 400' x 2' DEEP WITH
4:1 SIDE SLOPES. STORES WATER
UNTIL IT CAN BE USED FOR IRRIGATION
SHALLOW DEPRESSION FOR DISPOSAL

GRAVEL FOUR
PLACED TYPICAL

PROPOSED TRAINING RANGE FOR THE
DESCHUTES COUNTY SHERIFF DEPARTMENT

PROPOSED MODIFICATION TO THE BEND TRAP CLUB

PROPOSED UNDERGROUND
ELECTRIC LINE

PROPOSED UNDERGROUND
ELECTRIC LINE

10/14/09

1/1

10/14/09

10/14/09

