

| Map Legend | |
|-------------------------------|-------------------|
| Map Symbols | ⊗ Valve |
| --- | --- Pipeline |
| --- | --- Property Line |
| Water Right Certificate | |
| | C-81340 |
| | Transfer To |
| | Transfer From |
| East Fork Irrigation District | |
| Hood River, Oregon | |
| Section 1N-10E-15A | |
| Scale 1" = 200' cms | |
| | |

Revised 9C
9/22/2008

RECEIVED

NOV 02 2009
WATER RESOURCES DEPT
SALEM, OREGON

01N10E15A

9-1-08
PLAT

4

mt
Pipeline

10972

SEE MAP 01N 10E 14

1/4 COR.

SEE MAP 01N 10E 15

CEN. SEC.

SEE MAP 01N 10E 16

SEE MAP 01N 10E 14

| |
|--------------------------------|
| Map Legend |
| Map Symbols |
| ⊗ Valve |
| --- Pipeline |
| --- Property Line |
| Water Right Certificate |
| C-81340 |
| ☐ Transfer To |
| ① Transfer From |
| East Fork Irrigation District |
| Hood River, Oregon |
| Section 1N-10E-15 |
| Scale 1" = 400' cms |
| 0 200 400 |


RECEIVED

NOV 02 2009

WATER RESOURCES DEPT
SALEM, OREGON

Revised RA
11/10/2008

01N10E15

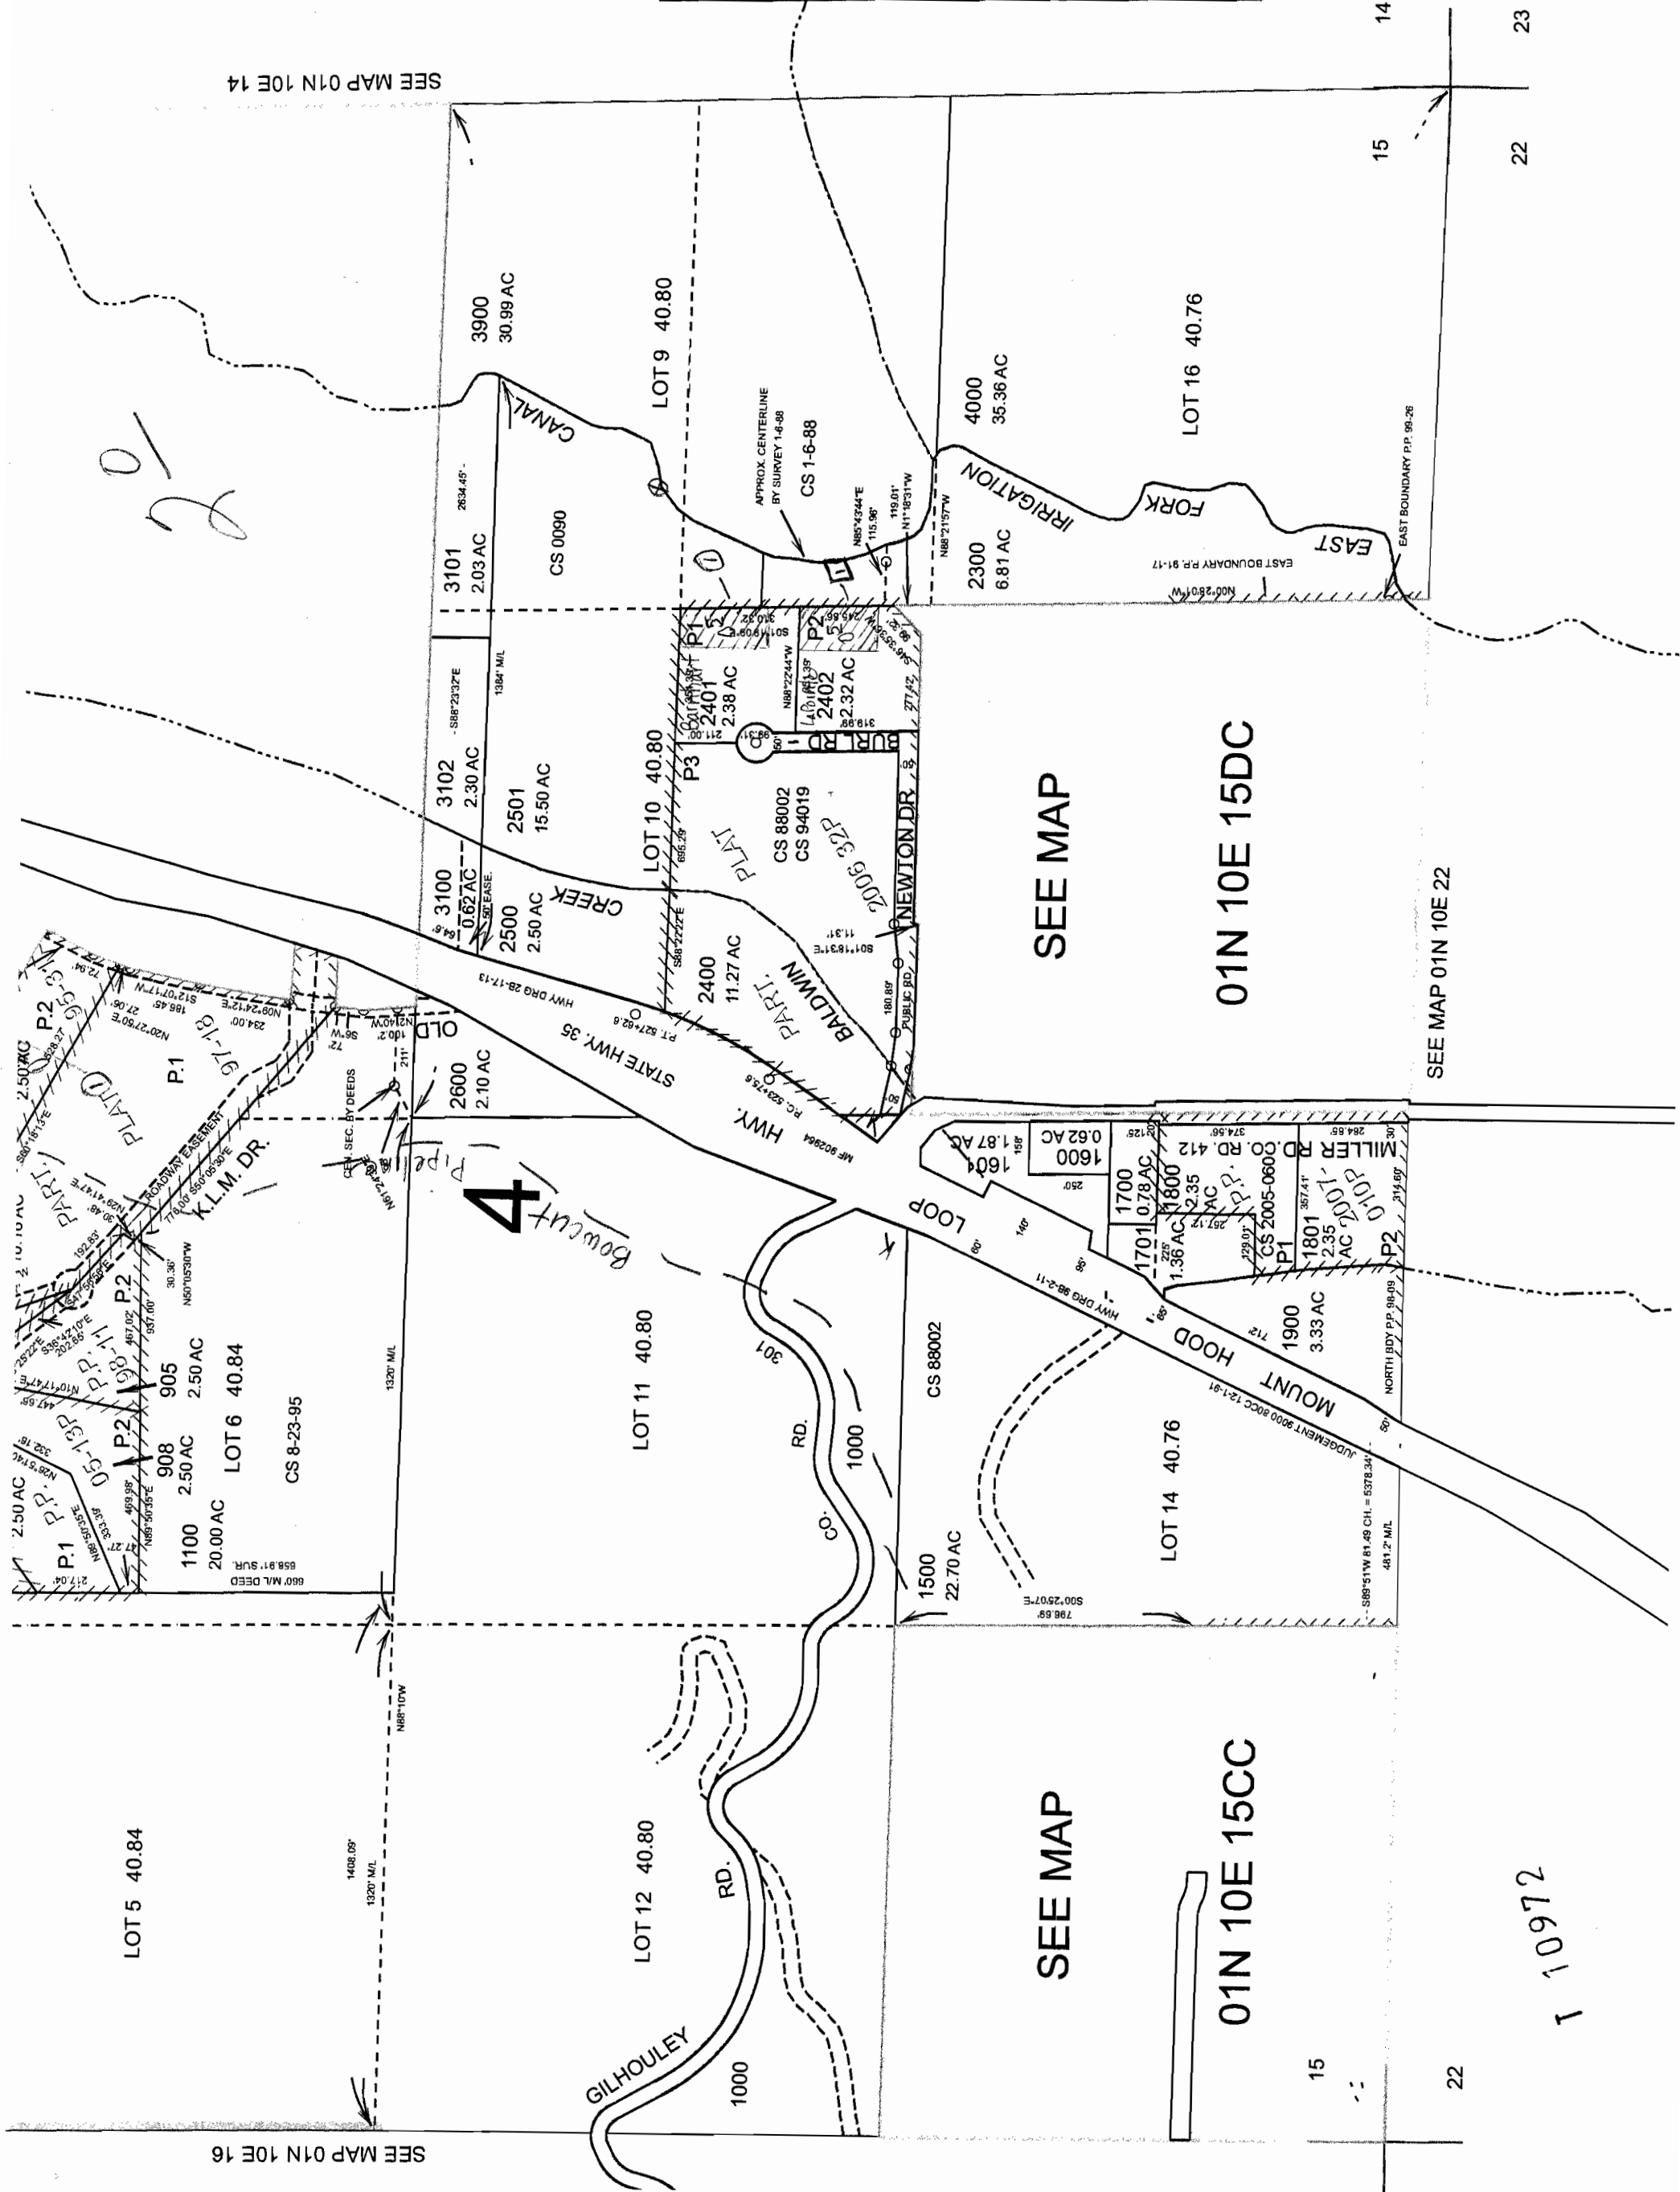

SEE MAP

01N 10E 15DC

SEE MAP

01N 10E 15CC

SEE MAP 01N 10E 22

1 10972