


NOTE: THE PREPARATION OF THIS MAP WAS FOR THE PURPOSE OF IDENTIFYING THE LOCATION OF THE PROPOSED WATER RIGHT, AND HAS NO INTENT TO PROVIDE DIMENSIONS OR LOCATIONS OF PROPERTY OWNERSHIP LINES.




SCALE: 1" = 1320'

LEGEND
 PIPELINE ———
 FOUND BRASS CAP MONUMENT
 POD POINT OF DIVERSION

POD - 1270' S. & 40' E OF THE NE COR SEC. 31

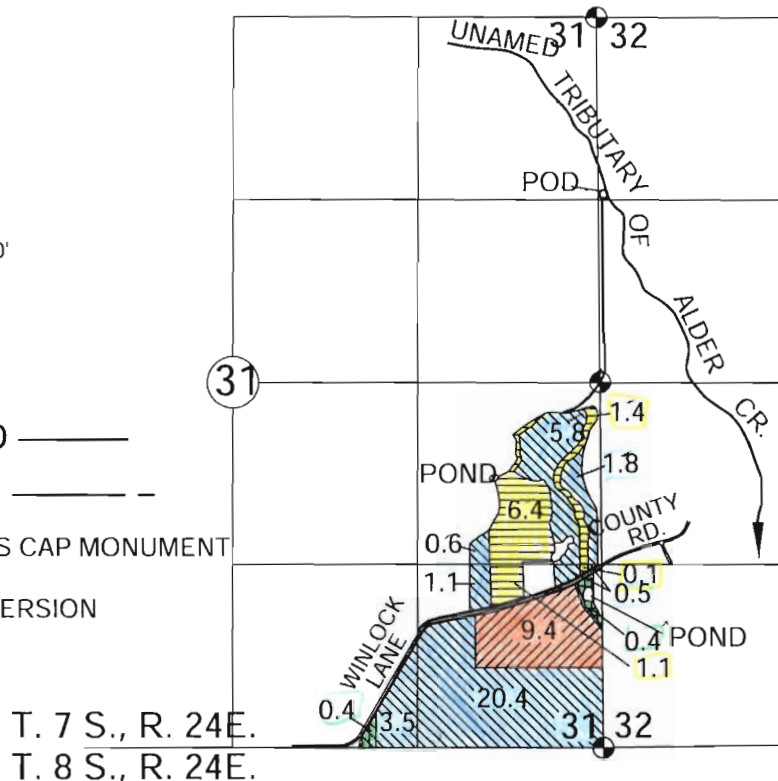

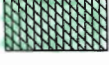
-  9.4 AC. FROM C54724 (1894)
-  9.0 AC. TO C54724 (1894)
-  0.4 AC. TO C54724 (1894)
-  9.0 AC. FROM C82920 (1979)
-  0.4 AC. FROM C82920 (1979)
-  9.4 AC. TO C82920 (1979)
-  33.7 AC. TO BE LEASED INSTREAM

Application Map
 for
 Water Right Transfer

T- 10804 *10803*

Proposed change in Place of Use
 for
 Dorothy Roberta Hofier Vandehey

by

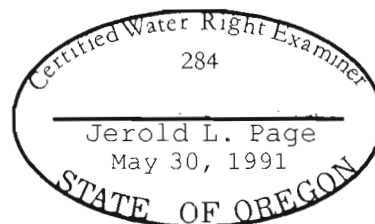

RENEW 12-31-10