

TRANSFER "TO" MAP AND
APPLICATION MAP FOR SECONDARY USES
SECTION 28 , 29, T5S, R4W, WM
YAMHILL COUNTY, OREGON
WILLAMETTE RIVER BASIN



PREPARED FOR:
DeRaeve Family, LLC
Tract known as "Robison Farm"


New SECONDARY irrigation acres				
DLC #	Section	prior cert.	Qtr-Qtr	acres
45	28	39478	NW-NW	24.24
45	28	39478	NE-NW	4.36
45	28	39478	SW-NW	18.48
45	28	39478	SE-NW	3.62
45	28	24281	SW-NW	21.52
45	28	24281	SE-NW	2.91
45	28	24281	NW-SW	29.22
45	28	24281	NE-SW	4.46
<hr/>				
45	29	39478	NE-NE	2.55
45	29	47240	NE-NE	2.35
45	29	39478	SE-NE	6.33
45	29	24281	SE-NE	7.19
45	29	24281	NE-SE	13.73
45	29	none	NE-SE	2.85
45	29	none	SE-SE	0.19
Total irrigation acres				144.00

POD #2 = DAM FOR
RAEVENBROOK RESERVOIR. AND
ADDITIONAL POD FOR
SECONDARY USES.

SECONDARY IRRIGATION LEGEND

	IRRIGATION NO CURRENT CERT
	IRRIGATION ALSO PER CERT 24281
	IRRIGATION ALSO PER CERT. 39478 AND 39484
	IRRIGATION ALSO PER CERT. 47240

APPROXIMATE
PROPERTY LINE,
BOLD

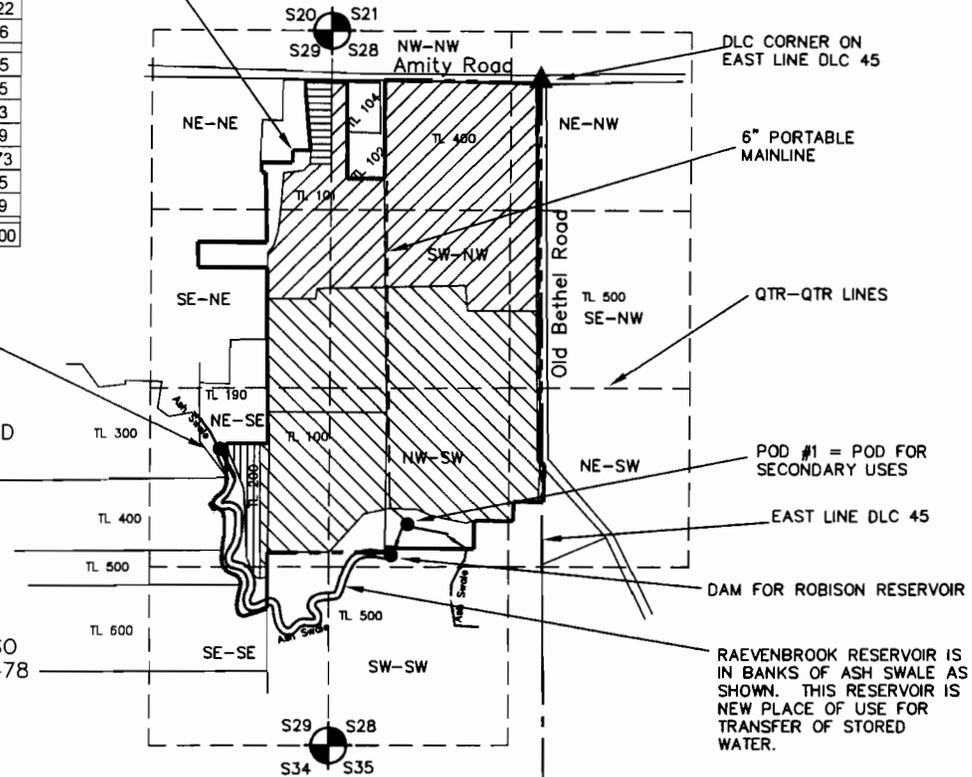

DLC CORNER ON
EAST LINE DLC 45

6" PORTABLE
MAINLINE

QTR-QTR LINES

POD #1 = POD FOR
SECONDARY USES

EAST LINE DLC 45

DAM FOR ROBISON RESERVOIR

RAEVENBROOK RESERVOIR IS
IN BANKS OF ASH SWALE AS
SHOWN. THIS RESERVOIR IS
NEW PLACE OF USE FOR
TRANSFER OF STORED
WATER.

- SECTION CORNER AND
MAP SCALE POINT
- DLC CORNER
- EXISTING MAIN
IRRIGATION PIPES
- POD; COORDINATES AS FOLLOWS:
● POD #1 1640' N, 580' E;
● DAM/POD #2 2190 N, 810 W;
OF THE SW CORNER OF S28


NOTE: POD COORDINATES AND
IRRIGATION ACRES VARY FROM PRIOR
MAPS. THIS IS BECAUSE OF BETTER
AERIAL PHOTOS, MAPPING ACCURACY,
AND CHANGES IN OWNERSHIP.



EXPIRES 6/30/2008



Project: 306-2-022
Drawing: 3062022H.dwg
By: EAU
Checked by: EAU & SCHWABE
Date: NOV 2009

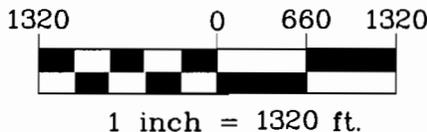


MAP BASE:
YAMHILL COUNTY TAX MAPS 28&29 T5S,
R4W AND AUG 2004 GOOGLE AERIAL
PHOTO

T 10977

NOV 16 2009

"FROM" MAP

T.6S.,R.4W.,W.M.

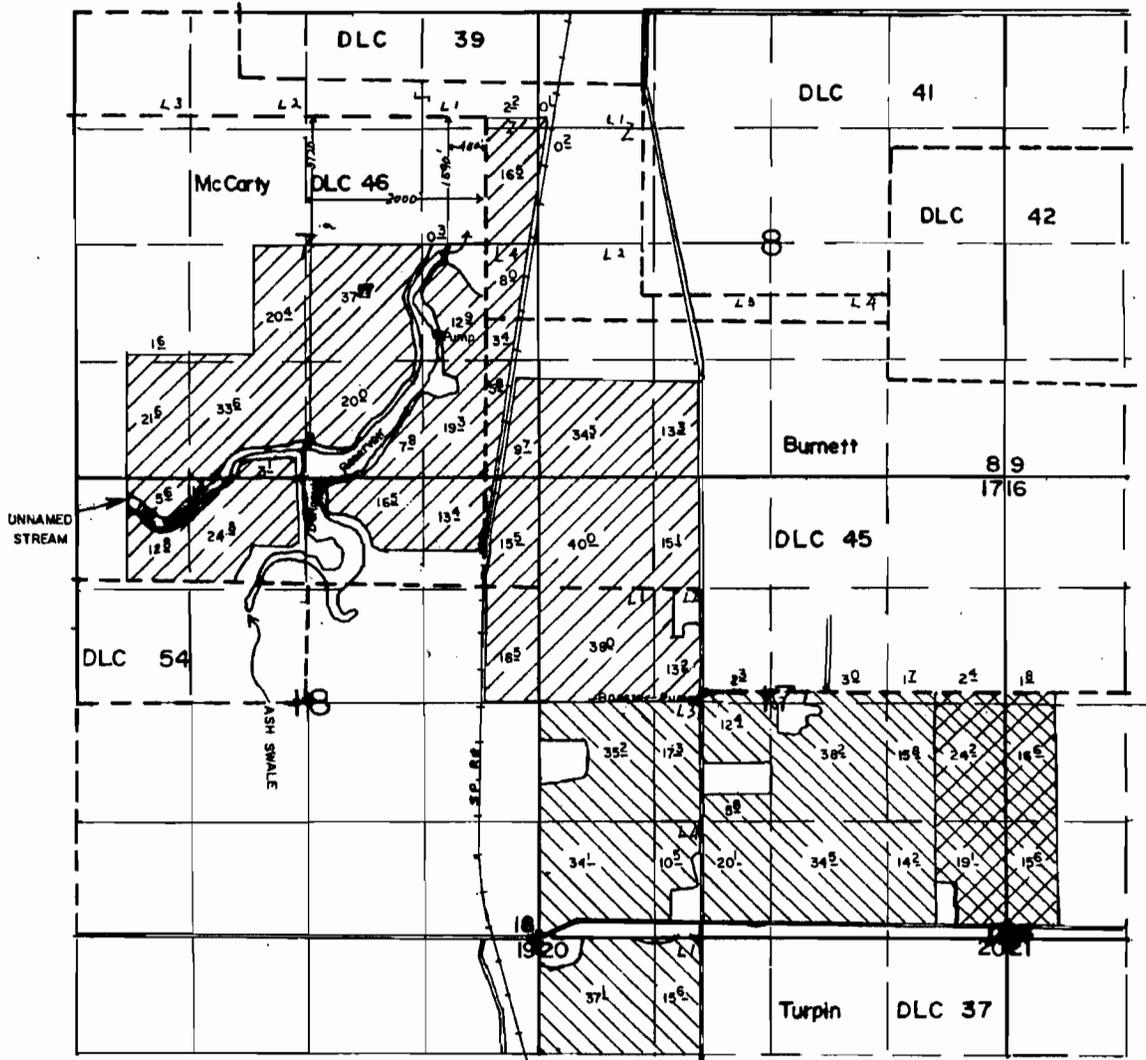

FINAL PROOF SURVEY UNDER

R-54226 R-6487
 54227 40684
 R-67984 R-10482
 67985 49361

Application No. 2899..... Permit No. 4958.....

IN NAME OF

Marvin John & Patricia Ann DeRaeve..

Surveyed MAY...18....1999 By J.M. WARREN.....

	Permit 40684 Primary
	Permit 49361 Supplemental
	Permit 46958 Primary

NOV 16 2009

T 10977

11-2-06 SWG

Langford, Shonee D.

From: Eric Urstadt [ericurstadt@stuntzner.com]
Sent: Thursday, October 08, 2009 9:43 AM
To: Langford, Shonee D.
Cc: Pagel, Martha
Subject: Fw: DeRaeve T-fer - Use cert map for From map request

----- Original Message -----

From: Kelly Starnes
To: Eric Urstadt
Sent: Thursday, October 08, 2009 9:18 AM
Subject: RE: DeRaeve T-fer - Use cert map for From map request

Eric -

Yes, you can use the final proof map as the "from" map per OAR 690-380-3100(1)(j).

Please include a copy of this e-mail with the transfer application.

Kelly

From: Eric Urstadt [mailto:ericurstadt@stuntzner.com]
Sent: Thursday, October 08, 2009 8:58 AM
To: Kelly Starnes
Subject: Fw: DeRaeve T-fer - Use cert map for From map request

----- Original Message -----

From: Eric Urstadt
To: Kelly Starnes
Cc: Langford, Shonee D. ; Martha Pagel
Sent: Wednesday, October 07, 2009 12:03 PM
Subject: DeRaeve T-fer - Use cert map for From map request

Kelly,
Per our conversation today. We plan to transfer some water from DeRaeve Reservoir in cert. 83204 to a dam location downstream and also in Ash Swale.

May I please use the Final Proof Map from that cert as the "From Map" for that transfer?

Eric Urstadt, PE, PLS
Stuntzner Engineering & Forestry, LLC
2137 19th Ave., Forest Grove, OR 97116
503-357-5717(office)
503-357-5698(fax)
503-312-3931(cell)

T 10977

RECEIVED

NOV 16 2009

10/8/2009