

MARI 62761

STATE OF OREGON
WATER SUPPLY WELL REPORT
 (as required by ORS 537.765 & OAR 690-205-0210)

WELL LABEL # L 100524

START CARD # 204894

(1) LAND OWNER Owner Well I.D. _____
 First Name Myron Last Name Kuenzi
 Company _____
 Address 6500 State Street
 City Salem State OR Zip 97301

(2) TYPE OF WORK New Well Deepening Conversion
 Alteration (repair/recondition) Abandonment

(3) DRILL METHOD
 Rotary Air Rotary Mud Cable Auger Cable Mud
 Reverse Rotary Other _____

(4) PROPOSED USE Domestic Irrigation Community
 Industrial/ Commercial Livestock Dewatering
 Thermal Injection Other _____

(5) BORE HOLE CONSTRUCTION Special Standard (Attach copy)
 Depth of Completed Well 220 ft.

BORE HOLE			SEAL			sacks/	
Dia	From	To	Material	From	To	Amt	lbs
14	0	22	Cement	0	38	24	S
12	22	38					
9.62	38	201					
6.5	201	220					

How was seal placed: Method A B C D E

Backfill placed from 38 ft. to 54 ft. Material Cement 3 Sacks
 Filter pack from _____ ft. to _____ ft. Material _____ Size _____

Explosives used: Yes Type _____ Amount _____

(6) CASING/LINER

Casing	Liner	Dia	+	From	To	Gauge	Stl	Plstc	Wld	Thrd
<input checked="" type="checkbox"/>	<input type="checkbox"/>	8	<input checked="" type="checkbox"/>	2	201	.250	<input checked="" type="checkbox"/>	<input type="checkbox"/>	<input checked="" type="checkbox"/>	<input type="checkbox"/>
<input type="checkbox"/>	<input type="checkbox"/>		<input type="checkbox"/>				<input type="checkbox"/>	<input type="checkbox"/>	<input type="checkbox"/>	<input type="checkbox"/>
Shoe Inside Outside Other Location of shoe(s) 201

Temp casing Yes Dia _____ From _____ To _____

(7) PERFORATIONS/SCREENS
 Perforations Method Holte
 Screens Type _____ Material _____

Perf/S	Casing/	Screen	Dia	From	To	Scm/slot	Slot	# of	Tele/
green	liner					width	length	slots	pipe size
Perf	Casing		8	150	170	.2	1	1,000	
Perf	Casing		8	180	190	.2	1	400	

(8) WELL TESTS: Minimum testing time is 1 hour

	Yield gal/min	Drawdown	Drill stem/Pump depth	Duration (hr)
<input type="radio"/> Pump	300		200	6
<input type="radio"/> Bailer				
<input checked="" type="radio"/> Air				
<input type="radio"/> Flowing Artesian				

Temperature 54 +/- °F Lab analysis Yes By _____
 Water quality concerns? Yes (describe below)

From	To	Description	Amount	Units

(9) LOCATION OF WELL (legal description)
 County MARION Twp 7 S N/S Range 2 W E/W WM
 Sec 27 SE 1/4 of the SW 1/4 Tax Lot 900
 Tax Map Number _____ Lot _____
 Lat _____ " or _____ DMS or DD
 Long _____ " or _____ DMS or DD
 Street address of well Nearest address

6955 State Street Salem OR

(10) STATIC WATER LEVEL Date _____ SWL(psi) _____ + SWL(ft) _____
 Existing Well / Predeepening _____
 Completed Well 11-05-2009 _____ + 53
 Flowing Artesian? Dry Hole?

WATER BEARING ZONES Depth water was first found 19

SWL Date	From	To	Est Flow	SWL(psi)	+ SWL(ft)
10-27-2009	19	26			7
11-05-2009	54	218	300		53

(11) WELL LOG Ground Elevation _____

Material	From	To
Top soil	0	3
Silty brown clay	3	14
Brown clay	14	19
Tan clay and medium to large gravel	19	25
Sand with tan and brown clay and gravel	25	26
Brown and tan clay firm	26	54
Tight brown and gray sandy gravel	54	115
Sandy brown clay and large gravel	115	124
Black sand and gravel (ash) muddy water	124	143
Sandy brown clay and gravel muddy water	143	157
Loose brown and gray sand and gravel	157	162
Tight brown and gray gravel	162	166
Porous basalt chips with soft sandy clay seams	166	172
Gray and brown clay very sandy with large gravel	172	186
Dark brown basalt with blue gray clay some gravel	186	200
Very weathered brown basalt	200	218
Dark gray basalt	218	220

Date Started 10-26-2009 Completed 11-05-2009

(unbonded) Water Well Constructor Certification
 I certify that the work I performed on the construction, deepening, alteration, or abandonment of this well is in compliance with Oregon water supply well construction standards. Materials used and information reported above are true to the best of my knowledge and belief.

License Number 1629 Date 11-09-2009
 Password: (if filing electronically) _____
 Signed _____

(bonded) Water Well Constructor Certification
 I accept responsibility for the construction, deepening, alteration, or abandonment work performed on this well during the construction dates reported above. All work performed during this time is in compliance with Oregon water supply well construction standards. This report is true to the best of my knowledge and belief.

License Number 1273 Date 11-09-2009
 Password: (if filing electronically) _____
 Signed Flood Sippe
 Contact Info (optional) _____

RECEIVED

STATE OF OREGON
WATER SUPPLY WELL REPORT
 (as required by ORS 537.765 & OAR 690-205-0210)

WELL LABEL # L 100524
 START CARD # 204894

(1) LAND OWNER Owner Well I.D. _____
 First Name Myron Last Name Kuenzi
 Company _____
 Address 6500 State Street
 City Salem State OR Zip 97301

(2) TYPE OF WORK New Well Deepening Conversion
 Alteration (repair/recondition) Abandonment

(3) DRILL METHOD
 Rotary Air Rotary Mud Cable Auger Cable Mud
 Reverse Rotary Other _____

(4) PROPOSED USE Domestic Irrigation Community
 Industrial/ Commercial Livestock Dewatering
 Thermal Injection Other _____

(5) BORE HOLE CONSTRUCTION Special Standard Attach copy)
 Depth of Completed Well 220 ft.

BORE HOLE			SEAL				sacks/	
Dia	From	To	Material	From	To	Amt	lbs	
14	0	22	Cement	0	38	24	S	
12	22	38						
9.62	38	201						
6.5	201	220						

How was seal placed: Method A B C D E
 Other _____
 Backfill placed from 38 ft. to 54 ft. Material Cement 3 Sacks
 Filter pack from _____ ft. to _____ ft. Material _____ Size _____
 Explosives used: Yes Type _____ Amount _____

(6) CASING/LINER

Casing	Liner	Dia	From	To	Gauge	Stl	Pisc	Wld	Thrd
<input checked="" type="checkbox"/>	<input checked="" type="checkbox"/>	8	2	201	.250	<input checked="" type="checkbox"/>	<input checked="" type="checkbox"/>	<input checked="" type="checkbox"/>	<input type="checkbox"/>
<input type="checkbox"/>	<input type="checkbox"/>					<input type="checkbox"/>	<input type="checkbox"/>	<input type="checkbox"/>	<input type="checkbox"/>
Shoe Inside Outside Other Location of shoe(s) 201
 Temp casing Yes Dia _____ From _____ To _____

(7) PERFORATIONS/SCREENS

Perforations Method Holte
 Screens Type _____ Material _____

Perf/S	Casing/Screen	Liner	Dia	From	To	Scrn/slot width	Slot length	# of slots	Tele/pipe size
Perf	Casing		8	150	170	.2	1	1,000	
Perf	Casing		8	180	190	.2	1	400	

(8) WELL TESTS: Minimum testing time is 1 hour
 Pump Bailer Air Flowing Artesian
 Yield gal/min Drawdown Drill stem/Pump depth Duration (hr)

300		200	6

Temperature 54 +/- °F Lab analysis Yes By _____
 Water quality concerns? Yes (describe below)

From	To	Description	Amount	Units

(9) LOCATION OF WELL (legal description)
 County MARION Twp 7 S N/S Range 2 W E/W WM
 Sec 27 SE 1/4 of the SW 1/4 Tax Lot 900
 Tax Map Number _____ Lot _____
 Lat _____ " or _____ DMS or DD
 Long _____ " or _____ DMS or DD
 Street address of well Nearest address
6955 State Street Salem OR

(10) STATIC WATER LEVEL Date _____ SWL(psi) + SWL(ft)

Existing Well / Predeepening		
Completed Well	11-05-2009	53

 Flowing Artesian? Dry Hole?

WATER BEARING ZONES Depth water was first found 19

SWL Date	From	To	Est Flow	SWL (psi)	+ SWL (ft)
10-27-2009	19	26			7
11-05-2009	54	218	300		53

(11) WELL LOG Ground Elevation _____

Material	From	To
Top soil	0	3
Silty brown clay	3	14
Brown clay	14	19
Tan clay and medium to large gravel	19	25
Sand with tan and brown clay and gravel	25	26
Brown and tan clay firm	26	54
Tight brown and gray sandy gravel	54	115
Sandy brown clay and large gravel	115	124
Black sand and gravel (ash) muddy water	124	143
Sandy brown clay and gravel muddy water	143	157
Loose brown and gray sand and gravel	157	162
Tight brown and gray gravel	162	166
Porous basalt chips with soft sandy clay seams	166	172
Gray and brown clay very sandy with large gravel	172	186
Dark brown basalt with blue gray clay some gravel	186	200
Very weathered brown basalt	200	218
Dark gray basalt	218	220

Date Started 10-26-2009 Completed 11-05-2009
(unbonded) Water Well Constructor Certification
 I certify that the work I performed on the construction, deepening, alteration, or abandonment of this well is in compliance with Oregon water supply well construction standards. Materials used and information reported above are true to the best of my knowledge and belief.
 License Number 1629 Date 11-09-2009
 Password: (if filing electronically) _____
 Signed _____

(bonded) Water Well Constructor Certification
 I accept responsibility for the construction, deepening, alteration, or abandonment work performed on this well during the construction dates reported above. All work performed during this time is in compliance with Oregon water supply well construction standards. This report is true to the best of my knowledge and belief.
 License Number 1273 Date 11-09-2009
 Password: (if filing electronically) _____
 Signed Flora Suppe
 Contact info (optional) _____

T 10980

STATE ENGINEER
Salem, Oregon

8111
MARK

Well Record

STATE WELL NO. 7/3W-27P(1)
COUNTY Marion
APPLICATION NO. GR-990

GR- 959

OWNER: Henry L. Bahnsen


MAILING ADDRESS: Rt. 5, Box 756

LOCATION OF WELL: Owner's No.

CITY AND STATE: Salem, Oregon

SE 1/4 SW 1/4 Sec. 27 T. 7 S., R. 3 W., W.M.

Bearing and distance from section or subdivision corner 2300' E. & 600' N. from SW cor. Sec. 27.

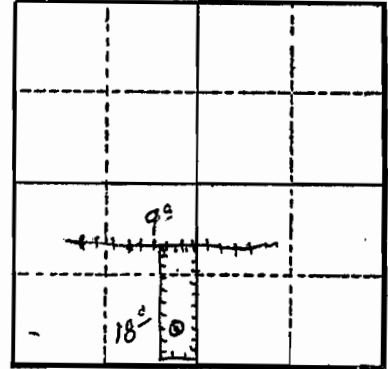

Section 27

Altitude at well 200 ft.

TYPE OF WELL: Drilled Date Constructed 1951

Depth drilled 100 ft. Depth cased 100 ft.

CASING RECORD:

8 inch

FINISH:

Perforations ??

AQUIFERS:

WATER LEVEL:

PUMPING EQUIPMENT: Type Jacuzzi Turbine H.P. 3

Capacity 110 G.P.M.

WELL TESTS:

Drawdown ft. after hours G.P.M.

Drawdown ft. after hours G.P.M.

USE OF WATER Irrigation Temp. °F. 19

SOURCE OF INFORMATION G.R. Record

DRILLER or DIGGER

ADDITIONAL DATA:

Log Water Level Measurements Chemical Analysis Aquifer Test

REMARKS:

Irrigation of 27 acres.

NOV 19 2009

T 10980

LEGEND

LINE TYPES

- TAX LOT BOUNDARY
- OLD PROPERTY LINE
- RAILROAD
- RAILROAD RIGHT-OF-WAY
- STRETA LANE, ETC.
- STRETA LANE, ETC. NOT-BOUNDARY
- TAX LOT BOUNDARY
- RAILROAD RIGHT-OF-WAY
- SUBDIVISION BOUNDARY
- PAVEMENT PLAT BOT.
- TAX CORNER BOUNDARY
- BASEMENT

SYMBOL TYPES

- DLL
- CONTROL POINTS
- SURVEY MONUMENTS
- CLA CORNERS
- SECTION
- 1/4 SEC.
- 1/4 COR.
- 1/8 SEC.
- 1/8 COR.

NUMBERS

TAX COR. NO.
000 00 00 0

ABSTRACT - ALL ABSTRACTS ENCLURE ANY PORTION THAT MAY LIE WITHIN THE INDICATED PUBLIC RIGHT OF WAY.

TICK MARKS - WHEN A TICK MARK IS INDICATED ON THE EXTENSION OF A LINE, THEN THE DIMENSION DOES TO THE TICK MARK GENERALLY THIS IS USED WHEN DIMENSIONS GO INTO PUBLIC RIGHT OF WAY.

ADJUSTS ARE USED WITH DIMENSIONS IN ABSTRACT OF CREATOR'S COMPETENCY.

NOTICE: This map was created for Assessor's Office use ONLY.



SCALE 1" = 400'
of 1:4000
Plot file created: July 26, 2007
Assessor's Office

