


Township 7S Range 2W W.M.
North

↑
North

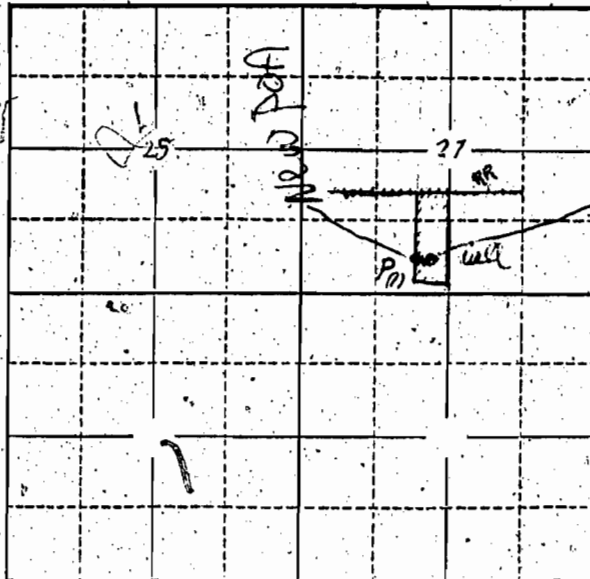

NOV 19 2009

STATE OF OREGON

County of Marion } ss.

I, _____, being first duly sworn, do hereby certify that I have read the foregoing Registration Statement and that all of the items therein contained are true to the best of my knowledge and belief.

Henry L. Bahnsen
(Signature of Registrant)

Subscribed and sworn to before me this 10th day of February, 1958

My commission expires 12th June 1961 Wm. S. Bartholomew
(Notary Public)

(SEAL)

CERTIFICATE OF REGISTRATION

STATE OF OREGON

County of Marion } ss.

This is to certify that the foregoing Registration Statement was received in the office of the State Engineer on the 10 day of February, 1958 at 8:00 o'clock AM and has been duly recorded in said office in Book No. 5 of Registration Statements on page 959.

Witness my hand this 28 day of May, 1958

Lewis A. Stanley
(State Engineer)

By _____
(Deputy)

J 10980

GR - 959.C

GR Mod Appl Map

LEGEND

LINE TYPES

- TAX LOT BOUNDARY OLD PROPERTY LINE
- ROAD RIGHT-OF-WAY VACATED RIGHT-OF-WAY
- RAILROAD RAILROAD RIGHT-OF-WAY
- STREAM, LAKE, ETC. STREAM, LAKE, ETC.
- TAX LOT BOUNDARY NON-BOUNDARY
- SUBDIVISION BOUNDARY PARTITION PLAT BUY.
- TAX CODE BOUNDARY EASEMENT

SYMBOL TYPES


- D.L.C.
- CONTROL POINTS
- SURVEY MONUMENTS
- C.L.O. CORNERS
- SECTION 1/4 SEC 1/16 SEC

NUMBERS

TAX CODE NO.
000 00 00 0

ACREAGE - ALL ACREAGES EXCLUDE ANY PORTION THAT MAY LIE WITHIN THE INDICATED PUBLIC RIGHT OF WAYS.

TICK MARKS - WHEN A TICK MARK IS INDICATED ON THE EXTENSION OF A LINE, THEN THE DIMENSION GOES TO THE TICK MARK. GENERALLY THIS IS USED WHEN DIMENSIONS GO INTO PUBLIC RIGHT OF WAYS.

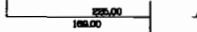

ARROWS ARE USED WITH DIMENSIONS IN AREAS OF GREATER COMPLEXITY.

NOTICE: This map was created for Assessor's Office use ONLY.



SCALE 1" = 400'
or 1:4800

Plot file created: July 26, 2007
Asstmap072w27 of wkbook1

