


1.6 ac Authorized place use 4.4 ac 1.2 ac

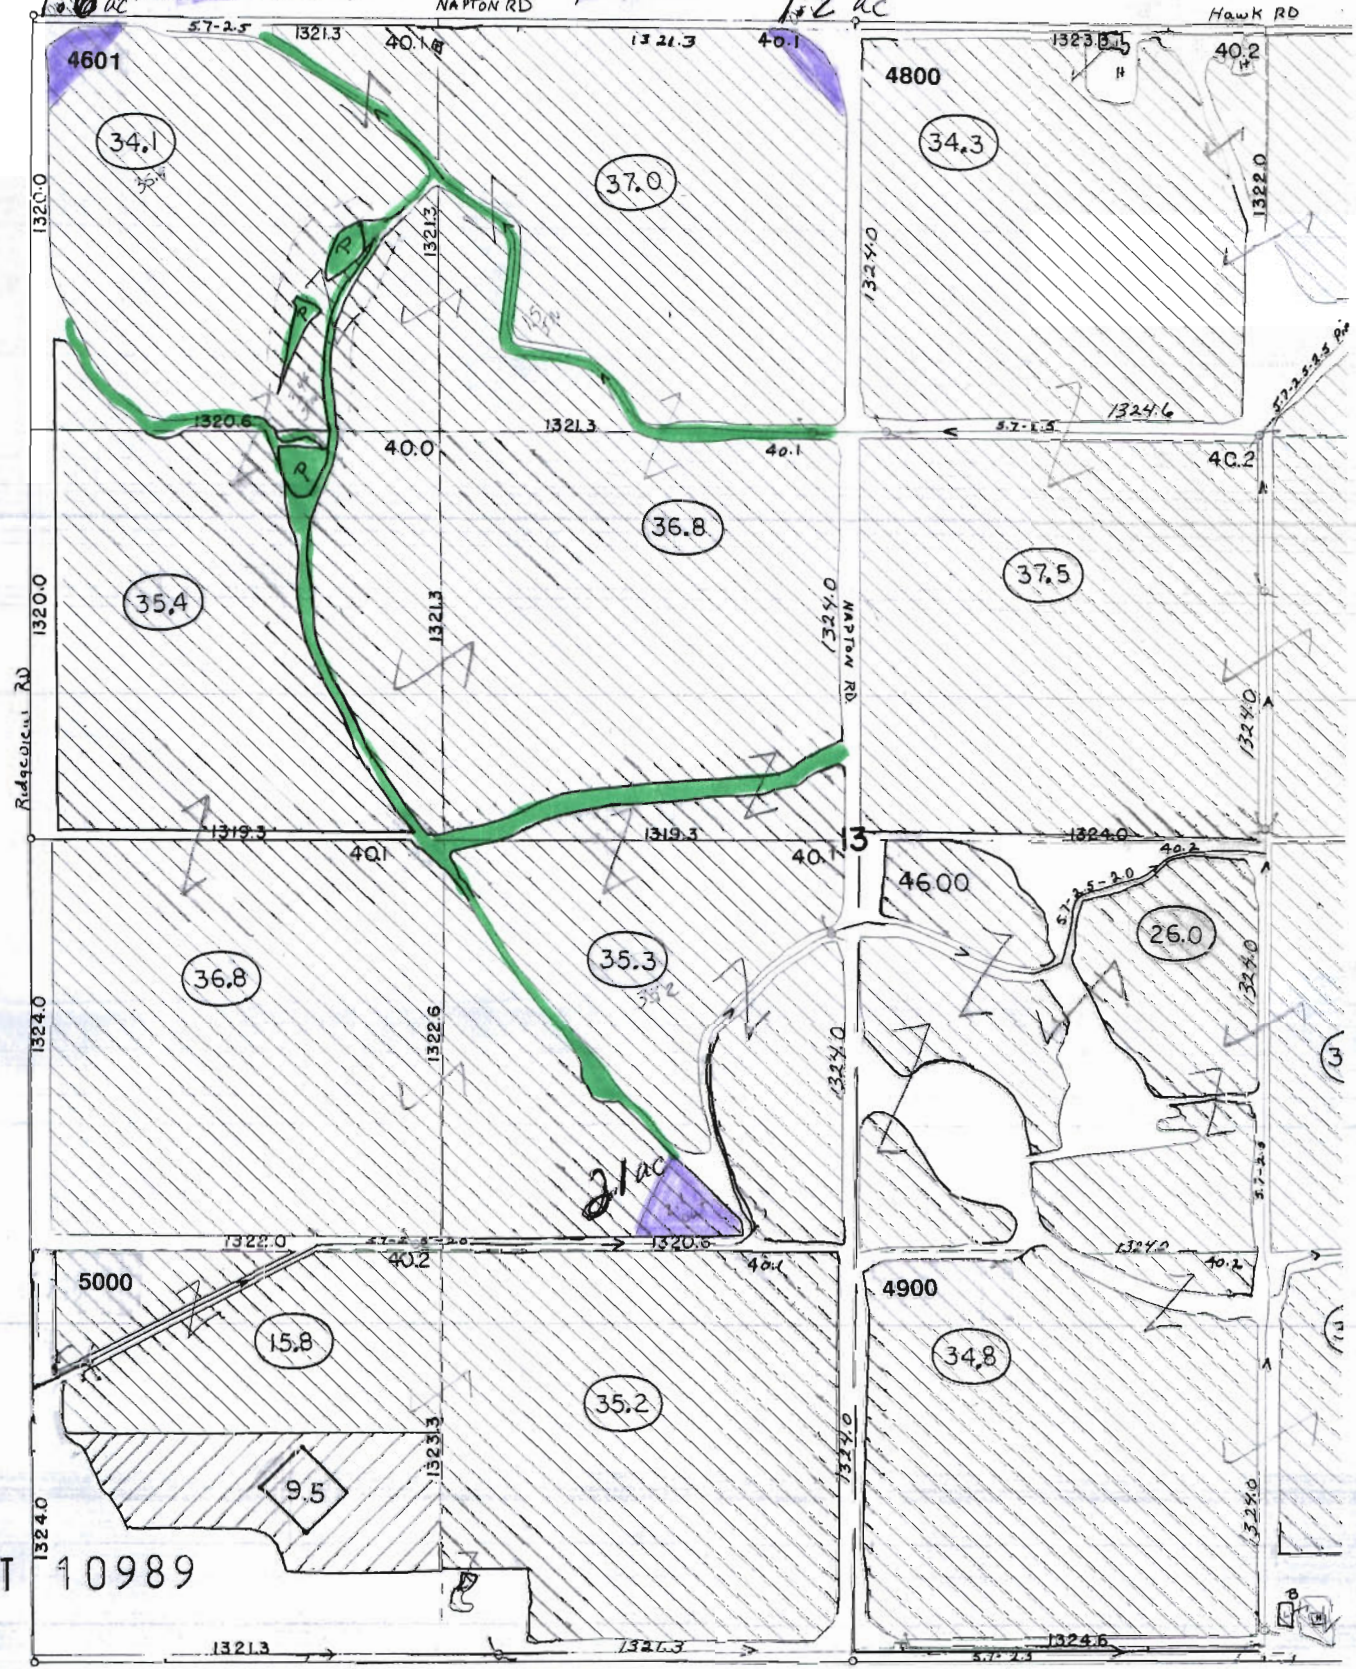

Proposed place of use 4.9 ac

SEC. 13, T.22 S., 46E

Traced: R.W.R. 4-17-53  
Checked: R.F. 6-20-55

Garold Johnston


**RECEIVED**  
DEC 14 2009  
WATER RESOURCES DEPT  
SALEM, OREGON



Authorized place of use

Proposed place of use

Errors in property  
line  
Should be  $\frac{16.6}{14.5}$

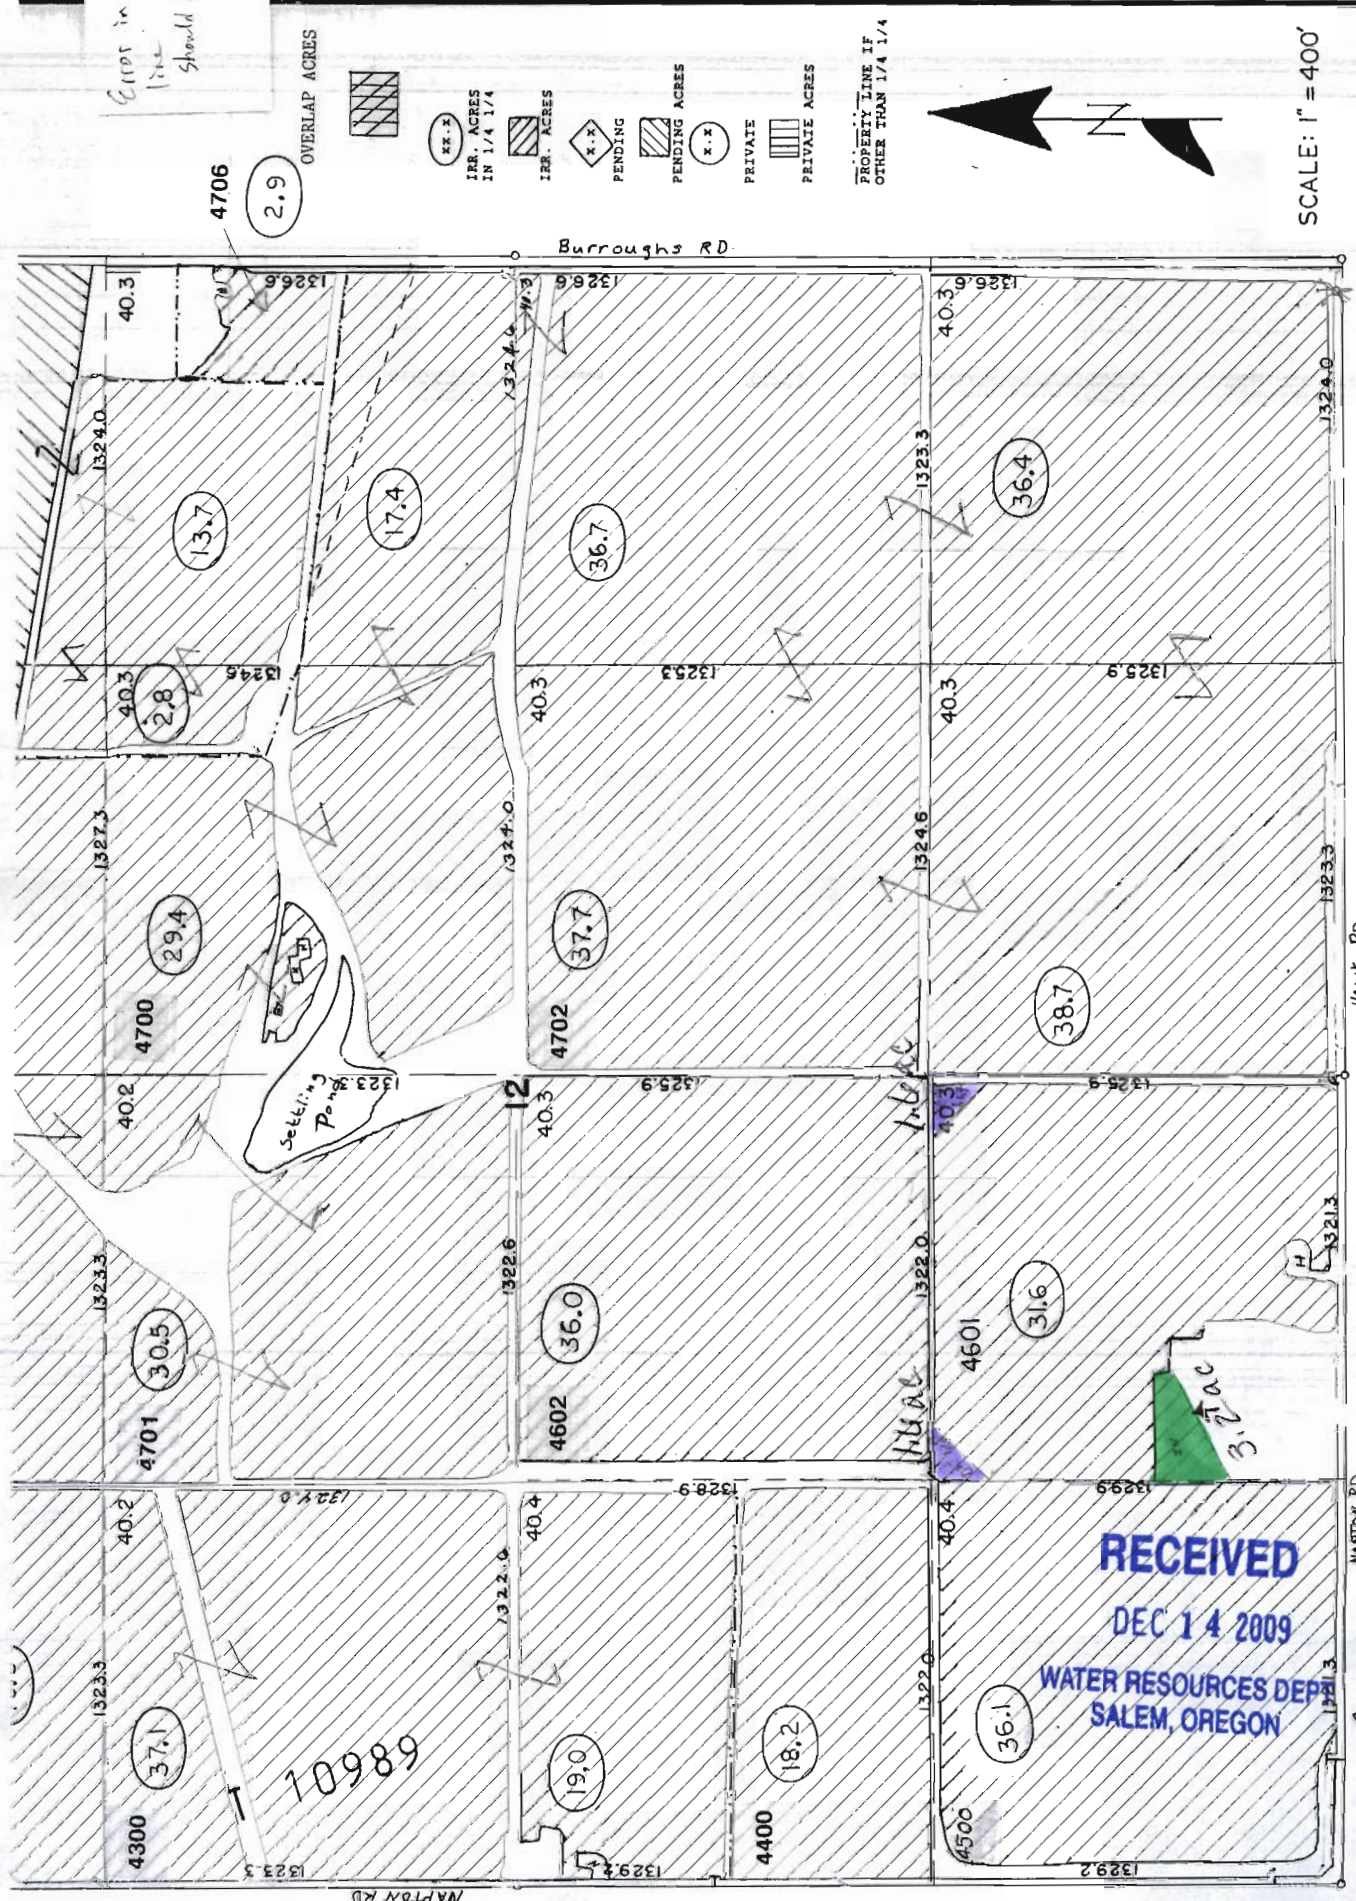

RECEIVED  
DEC 14 2009  
WATER RESOURCES DEPT  
SALEM, OREGON

Gardol Johnston

SEC. 12, T.22 S., R.46 E., W.M.

48-102-15-60

SCALE: 1" = 400'