

STATE ENGINEER
Salem, Oregon

WASH Well Record
012375

STATE WELL NO. *2761 116*
COUNTY *WASCO*
APPLICATION NO. *GE 2*

OWNER: *Blairly Brothers*

MAILING ADDRESS:
CITY AND STATE:

Pg 1 of 4

LOCATION OF WELL: Owner's No. _____

NE 1/4 SE 1/4 Sec. 1 T. 2 N. S. R. 2 W. W.M.

Bearing and distance from section or subdivision


corner _____

Altitude at well *285 ft.*

TYPE OF WELL: *drilled* Date Constructed _____

Depth drilled *588 ft.* Depth cased *57 ft.*

CASING RECORD: *2 inch.*

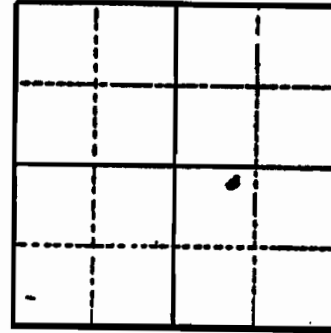

Section _____

FINISH:

RECEIVED

DEC 14 2009

AQUIFERS: *Basalt from 365 to 588 ft.*

WATER RESOURCES DEPT
SALEM, OREGON

WATER LEVEL: *112.0 ft. below land surface. 9-29-51*

PUMPING EQUIPMENT: Type *Turbine* H.P. _____
Capacity _____ G.P.M.

WELL TESTS:
Drawdown _____ ft. after _____ hours _____ G.P.M.
Drawdown _____ ft. after _____ hours _____ G.P.M.

USE OF WATER *Irrigation* Temp. _____ °F. _____ 19 _____

SOURCE OF INFORMATION *U.S.G.S.*

DRILLER or DIGGER _____

ADDITIONAL DATA:
Log Water Level Measurements _____ Chemical Analysis _____ Aquifer Test _____

REMARKS: *Used for irrigating 50 acres. of pasture; see table 2 for log; pumped at rate of 588 gpm. with 45 ft. of drawdown for 4 hours during aquifer test by U.S.G.S.*

T 10991

STATE ENGINEER
Salem, Oregon

Mar
12375

State Well No. _____
County _____
Application No. _____

Well Log

By 201/04

Owner: Bierly Brothers Owner's No. _____

Driller: A. M. Janssen Drilling Co. Date Drilled 1950

CHARACTER OF MATERIAL	(Feet below land surface)		Thickness (feet)
	From	To	
<u>Soil & Mantle (undifferentiated):</u>			
<u>clay</u>		<u>30</u>	<u>30</u>
<u>Columbia River Basalt:</u>			
<u>Rock</u>		<u>180</u>	<u>150</u>
<u>Rock, gray</u>		<u>217</u>	<u>37</u>
<u>Rock, brown & black</u>		<u>291</u>	<u>74</u>
<u>Rock, hard, & gray</u>		<u>368</u>	<u>77</u>
<u>Rock, soft, black, "lava"</u>		<u>377</u>	<u>20</u>
<u>Rock, brown</u>		<u>440</u>	<u>30</u>
<u>Rock, hard, black</u>		<u>500</u>	<u>30</u>
<u>Rock, brown, "lava"</u>		<u>515</u>	<u>15</u>
<u>Rock, gray</u>		<u>520</u>	<u>10</u>
<u>Rock, brown, "lava"</u>		<u>530</u>	<u>10</u>
<u>Rock, gray</u>		<u>570</u>	<u>39</u>
<u>Rock, black, "lava"</u>		<u>580</u>	<u>10</u>

T 10991

DEC 14 2009
WATER RESOURCES DEPT
SALEM, OREGON

STATE ENGINEER
Salem, Oregon

WASH
012375 Well Record

STATE WELL NO. 2/2N-1J
COUNTY WASHINGTON
APPLICATION NO. GR-295A

OWNER: Orville L. & Hubert F. Hierly MAILING ADDRESS: Rt. 1, Pg 4 of 4

LOCATION OF WELL: Owner's No. _____ CITY AND STATE: Beaverton, Oregon

NE 1/4 SE 1/4 Sec. 1 T. 2 S., R. 2 W., W.M.

Bearing and distance from section or subdivision corner 2840' S. and 1000' W.

Altitude at well _____

TYPE OF WELL: drilled Date Constructed 1950

Depth drilled 590 Depth cased 590

Section _____

CASING RECORD:

12-inch
12-inch
8-inch

FINISH:

AQUIFERS:

WATER LEVEL:

100-feet

PUMPING EQUIPMENT: Type Layne - Bowler Turbine H.P. 40
Capacity 500 G.P.M.

WELL TESTS:

Drawdown _____ ft. after _____ hours _____ G.P.M.
Drawdown _____ ft. after _____ hours _____ G.P.M.

USE OF WATER Irrigation Temp. _____ °F. _____ 19 _____

SOURCE OF INFORMATION GR-2772

DRILLER or DIGGER A. M. Janssen, Reedville, Oregon

ADDITIONAL DATA:

Log _____ Water Level Measurements _____ Chemical Analysis _____ Aquifer Test _____

REMARKS:

RECEIVED

DEC 14 2009

WATER RESOURCES DEPT
SALEM, OREGON