


T. 27 S., R. 33 E., WM
SECTION 1
GARY WILLSON
TAX LOT 100
PRINCETON, OR

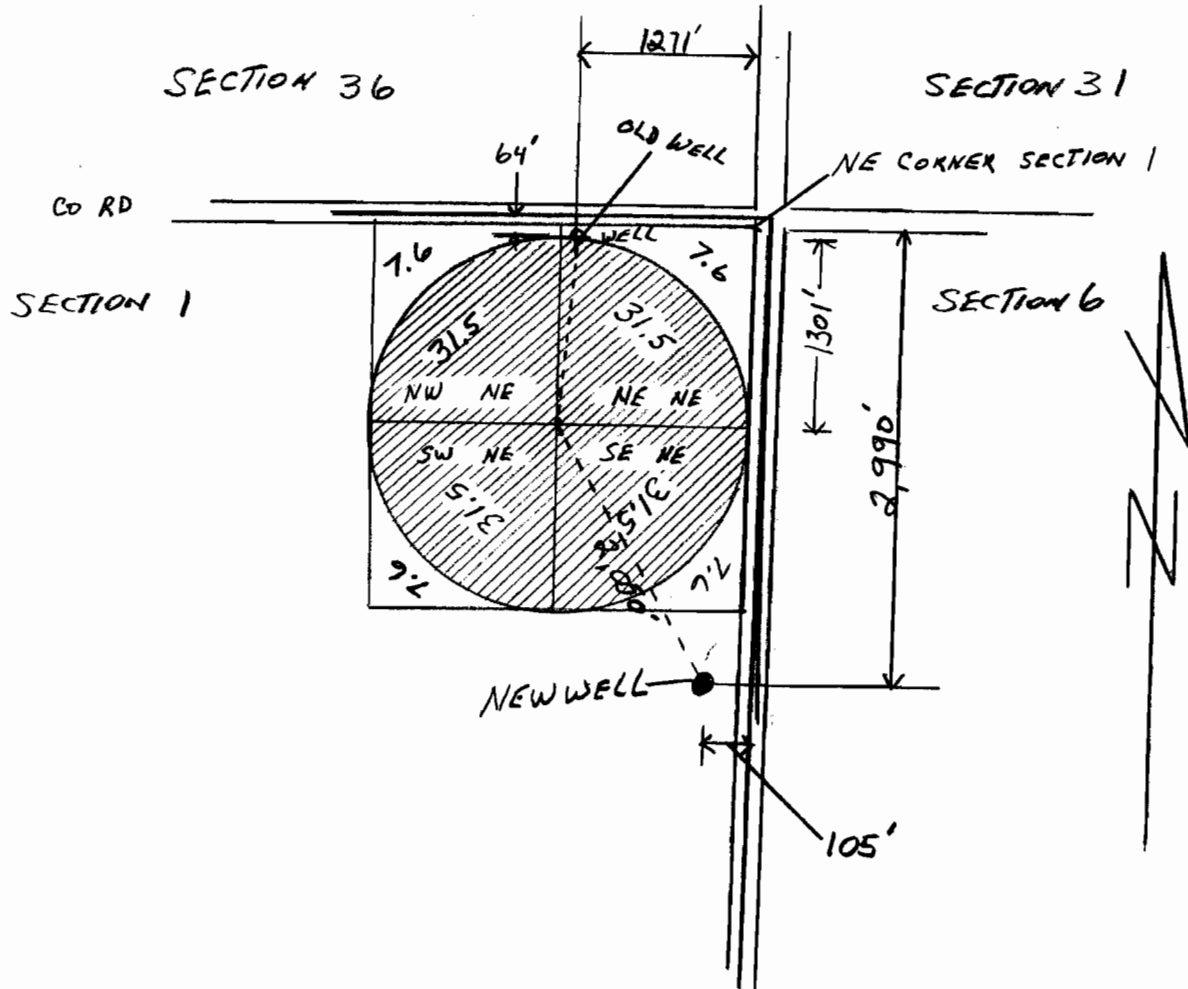

SCALE 4" = 1 MILE

T 10994

RECEIVED
DEC 17 2009
WATER RESOURCES DEPT
SALEM, OREGON