


T 29 S, R 16 E, WM
TAX LOT 500

PERNOLL RANCH, LLC

"To"

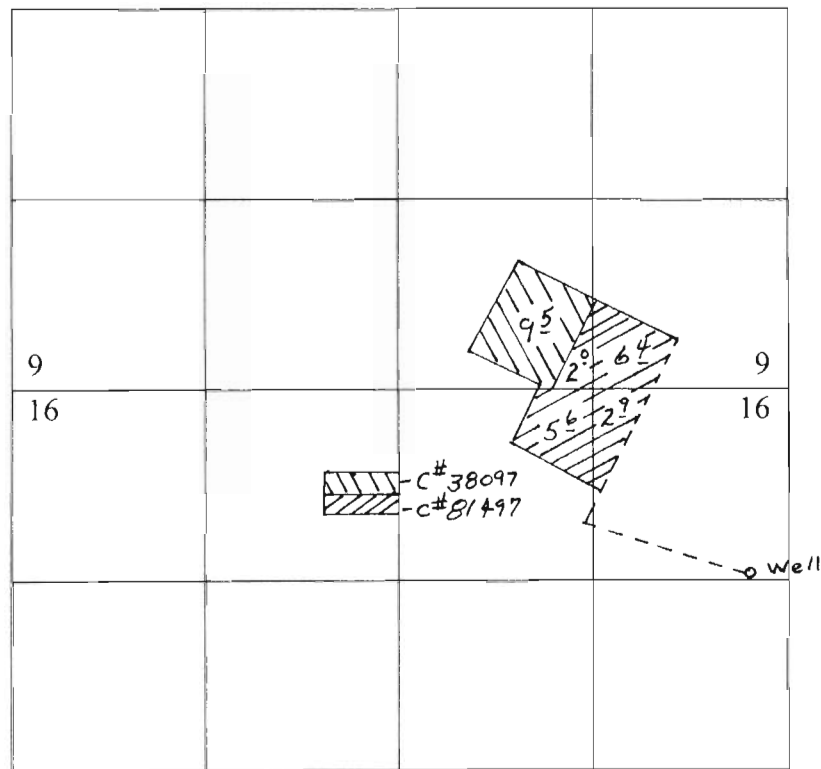

Scale 1 inch = 1320'

Well Located: 1140' S & 5250' E from the NW Corner, Sec 16,
T 29 S, R 16 E, WM.

T 10983


RECEIVED
DEC 01 2009
WATER RESOURCES DEPT
SALEM, OREGON

G4263 13
38097
19828

T. 29 S. R. 16 E. W. M.

"From"

C# 38097

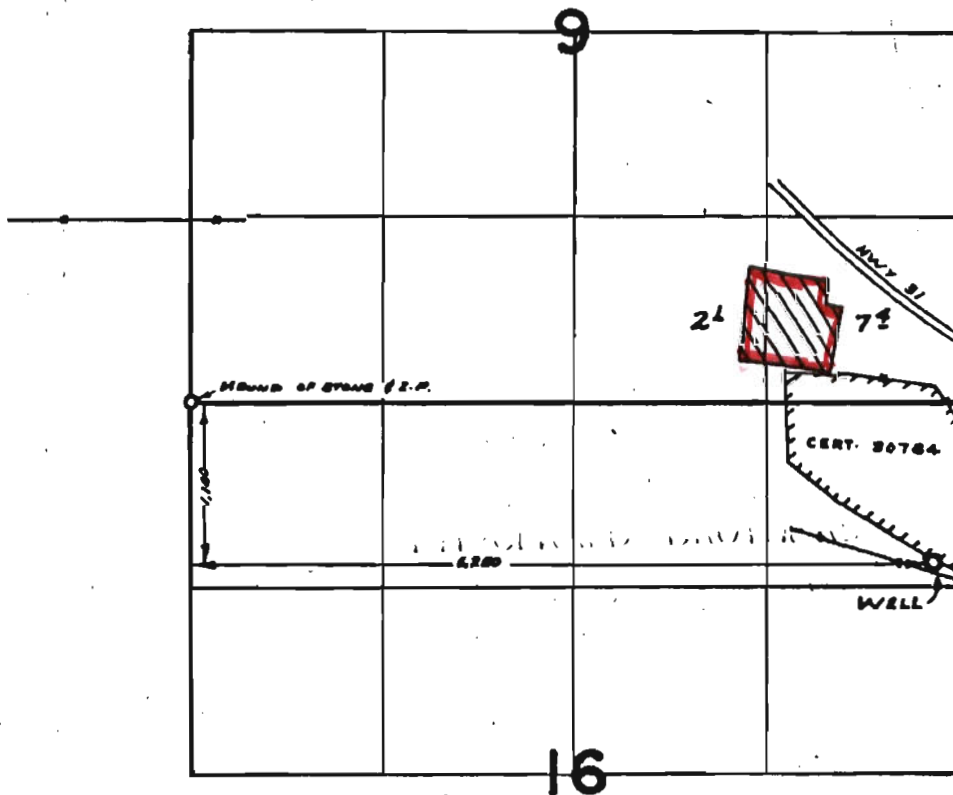

FINAL PROOF SURVEY

UNDER

Application No. G-4525 Permit No. G-4263

IN NAME OF

L. H. RANCH, INC.

Surveyed June 25, 1970, by R. MUCKEN

T 10983

RECEIVED
DEC 01 2009
WATER RESOURCES DEPT
SALEM, OREGON


T. 29 S., R. 16 E., W.M.

C# 81497

FROM

FEB - 8 1994

WATER RESOURCES DEPT
SALEM, OREGON

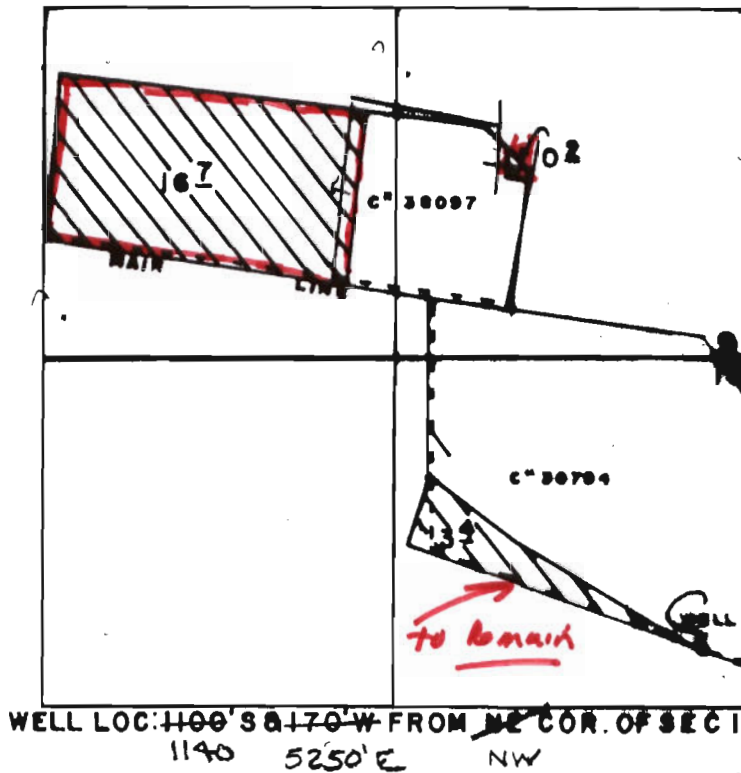

SCALE: 1" = 660'

FINAL PROOF SURVEY

UNDER

Application No. G-10689 Permit No. G-9786
IN NAME OF

L.H.RANCH, INC.

Surveyed AUG 24, 1993, by R.M.SUTTERFIELD

T 10983

RECEIVED
DEC 01 2009
WATER RESOURCES DEPT
SALEM, OREGON

PHOTO ASC COPY

11/23/93

R.M.S.