

Auth

YAMH  
5954

# Well Record

STATE ENGINEER  
Salem, Oregon


STATE WELL NO. 4/4W-36A  
COUNTY Yamhill  
APPLICATION NO. GR-886

OWNER: Donald C. Goodrich  
MAILING ADDRESS: Dayton

LOCATION OF WELL: Owner's No. CITY AND STATE:

NE 1/4 NE 1/4 Sec. 36 T. 4 N. S., R. 4 E. W., W.M.

Bearing and distance from section or subdivision corner  
930 feet west and 900 feet south  
from NE corner, Section 36

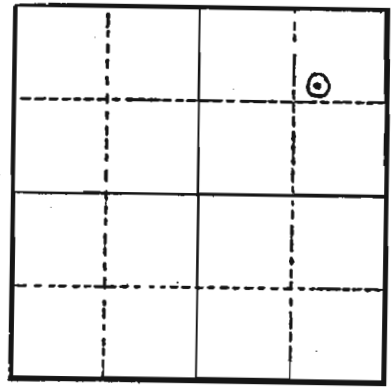

Section

Altitude at well 145

TYPE OF WELL: Drilled Date Constructed Nov. '52

Depth drilled 131 Depth cased

### CASING RECORD:

### FINISH:

### AQUIFERS:

### WATER LEVEL:

Varies

PUMPING EQUIPMENT: Type Fairbanks Morse Pomona Turbine H.P. 15 Elec.  
Capacity 200 G.P.M.

### WELL TESTS:

Drawdown 29 ft. after 380 hours G.P.M.  
Drawdown ft. after hours G.P.M.

USE OF WATER Irrigation Temp. °F, 19.

SOURCE OF INFORMATION Owner  
DRILLER or DIGGER Wilcox Drilling Co. McMinnville, Oregon

### ADDITIONAL DATA:

Log NA Water Level Measurements Chemical Analysis Aquifer Test

### REMARKS:

APDA

NOTICE TO WATER WELL CONTRACTOR

The original and first copy of this report are to be filed with the

STATE ENGINEER, SALEM 10, OREGON within 30 days from the date of well completion.

RECEIVED AUG 18 1962 STATE ENGINEER SALEM, OREGON

WATER WELL REPORT

STATE OF OREGON (Please type or print)

YAMH

5952

State Well No.

4/4W-36 A

State Permit No.

(1) OWNER:

Name Donald Goodrich
Address R2 Box 112 Dayton OR

(2) LOCATION OF WELL:

County Yamhill Driller's well number
NE 1/4 Section 36 T. 4S R. 4W W.M.
Bearing and distance from section or subdivision corner

(3) TYPE OF WORK (check):

Well [X] Deepening [ ] Reconditioning [ ] Abandon [ ]
abandonment, describe material and procedure in Item 12.

(4) PROPOSED USE (check):

Domestic [ ] Industrial [ ] Municipal [ ]
Irrigation [X] Test Well [ ] Other [ ]

(5) TYPE OF WELL:

Rotary [ ] Driven [ ]
Cable [X] Jetted [ ]
Dug [ ] Bored [ ]

(6) CASING INSTALLED:

8" Diam. from 1 ft. to 115 ft. Gage 1/4
Threaded [ ] Welded [X]

(7) PERFORATIONS:

Perforated? [X] Yes [ ] No
Type of perforator used Touch
Size of perforations 1/8 in. by 6 in.
168 perforations from 85 ft. to 115 ft.

(8) SCREENS:

Well screen installed [ ] Yes [X] No
Manufacturer's Name
Model No.
Diam. Slot size Set from ft. to ft.

(9) CONSTRUCTION:

Well seal-Material used in seal Cement
Depth of seal 20 ft. Was a packer used? yes
Diameter of well bore to bottom of seal 16 in.
Were any loose strata cemented off? [ ] Yes [X] No
Was a drive shoe used? [ ] Yes [X] No
Was well gravel packed? [X] Yes [ ] No Size of gravel: 3/8 in.
Gravel placed from 20 ft. to 115 ft.
Did any strata contain unusable water? [ ] Yes [X] No
Type of water? Depth of strata
Method of sealing strata off

(10) WATER LEVELS:

Static level 20 ft. below land surface Date 7/18/62
Artesian pressure lbs. per square inch Date

(11) WELL TESTS:

Drawdown is amount water level is lowered below static level
Was a pump test made? [X] Yes [ ] No If yes, by whom? Driller
Yield: 5.30 gal./min. with 90 ft. drawdown after 8 hrs.

(12) WELL LOG:

Diameter of well below casing
Depth drilled 115 ft. Depth of completed well 115 ft.
Formation: Describe by color, character, size of material and structure, and show thickness of aquifers and the kind and nature of the material in each stratum penetrated, with at least one entry for each change of formation.

Table with columns: MATERIAL, FROM, TO. Rows include Top Soil, Blue Clay, Fine Black Sand, Blue clay, Course sand & gravel, Blue clay.

Work started 7/3 1962 Completed 7/18 1962
Date well drilling machine moved off of well 7/11 1962

(13) PUMP:

Manufacturer's Name Fairbanks Morse
Type: turbine H.P. 15

Water Well Contractor's Certification:

This well was drilled under my jurisdiction and this report is true to the best of my knowledge and belief.

NAME Arrow Drilling & Supplies
Address 727 N Main, Medford, OR
Drilling Machine Operator's License No. 82
[Signed] Harlan M. Buffum
Contractor's License No. 117 Date 7/20, 1962