


SECTION 11, TWP.2 N. RANGE 16 E. W.M.
SHERMAN COUNTY, OREGON

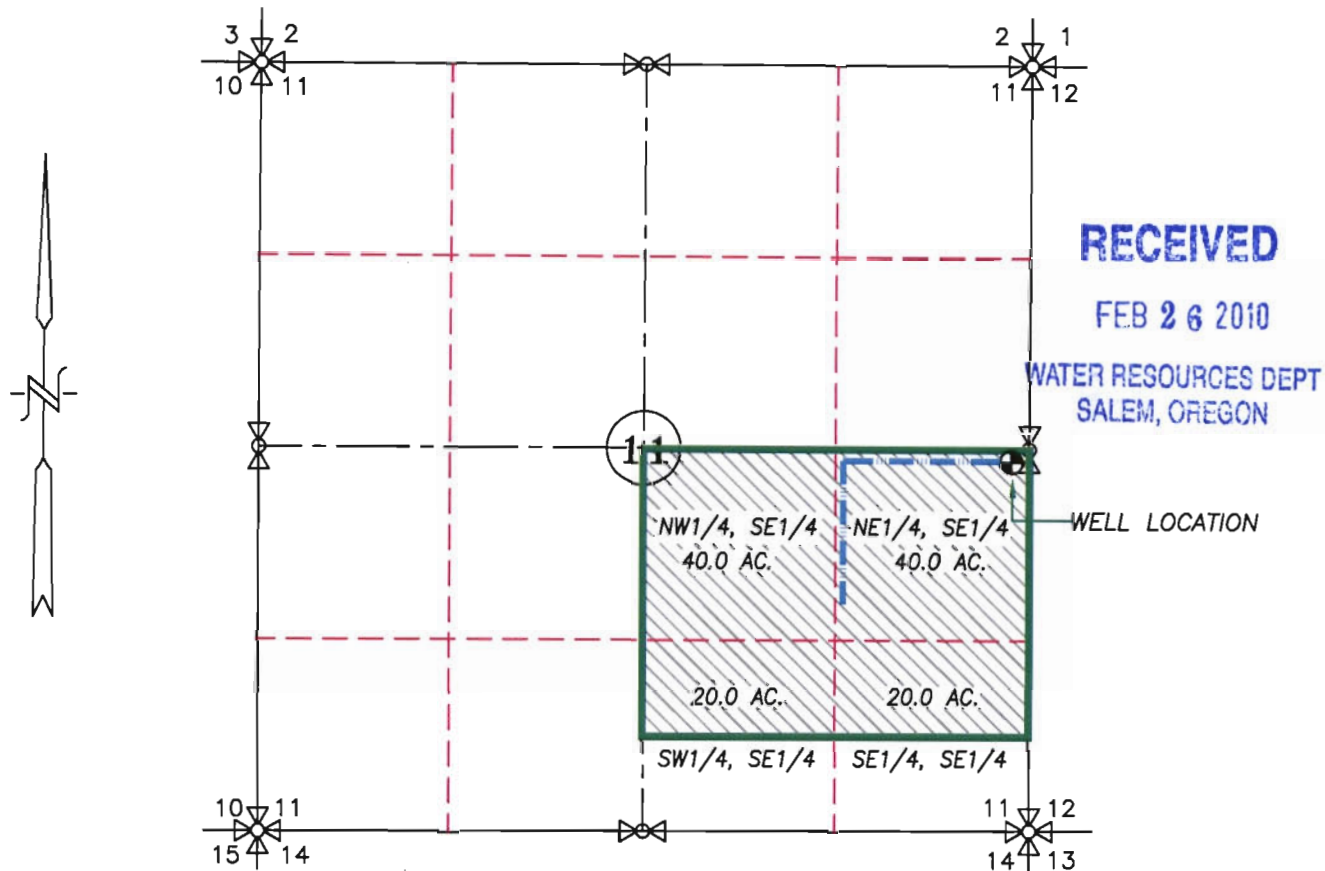

● EXISTING WELL, 52' SOUTH & 35' WEST OF E1/4 COR. SEC. 11

 APPLICATION AREA TO BE TRANSFERRED FROM = 120.0 ACRES

 IRRIGATION MAIN

PERMIT
AMENDMENT FROM MAP

SCALE: 1"= 1320'

APPLICATION No. G-16803

PERMIT No. G-16285

IN THE NAME OF:

BILL MARTIN

DATE: APRIL 1, 2009

BY: **TENNESON ENGINEERING CORP.**
3313 W. 2ND. STREET, SUITE 100
THE DALLES, OREGON. 97058
PH. (541) 296-9177
FAX (541) 296-6657




EXPIRES: 06/30/2010

NOTE:

"THIS MAP IS NOT INTENDED TO
PROVIDE DIMENSIONS OR LOCATIONS
OF PROPERTY OWNERSHIP LINES."

W.O. #12508wr2

SECTION 11, TWP.2 N. RANGE 16 E. W.M. SHERMAN COUNTY, OREGON

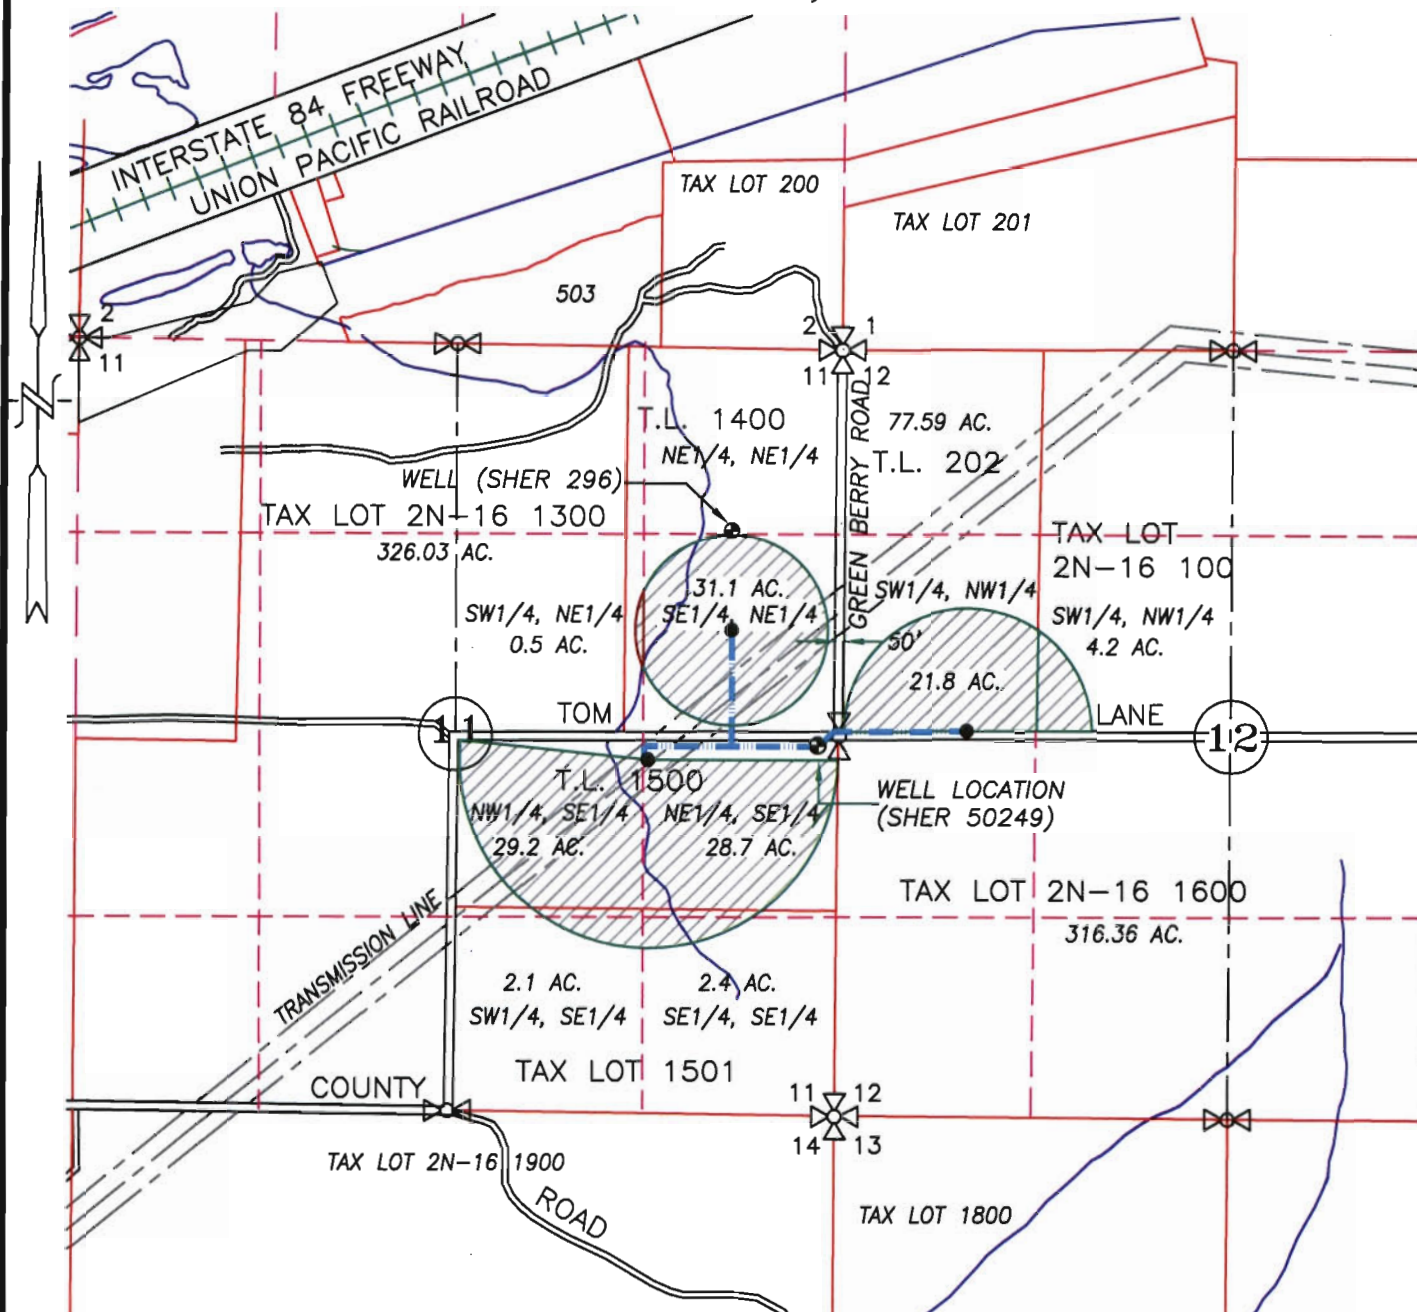

- WELL (SHER 50249) 52' SOUTH & 35' WEST OF E1/4 COR. SEC. 11
- WELL (SHER 296) 1243' SOUTH & 752' WEST OF NE COR. SEC. 11



APPLICATION AREA TO BE TRANSFERRED TO = 120.0 ACRES

IRRIGATION MAIN

PERMIT AMENDMENT TO MAP

SCALE: 1" = 1320'

RECEIVED

FEB 26 2010

WATER RESOURCES DEPT
SALEM, OREGON

APPLICATION No. G-16803

PERMIT No. G-16285

IN THE NAME OF:


BILL MARTIN

DATE: APRIL 1, 2009

BY: **TENNESON ENGINEERING CORP.**
3313 W. 2ND. STREET, SUITE 100
THE DALLES, OREGON. 97058
PH. (541) 296-9177
FAX (541) 296-6657



1 11027

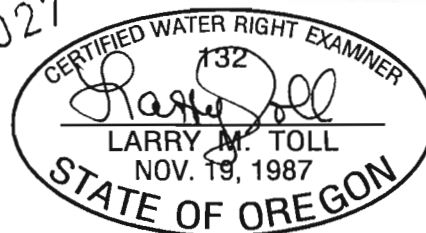

EXPIRES: 06/30/2010

NOTE:

"THIS MAP IS NOT INTENDED TO
PROVIDE DIMENSIONS OR LOCATIONS
OF PROPERTY OWNERSHIP LINES."

W.O. #12508wr2