


SW1/4 SE1/4 Sec.17 T.39S. R.12W. W.M.  
CURRY COUNTY

39 12 17 DC  
1995

1" = 100'

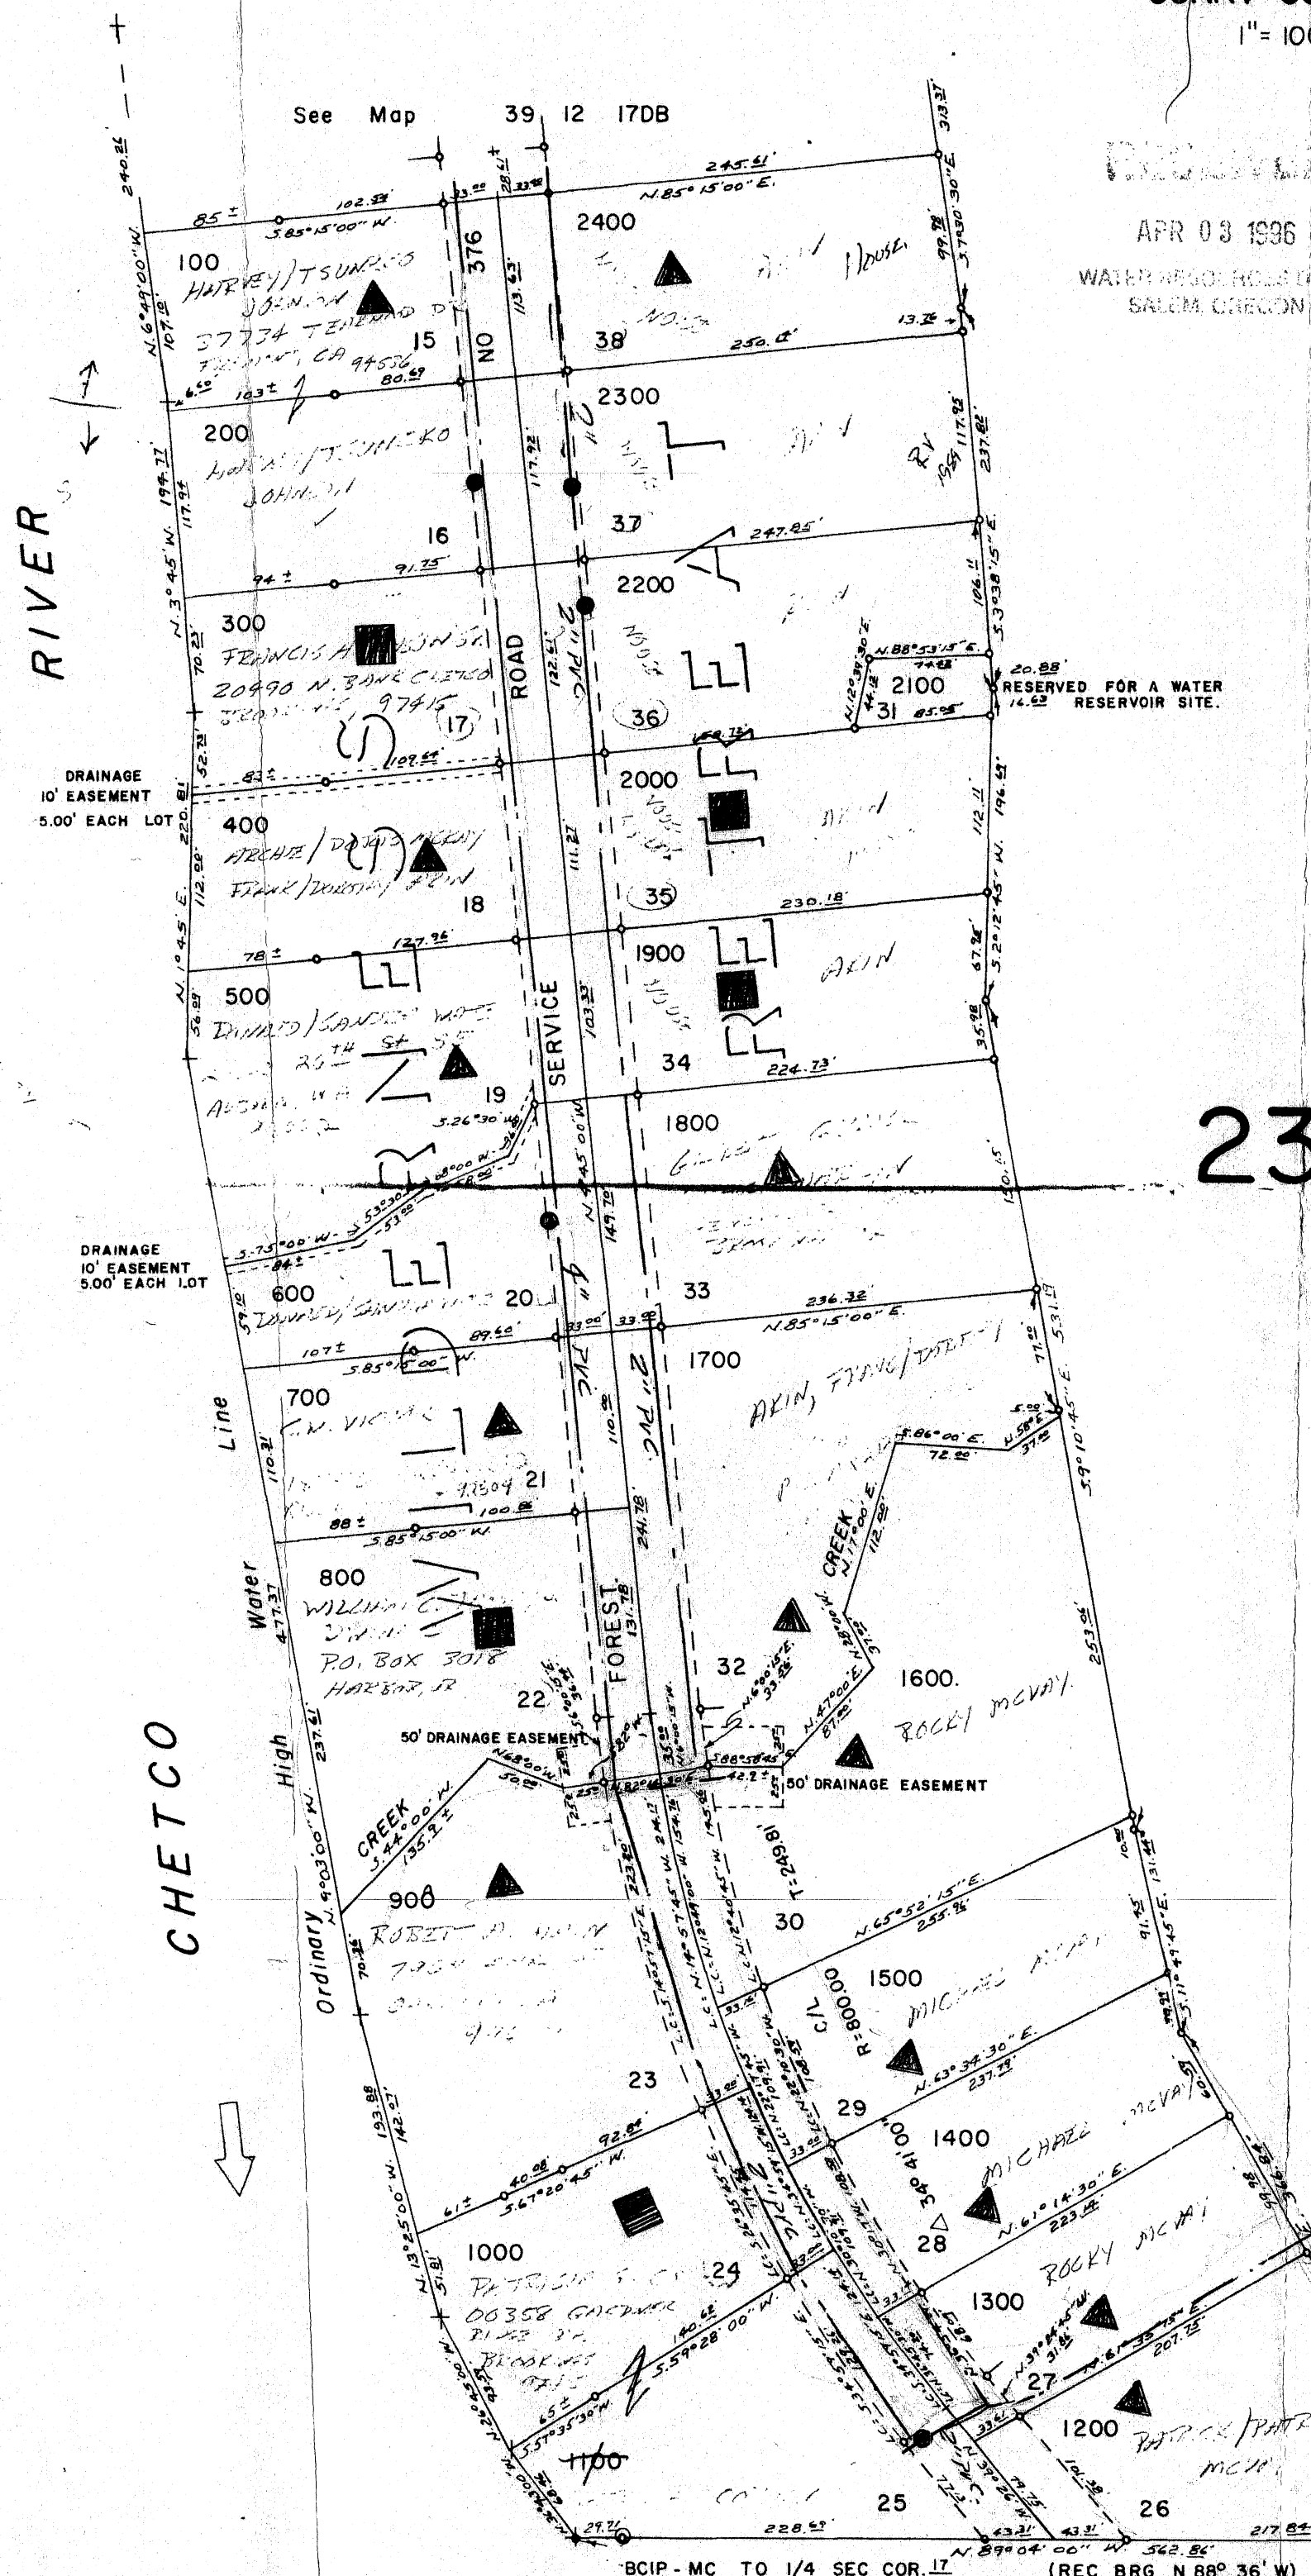

APR 03 1996  
WATER RESOURCES DEPT.  

FRANK / DOROTHY AKIN  
P.O. BOX A  
BRACKING, OR 97415

ARCHIE ET AL MCVAY  
BOX 2126  

23-2

See Map 39 12

- HOUSE
- ▲ R.V. CAMPSITE (HOSE BIBB OUTLET ABOVE GROUND)
- OUTLET UNDERGROUND

FINAL PROOF SURVEY  
UNDER

Application No. 47421  
Permit No. 35534  
IN NAME OF

ARCHIE MCVAY  
FRANK AKIN

October 10, 1988 by B.S. JAMES.  
JANUARY 23, 1992 by B.S. JAMES.  
JULY 27, 1995 by B.S. JAMES

TO TANK  
DIVERSION.  
SEE PERMIT MAT 35534 BY B.A. MARTIN

WILDERNESS RETREAT  
P.O. BOX 1295  
BRACKING, OR 97415

MAR 2 of 2

39 12 17 DC