



ECHO IRRIGATION DISTRICT
TEMPORARY TRANSFERS

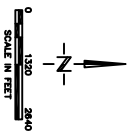

NOTE: THE LOCATION OF THE WELLS AND DITCHES IS SUBJECT TO CHANGE. 

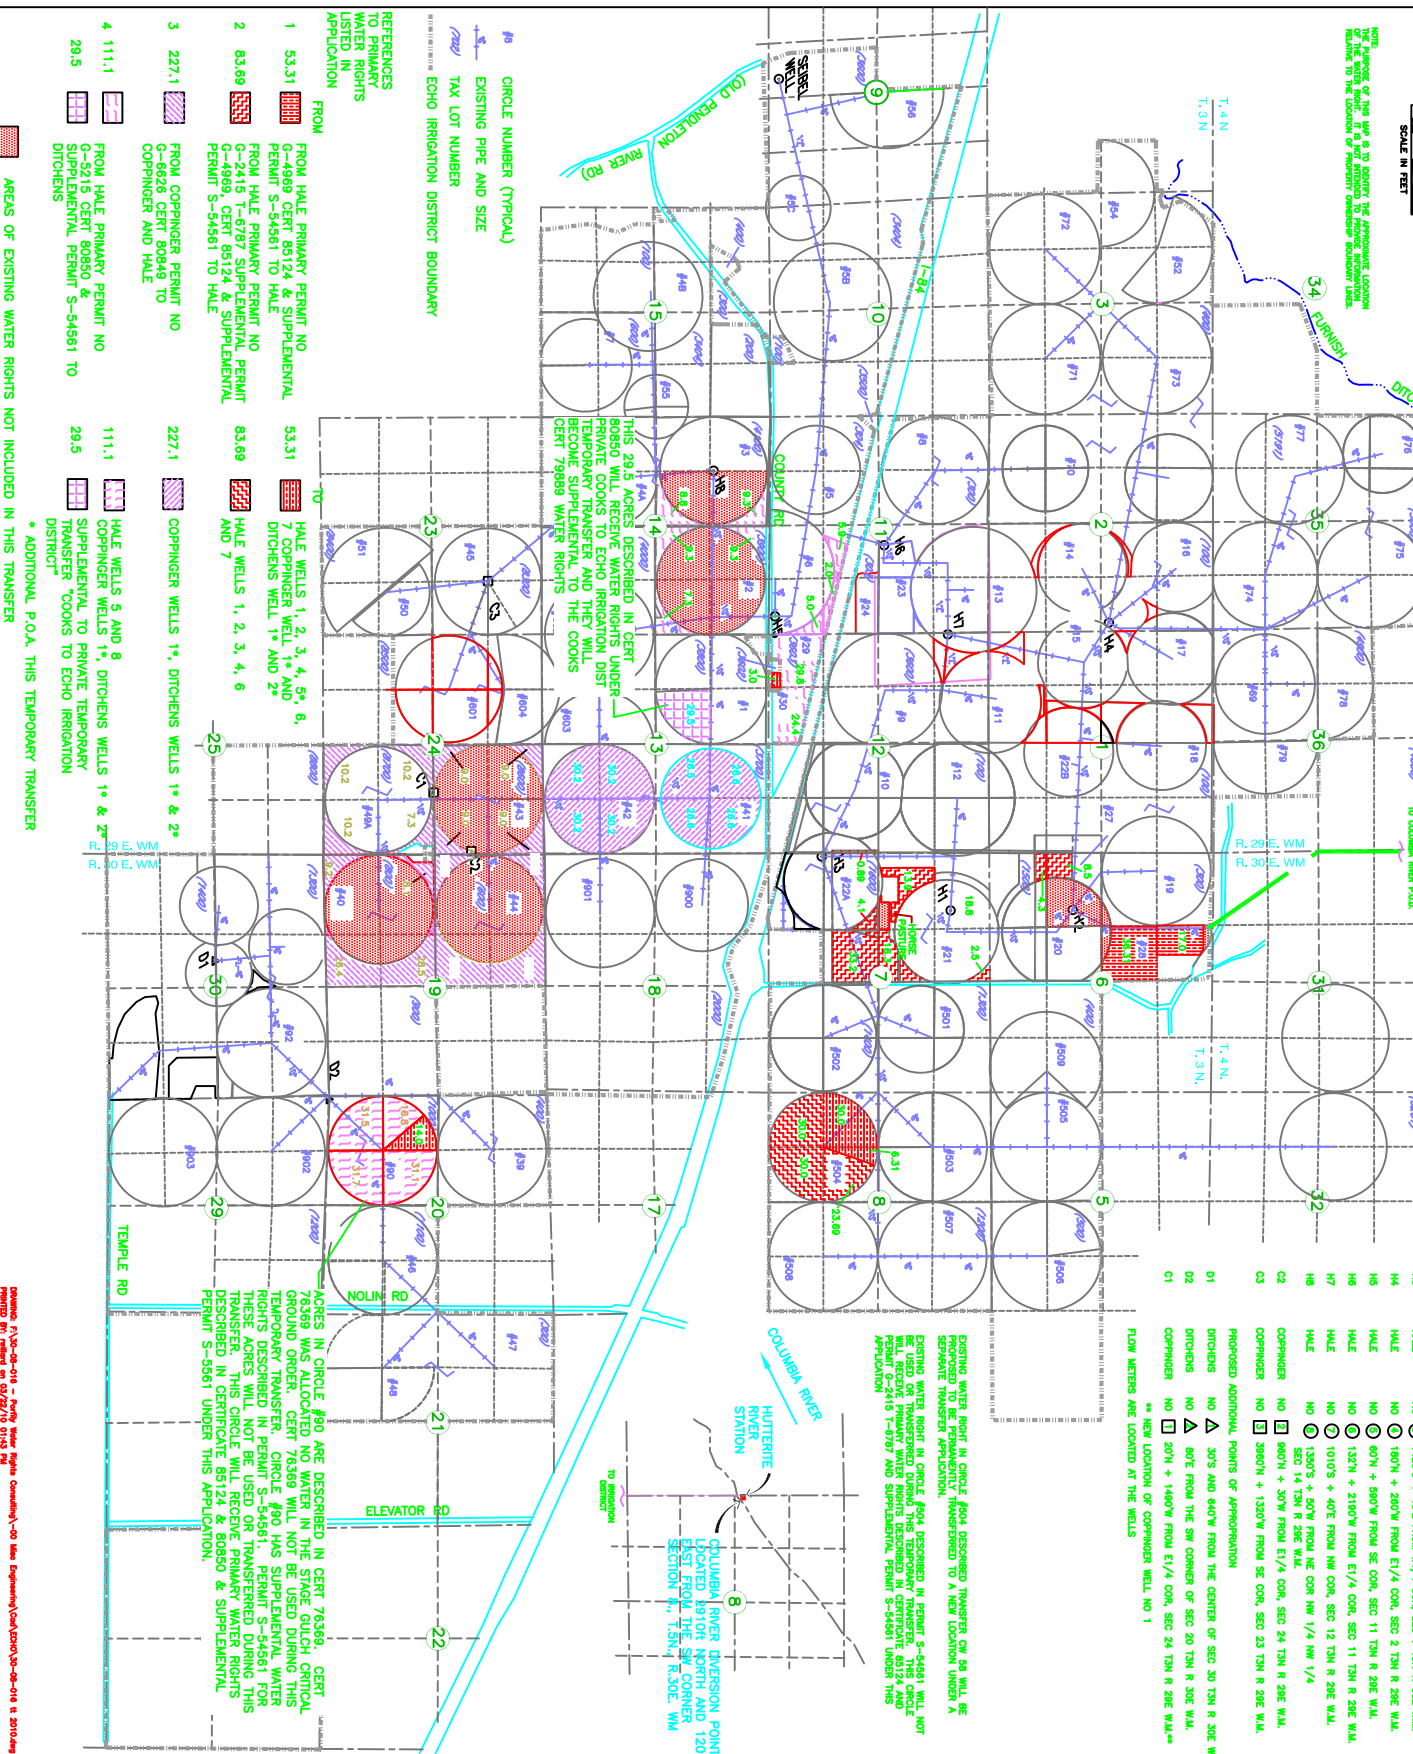

POA AS SHOWN IN APPLICATION

WELL LEGEND	POA AS SHOWN IN APPLICATION

PROPOSED ADDITIONAL POINTS OF APPROPRIATION

DITCHES NO 1 30'S AND 640'W FROM THE CENTER OF SEC 20 T3N R 20E W1/4

DITCHES NO 2 80'E FROM THE SW CORNER OF SEC 20 T3N R 20E W1/4


COPPINGER NO 1 20'N + 1460'W FROM E1/4 COR, SEC 24 T3N R 20E W1/4**

** NEW LOCATION OF COPPINGER WELL NO 1

FLOW METERS ARE LOCATED AT THE WELLS



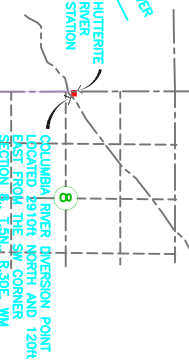


ACRES IN CIRCLE #90 ARE DESCRIBED IN CERT 76369. CERT 76369 WAS ALLOCATED NO WATER IN THE STAGE GULCH CRITICAL GROUND ORDER. CERT 76369 WILL NOT BE USED DURING THIS TEMPORARY TRANSFER. CIRCLE #90 HAS SUPPLEMENTAL WATER RIGHTS DESCRIBED IN PERMIT S-54561 AND SUPPLEMENTAL PERMIT S-54561. THIS CIRCLE WILL RECEIVE PRIMARY WATER RIGHTS DESCRIBED IN CERTIFICATE 85124 & 80850 & SUPPLEMENTAL PERMIT S-5561 UNDER THIS APPLICATION.

- 1 53.31 FROM HALF PRIMARY PERMIT NO G-4969 CERT 85124 & SUPPLEMENTAL PERMIT S-54561 TO HALF
- 2 83.69 FROM HALF PRIMARY PERMIT NO G-2415 T-6787 SUPPLEMENTAL PERMIT G-4969, CERT 85124 & SUPPLEMENTAL PERMIT S-54561 TO HALF
- 3 227.1 FROM COPPINGER PERMIT NO G-6626 CERT 80849 TO COPPINGER AND HALF
- 4 111.1 FROM HALF PRIMARY PERMIT NO G-5215 CERT 80850 & SUPPLEMENTAL PERMIT S-54561 TO DITCHES

- 111.1 HALF WELLS 5 AND 8
- 227.1 COPPINGER WELLS 1* & 2*
- 29.5 SUPPLEMENTAL TO PRIVATE TEMPORARY TRANSFER COOKS TO ECHO IRRIGATION DISTRICT

- 227.1 COPPINGER WELLS 1*, DITCHES WELLS 1* & 2*

* ADDITIONAL P.O.A. THIS TEMPORARY TRANSFER AREAS OF EXISTING WATER RIGHTS NOT INCLUDED IN THIS TRANSFER