
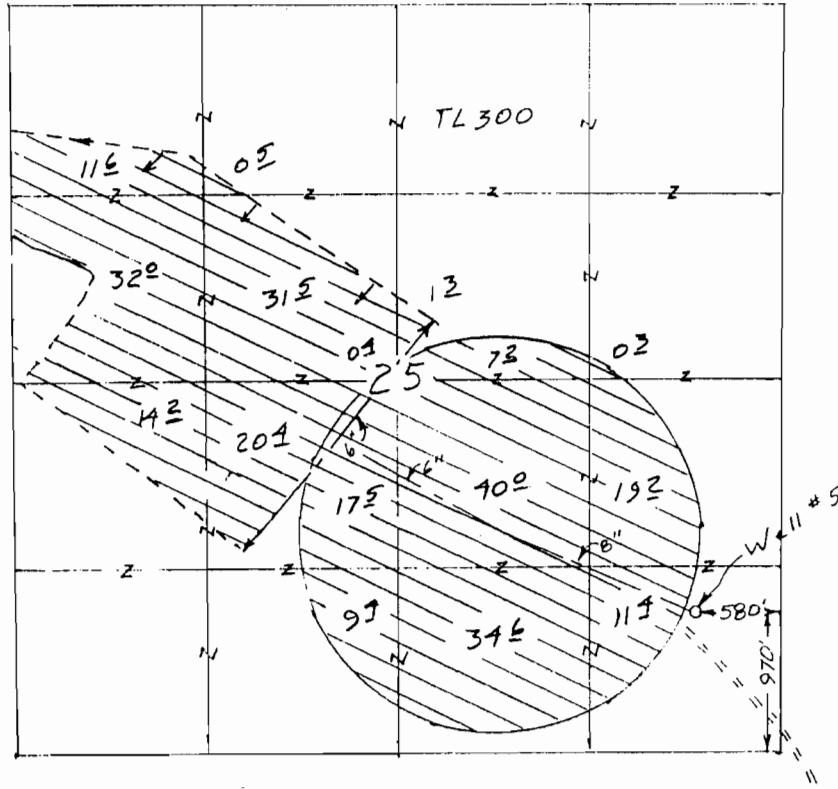


TOWNSHIP 16 SOUTH, RANGE 22 EAST, W.M.

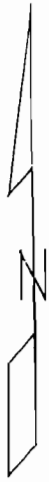

Scale 1" = 1320'  
**FROM**  
 251 1/2 acres


Permit Amendment Map  
 for  
 Gutierrez Cattle Co.

App G-16037  
 Permit G-15598

**RECEIVED**

APR 02 2010

WATER RESOURCES DEPT  
 SALEM, OREGON

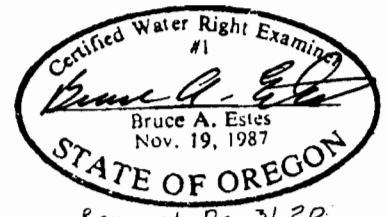


Sheet 1 of 2

T 11055

This map is for the purpose of locating a water right only and has no intent to provide legal dimensions or the location of property lines.

**ESTES SURVEYS, LLC**  
 PO Box 17519 Salem, OR 97305-7519 (503) 585-7593  
 60382 Arnold Rd Bend, OR 97702 (541) 382-7391

TOWNSHIP 16 SOUTH, RANGE 22 EAST, W.M.

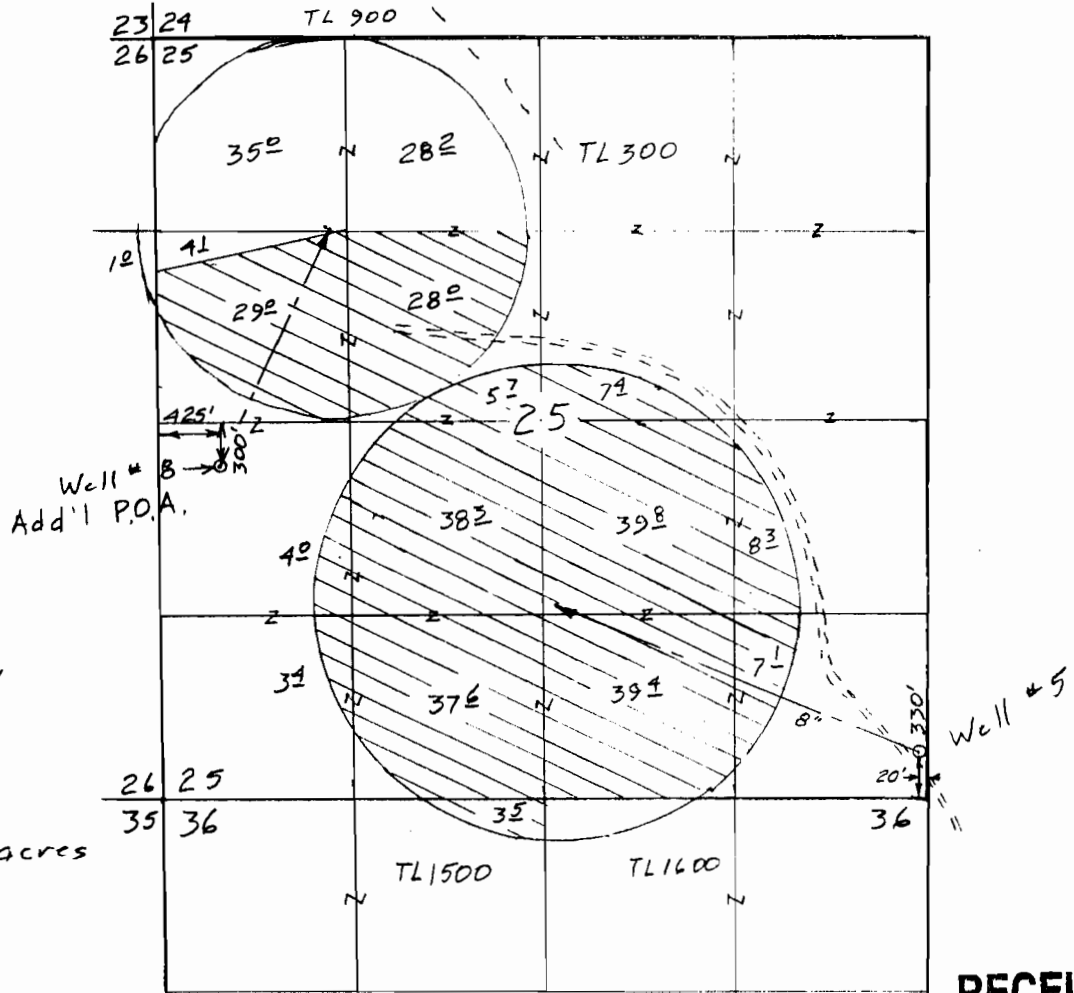

Scale 1" = 1320'  
(4" = 1 mile)

⊗ To: 251 $\frac{1}{2}$  acres

Surveyed August 16, 2006

Transfer Application Map  
for  
Gutierrez Cattle Co.

App G-16037  
Per G-15598

**RECEIVED**

APR 02 2010

WATER RESOURCES DEPT  
SALEM, OREGON



Sheet 2 of 2

T 11055

This map is for the purpose of locating a water right only and has no intent to provide legal dimensions or the location of property lines.

**ESTES SURVEYS, LLC**  
 PO Box 17519  
 Salem, OR 97306-7519  
 (503) 585-7503  
 60382 Arnold Rd  
 Bend, OR 97702  
 (541) 382-7391