


T.8 S., R.6 W., W.M.

RECEIVED
JUN 1954
WATER RESOURCES
DIVISION
SALEM, OREGON

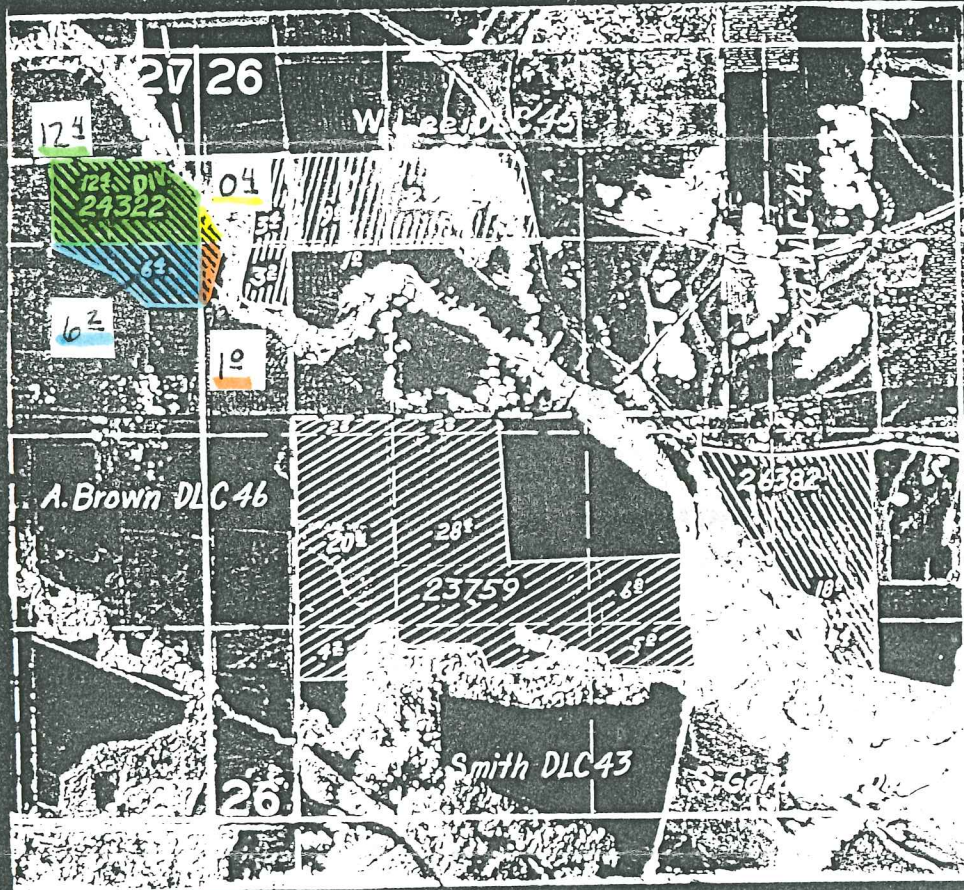

FINAL PROOF SURVEY

Name	Appl. No.	Permit No.
Floyd W. Nelson	22105	17374
Charles Ryan	24322	20476
W. C. Leth	26382	20699
Eldon R. Frink	23759	18813

Surveyed July 7, 1954 by T. Jones

DFP-30-13