


REDUCED COPY
NOT TO SCALE

Handwritten initials: *HY*

CONTROL LAYOUT TRACED CHECKED

CHANGES UPDATED AS OF JUL 13 1994

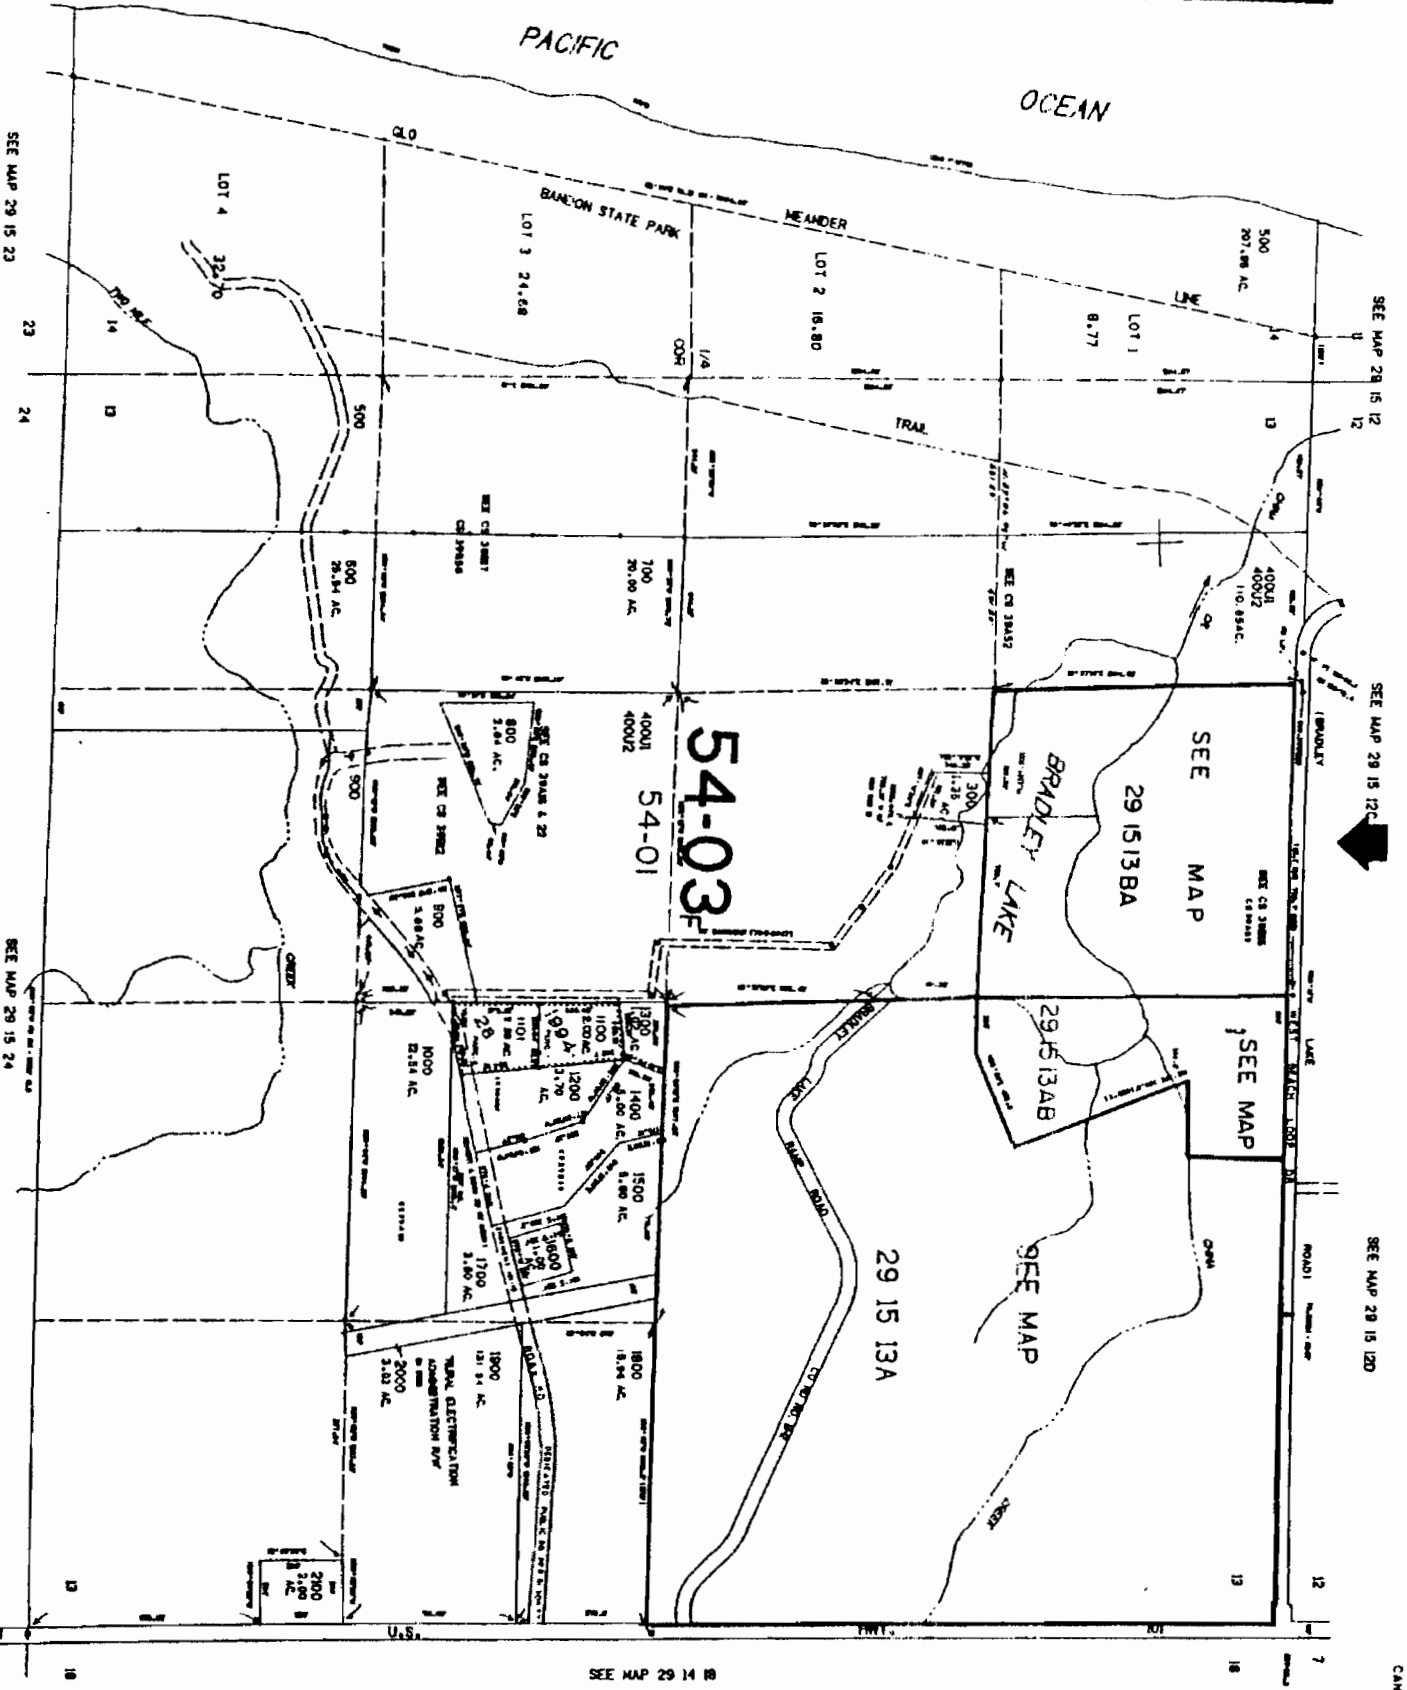

THIS MAP WAS PREPARED FOR ASSESSMENT PURPOSE ONLY.

SECTION 13 1.29S. R13W. W.M.
COOS COUNTY
T-400

29 10 13
& INDEX

CANCELLED
NOI
1901
100
200

1:35,000

SEE MAP 29 14 18

Exhibit B

SEE MAP 29 15 23

SEE MAP 29 15 24

SEE MAP 29 15 12

SEE MAP 29 15 12C

SEE MAP 29 15 12D



29 15 13
& INDEX

COPY

UNIT MAP WAS REVISION FOR
AC. TO BE IN REVISION IN 1954

CUUS CUUVI 1
1-400

402

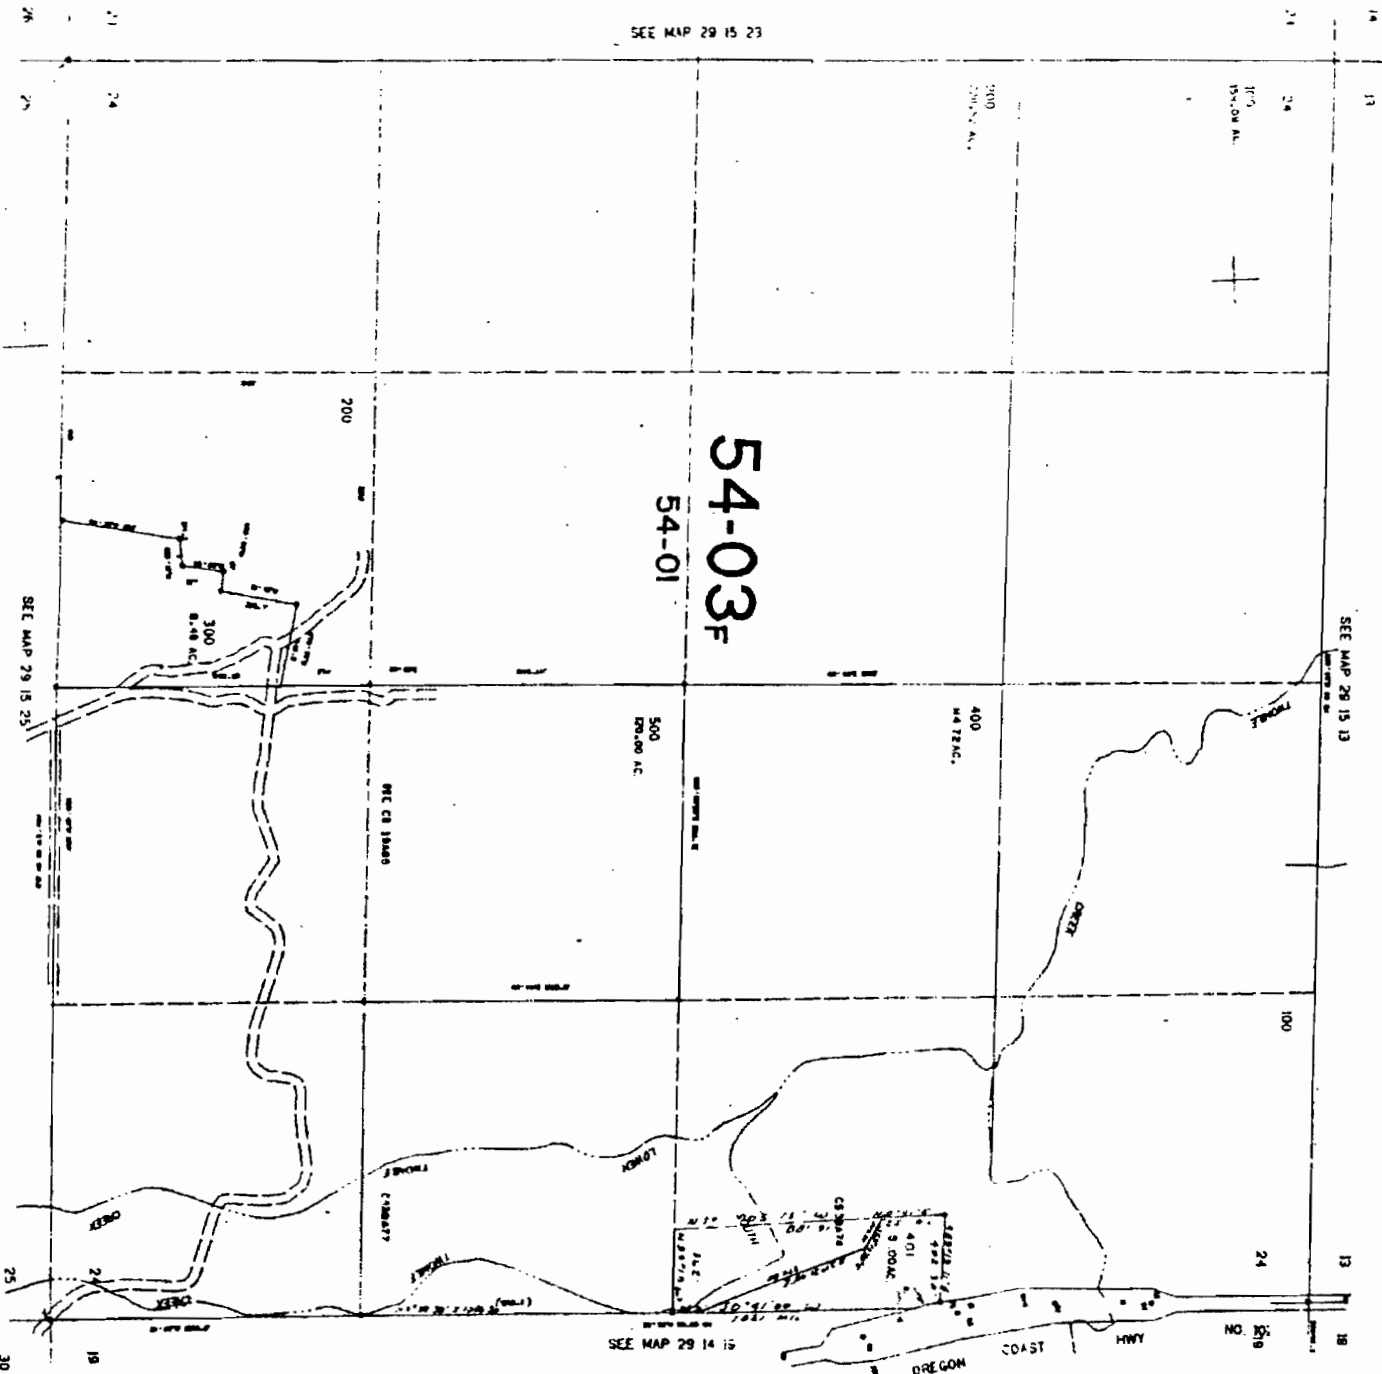
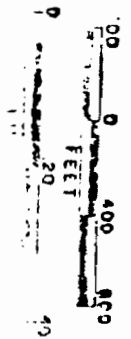


Exhibit B

29 15 24

BOAK RD DEDICATED PUBLIC RD PER 91.5067
988° 07' 30" W 210.4'

1300
131.54 AC.

RURAL ELECTRIFICATION
ADMINISTRATION RW
BY DEED
2000
3.03 AC.

53 Acres
Total

2100
2,000
AC.


SEE CS 33A16 & 17
NO. 1000
300
2.84 AC.

SEE CS 39B12

300
5.89 AC.

1000
12.54 AC.

1700
3.50 AC.

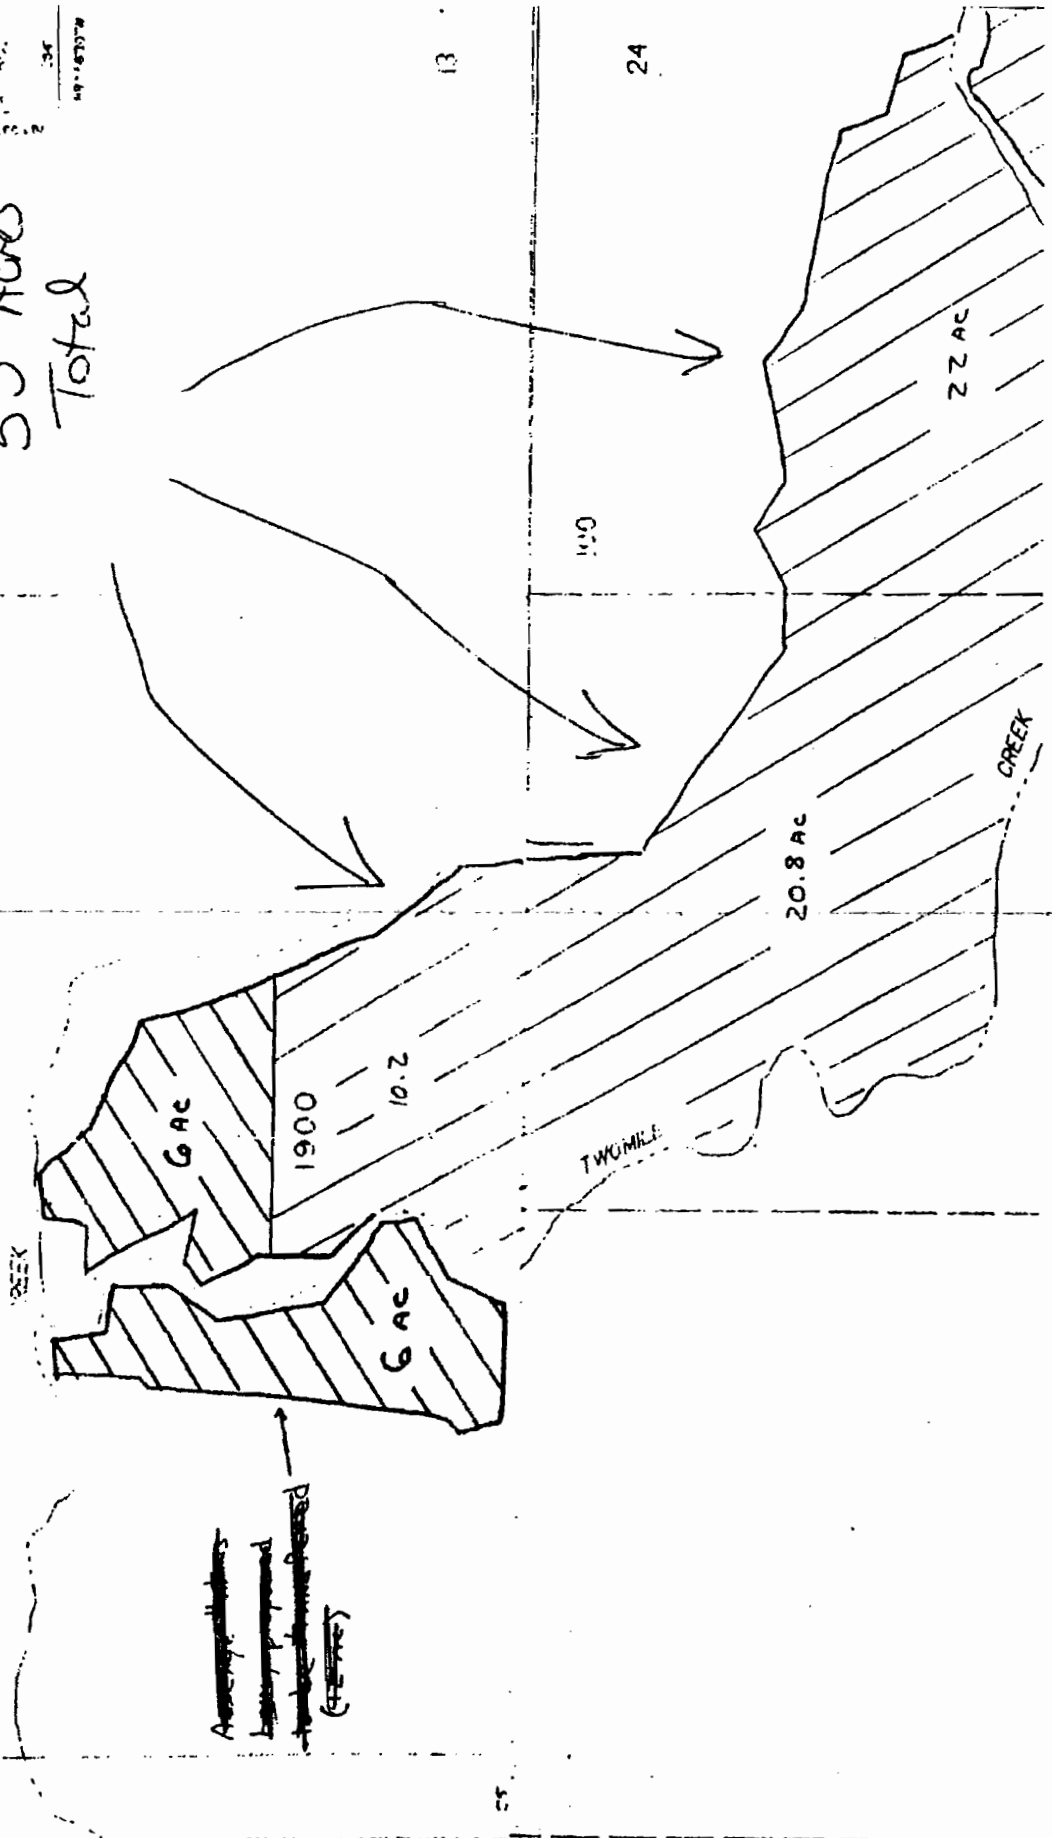

As per Map 1000
(SEE)

F1:6:1 D