
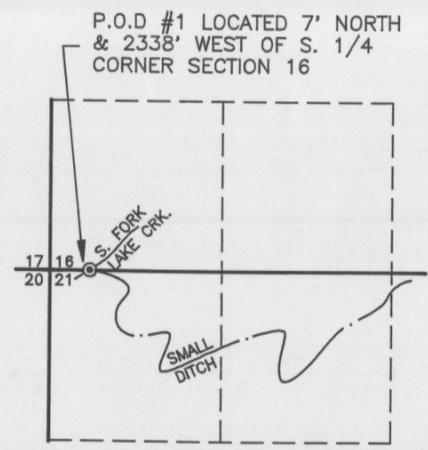


FINAL PROOF SURVEY

UNDER
 TRANSFER NO. T-7062
 IN THE NAME OF CYRUS & REBECCA FIELD
 SPECIAL ORDER VOL. 48, PG. 171-172
 SURVEYED AUGUST 1, 1995

SEC. 16, T13S, R9E, W.M.

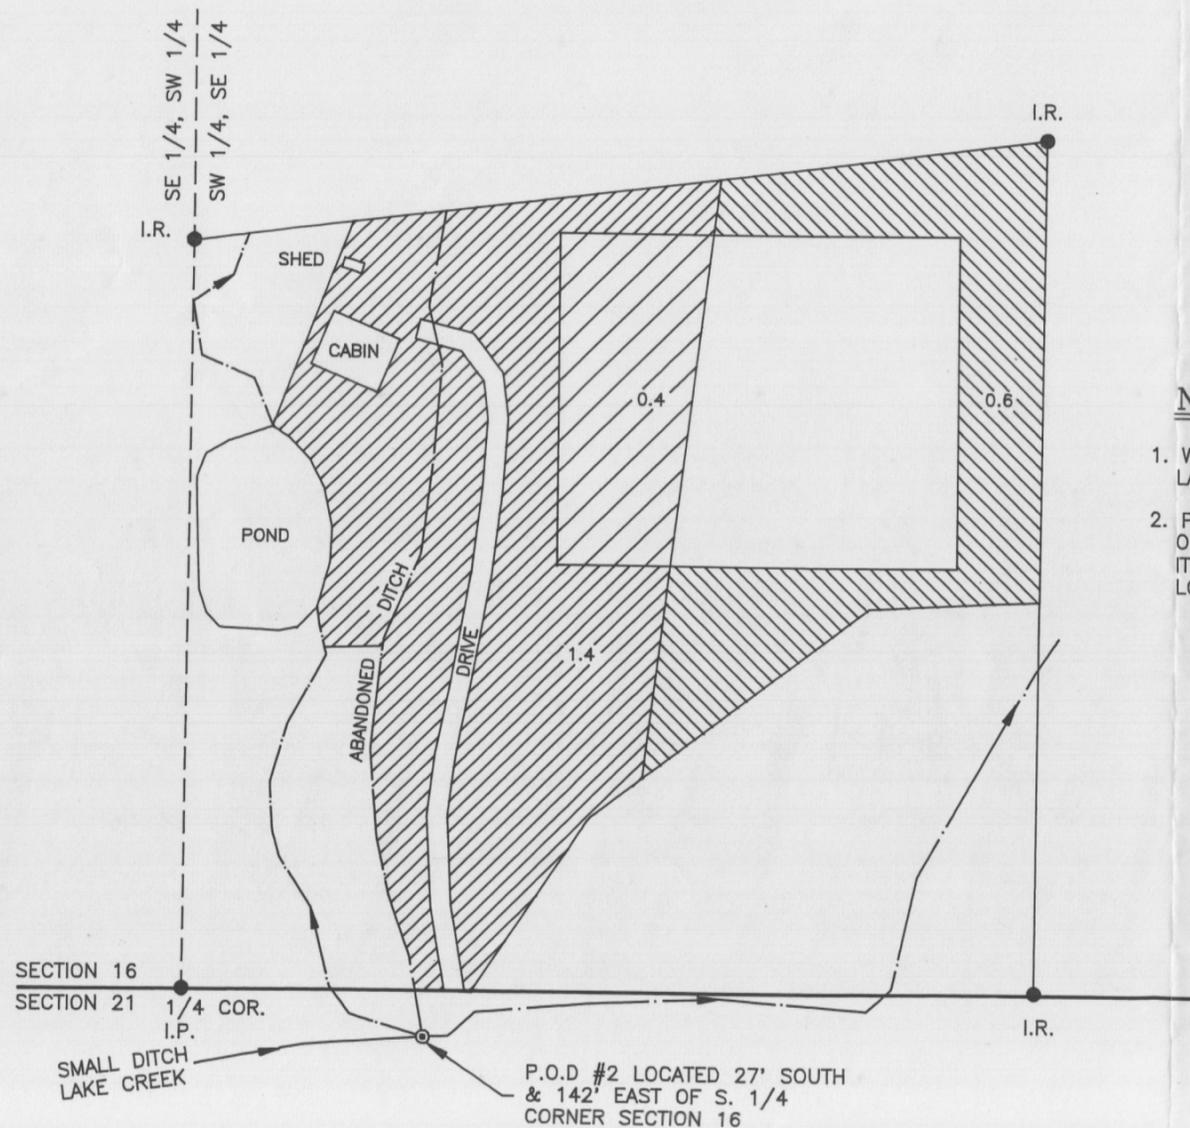

POINT OF DIVERSION INSET MAP
 1" = 1320'



SCALE 1" = 100'




NOTES

1. WATER SOURCE FROM SOUTH FORK OF LAKE CREEK
2. PREPARATION OF THIS MAP IS FOR PURPOSES OF IDENTIFYING PROPOSED WATER RIGHTS ONLY. IT HAS NO INTENT TO PROVIDE DIMENSIONS OR LOCATIONS OF PROPERTY BOUNDARIES.

LEGEND

- EXISTING DITCH
- SECTION LINE
- 1/4, 1/4 SECTION LINE
- EXISTING IRRIGATED AREA COVERED UNDER TRANSFER NO. T-7062
- AREA COVERED UNDER TRANSFER NO. T-7062 NOT BEING IRRIGATED AT THE TIME OF THIS SURVEY
- EXISTING IRRIGATED AREA NOT COVERED UNDER TRANSFER NO. T-7062

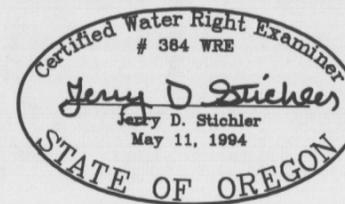

RENEWAL 6/30/96

PREPARED FOR: CYRUS W. FIELD 31469 PETERSEN RD. PHILOMATH, OREGON 97370	
PREPARED BY: ANDERSON ENGINEERING & SURVEYING 539 SW 7TH STREET, P.O. BOX 419 REDMOND, OREGON 97756 (503) 923-4307 (503) 923-4308 FAX AUGUST 4, 1995 SHEET 1 OF 1	
DRAWN BY: J.S.	JOB NO. 95/52R
COGO: 9552	ACAD: 9552FP