

ON DISTRICT ITY, OREGON


T. 18 S., R. 11 E., W.M.
-half


18-11-26 NE NE Tax Lot# 3000

Scale 1" = 400'

Property Leasing Water

19/45 Indian Summer Rd., Bend, OR 97702
Water Being Leased .50 ac

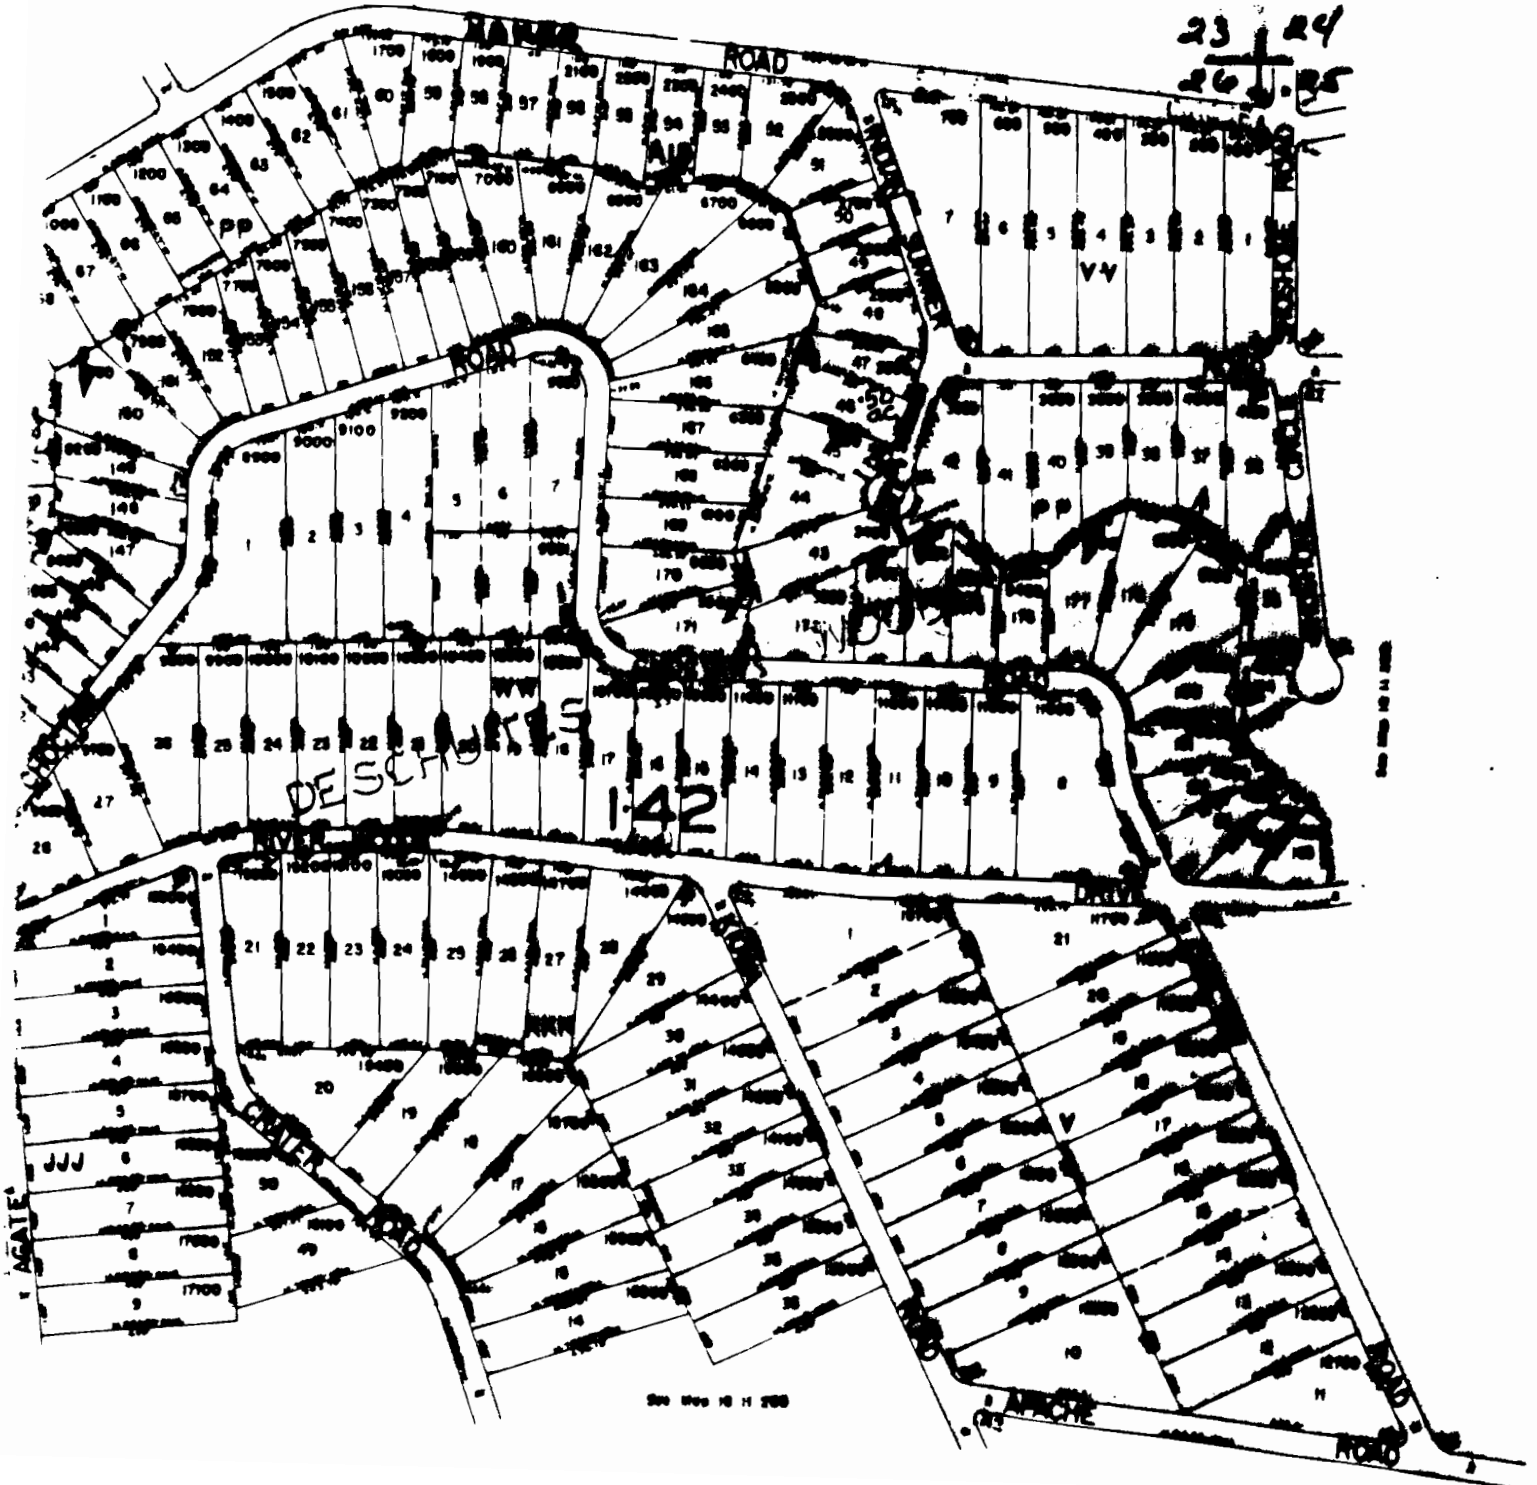

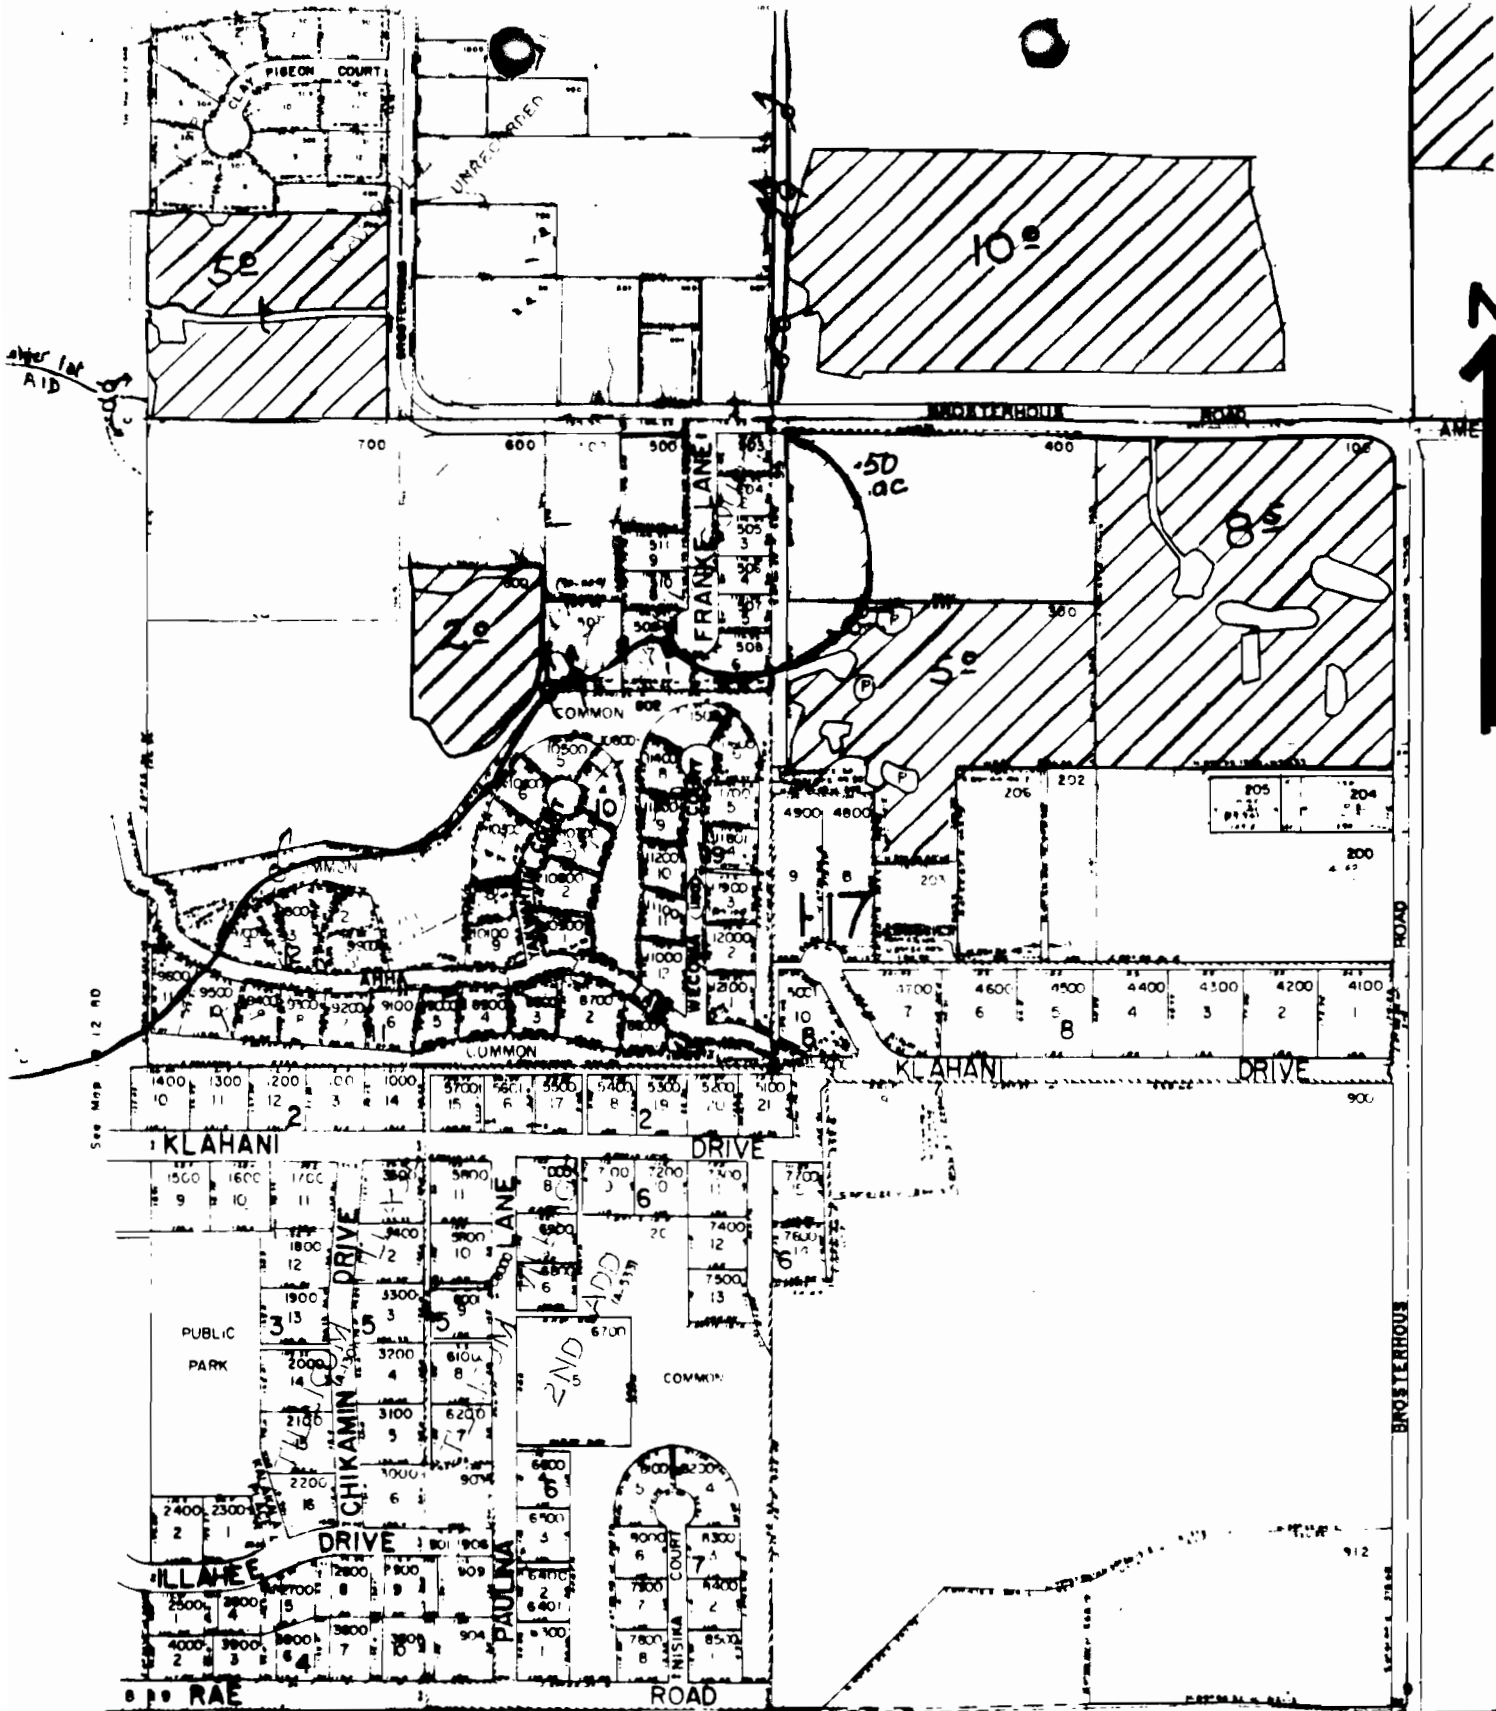

18-12-09 NE SW Tax Lot # 400
 Scale 1" = 400'
 Property Leasing Water
 61375 Brosterhous Rd., Bend, OR 97702
 Water Being Leased .50 ac.


ARNOLD IRR 4. DESCHUTES

18-12-08 NONE Tax Lot #405
18-12-09 NW NW Tax Lot #405
Property Leasing Water


Scale 1"=400' Section

61540 Parrell Rd., Bend, OR 97702

Water Being Leased - Section 08 - .20 ac.
- Section 09 - .20 ac.

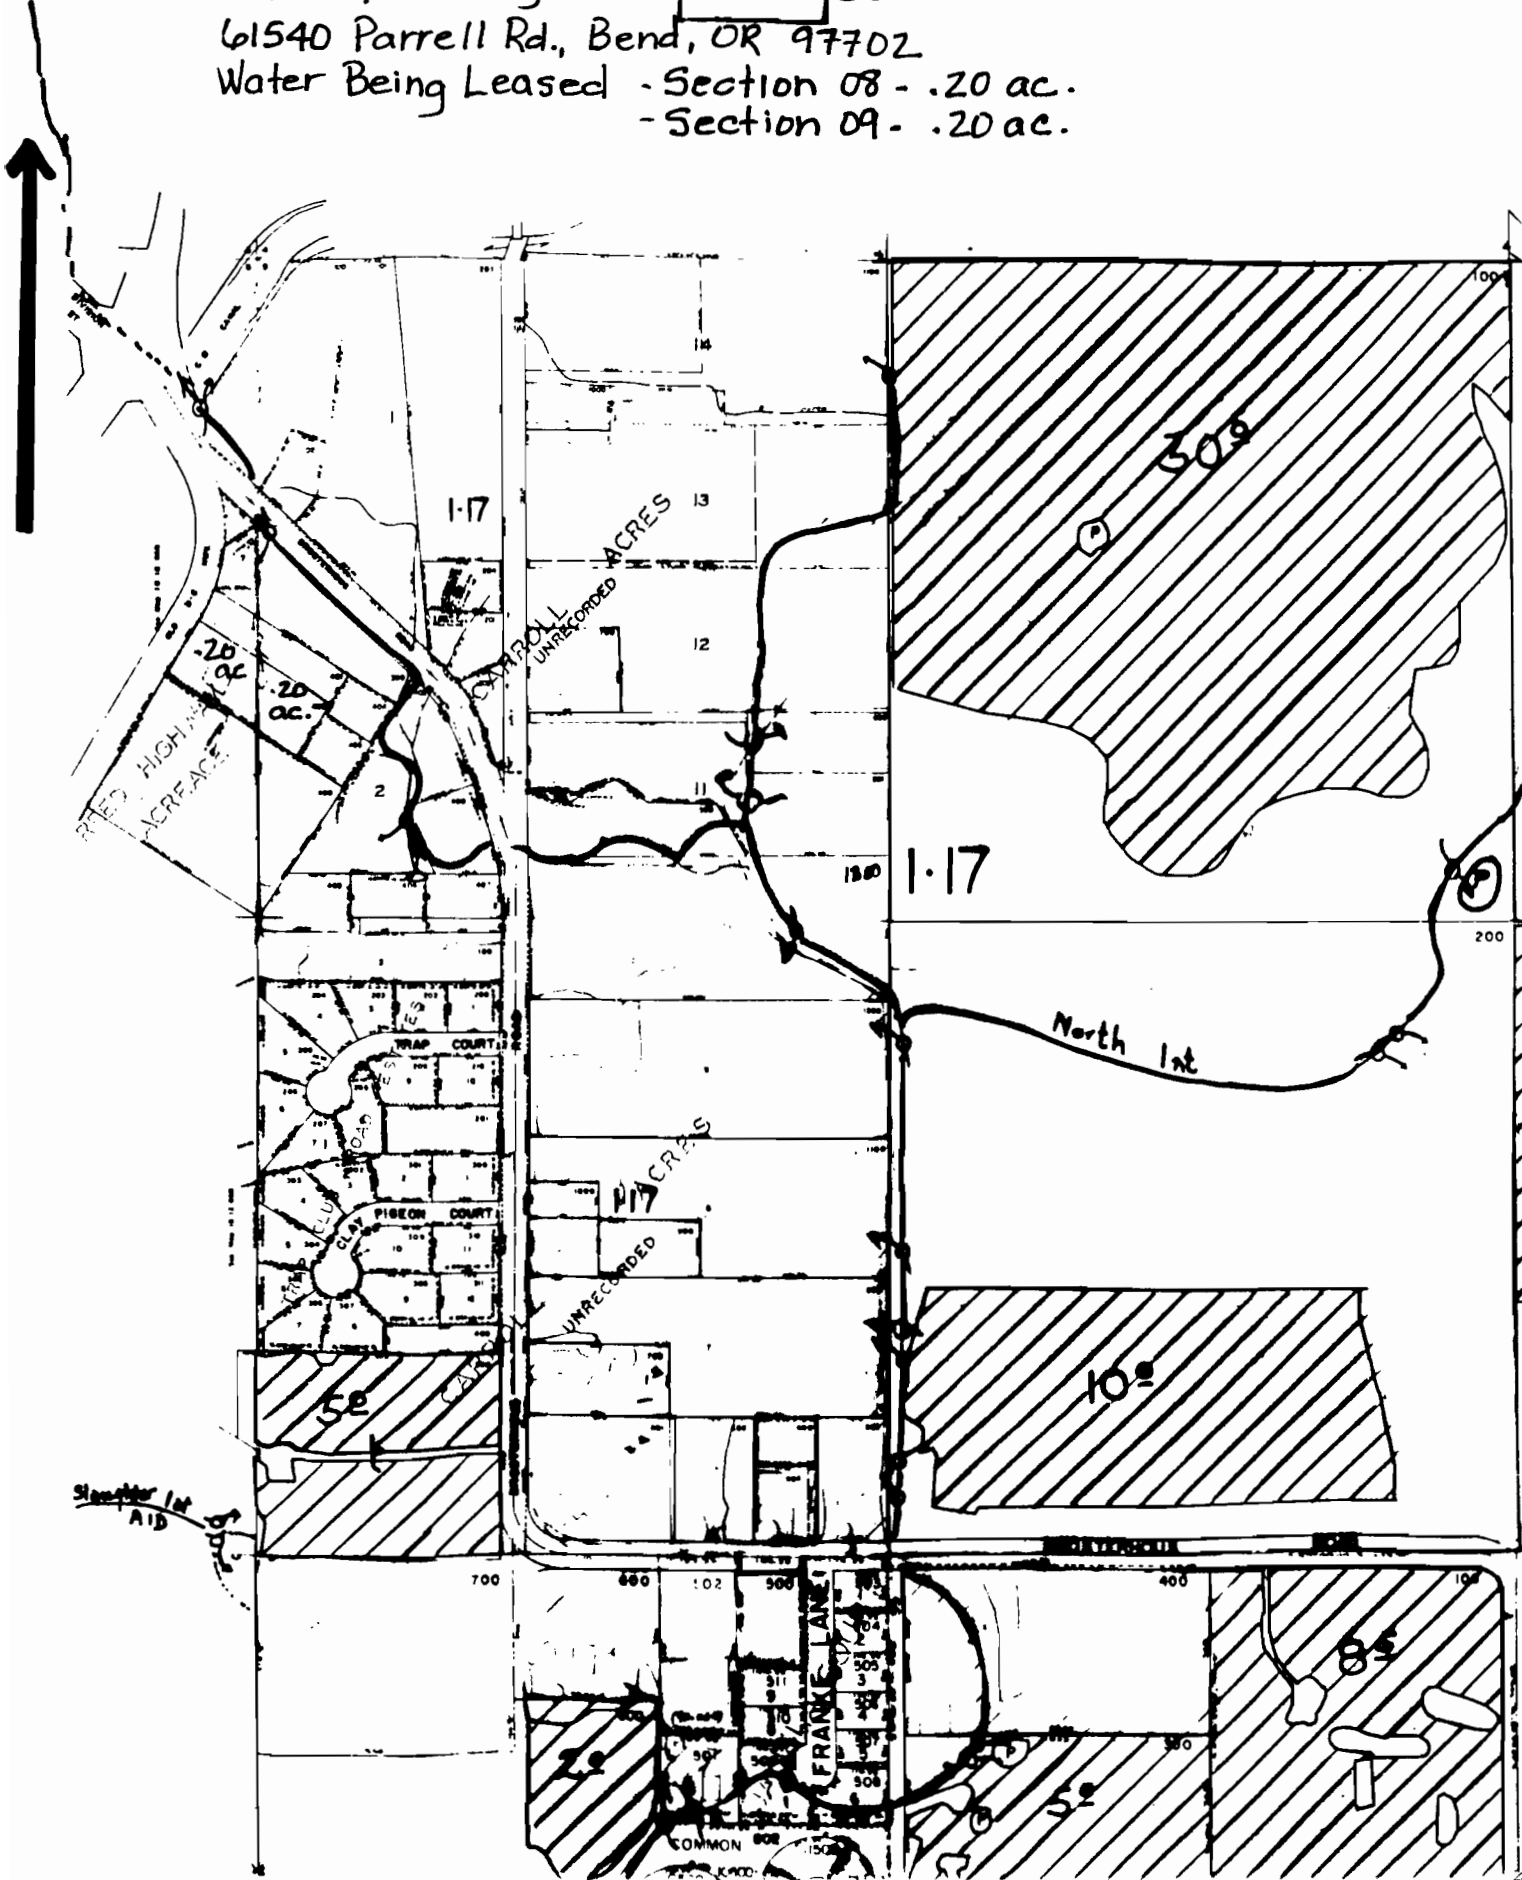


18-12-17 NE NW Tax Lot #906
 18-12-17 NW NE Tax Lot #906
 Property Leasing Water [REDACTED]
 61181 Parrell Rd., Bend, OR 97702
 Water Being Leased Qtr/Qtr NE NW .20 ac
 Qtr/Qtr NW NE .30 ac

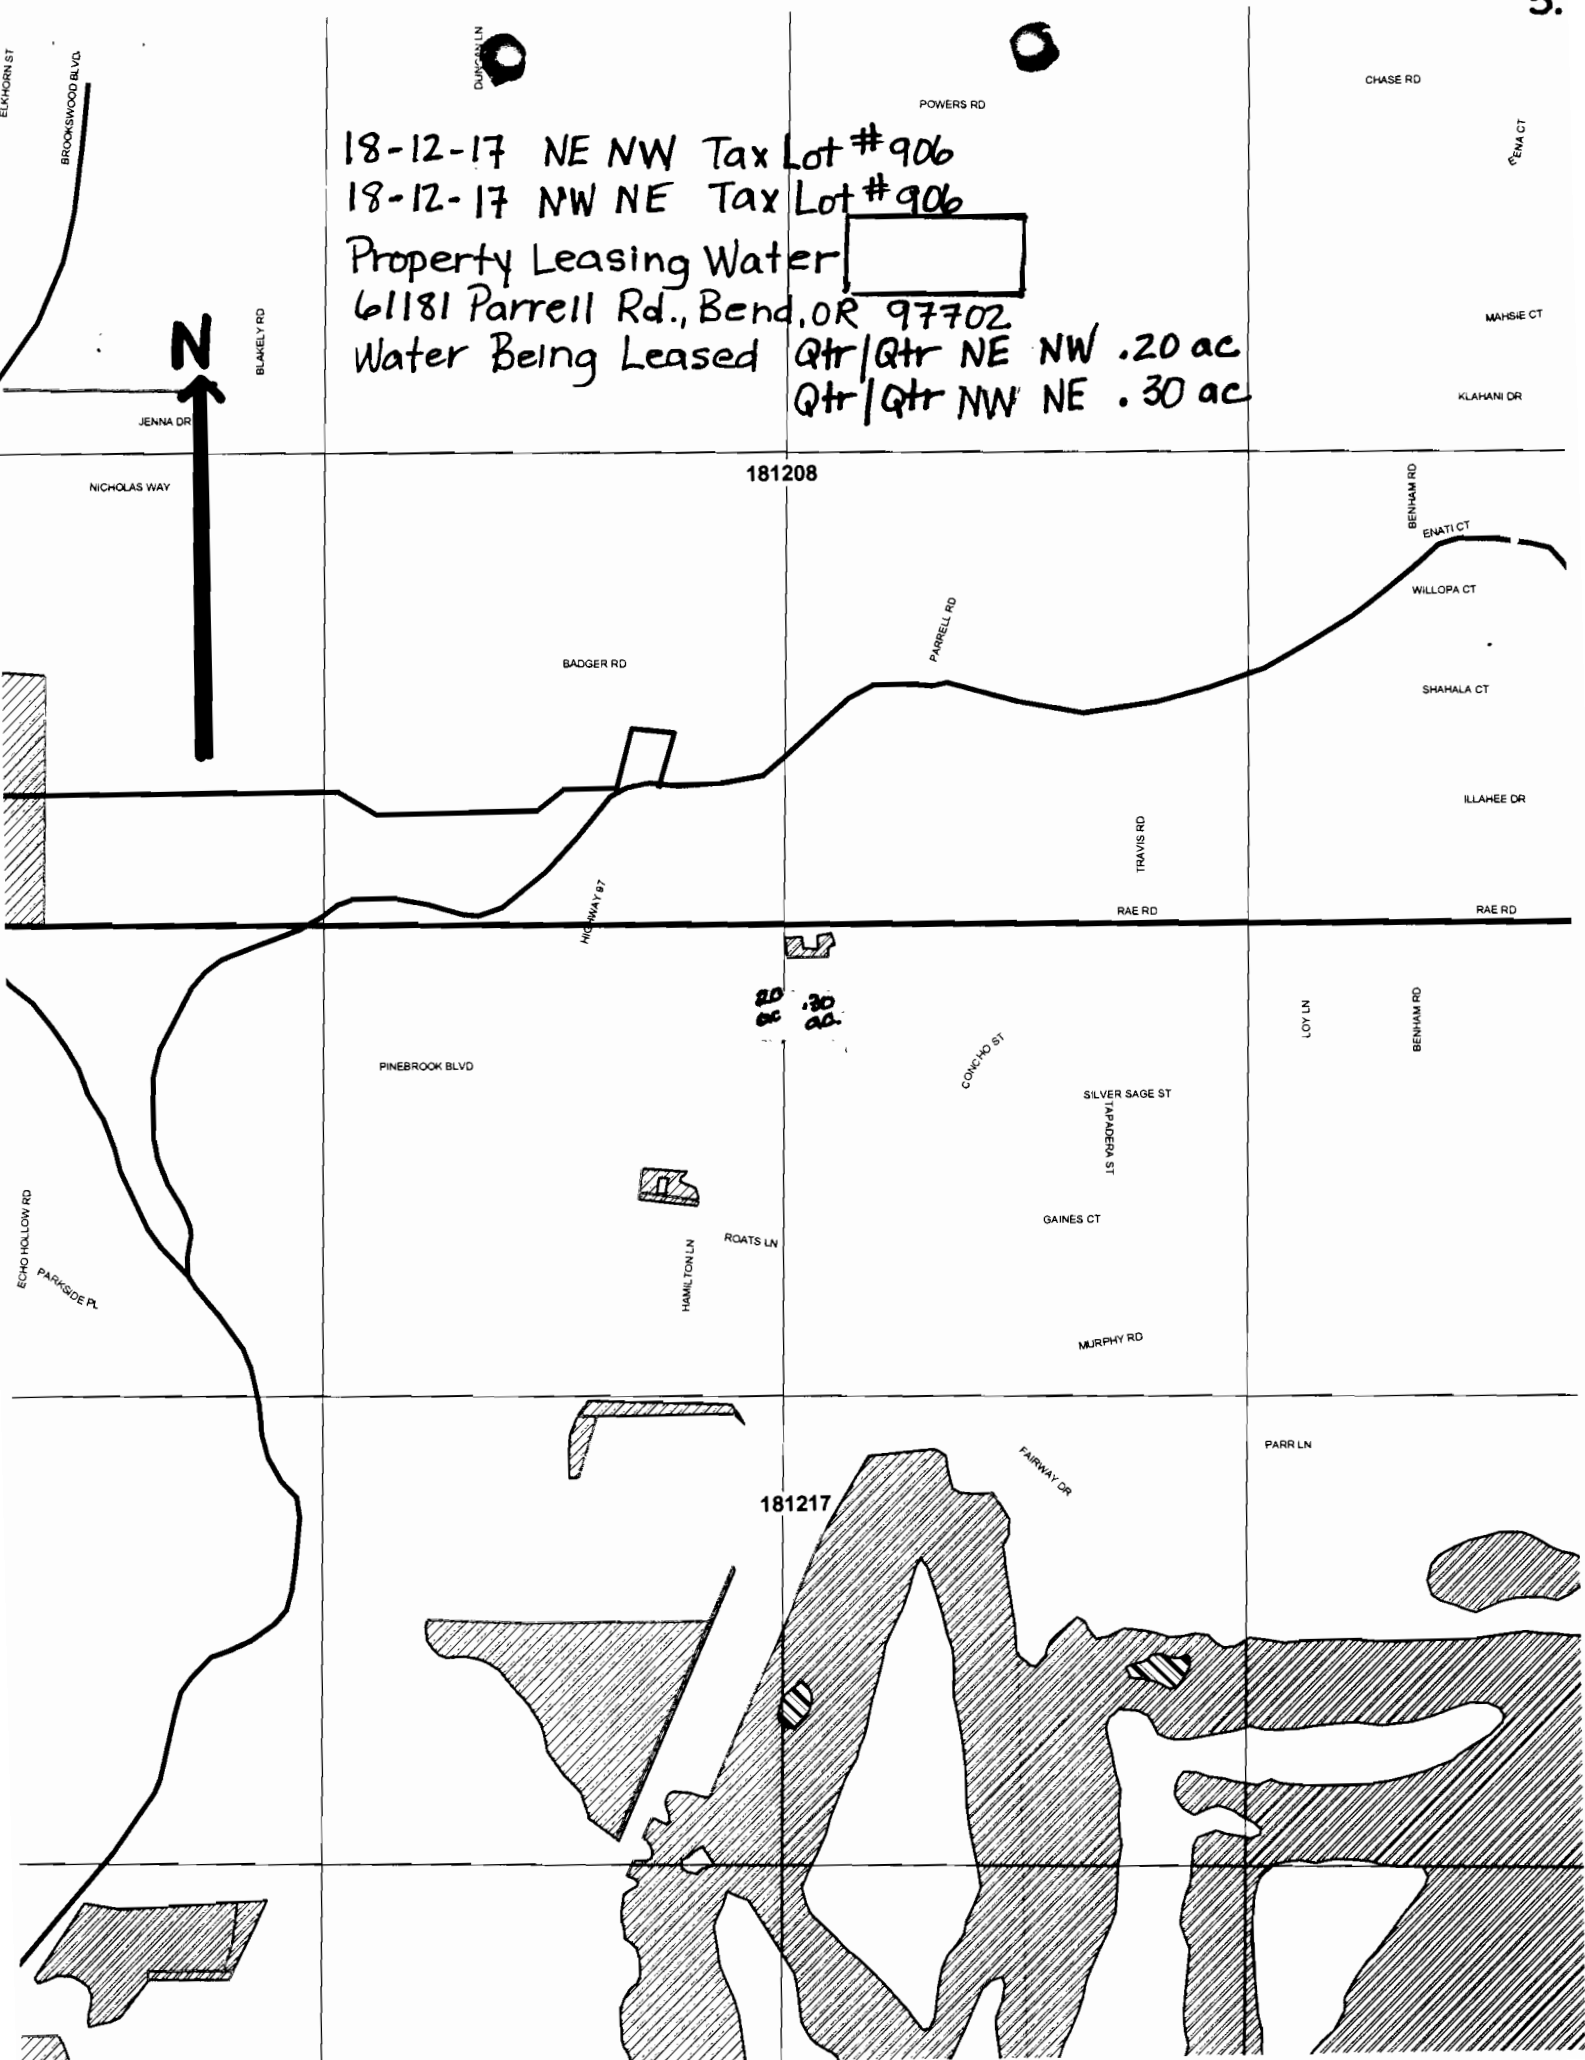

18-12-17 NE NW Tax Lot #1001
 Scale 1" = 400"
 Property Leasing Water
 61165 Parrell Rd., Bend, OR 97702
 Water Being Leased .50 ac.

ELKHORN ST

BROOKSWOOD BLVD

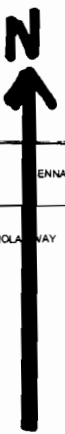

ENNA DR

BLAKELY RD

NICHOLA WAY

MAHSIE CT

KLAHANI DR

181208

BENHAM RD

ENATI CT

WILLOPA CT

SHAHALA CT

ILLAHEE DR

BADGER RD

TRAVIS RD

RAE RD

RAE RD

HIGHWAY 97

PINEBROOK BLVD

.50 ac

CONO RD ST

SILVER SAGE ST

TAFADERA ST

GAINES CT

LOY LN

BENHAM RD

ECHO HOLLOW RD

PARKSIDE Pk



HAMILTON LN

ROATS LN

MURPHY RD





181217

FAIRWAY DR

PARR LN

PARRELL RD

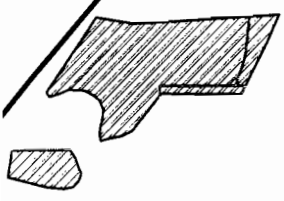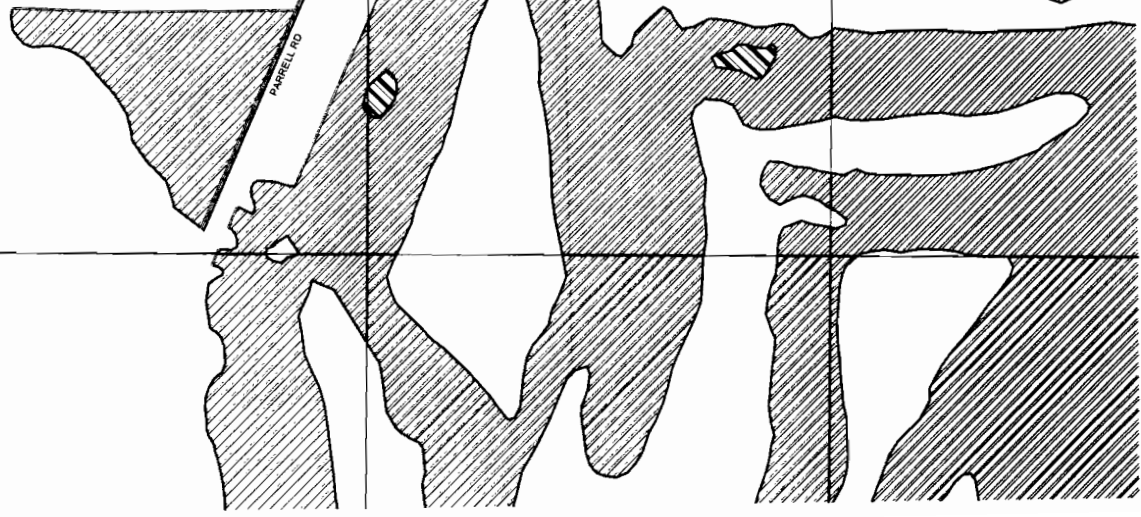

18-12-08 SW NW Tax Lot #2200


Scale 1" = 400'


Property Leasing Water

61447 Blakely Rd., Bend, OR Scale 1" = 400' Sectic

Water Being Leased 97702
.78 ac

ARNOLD IRR' DESCHUTES

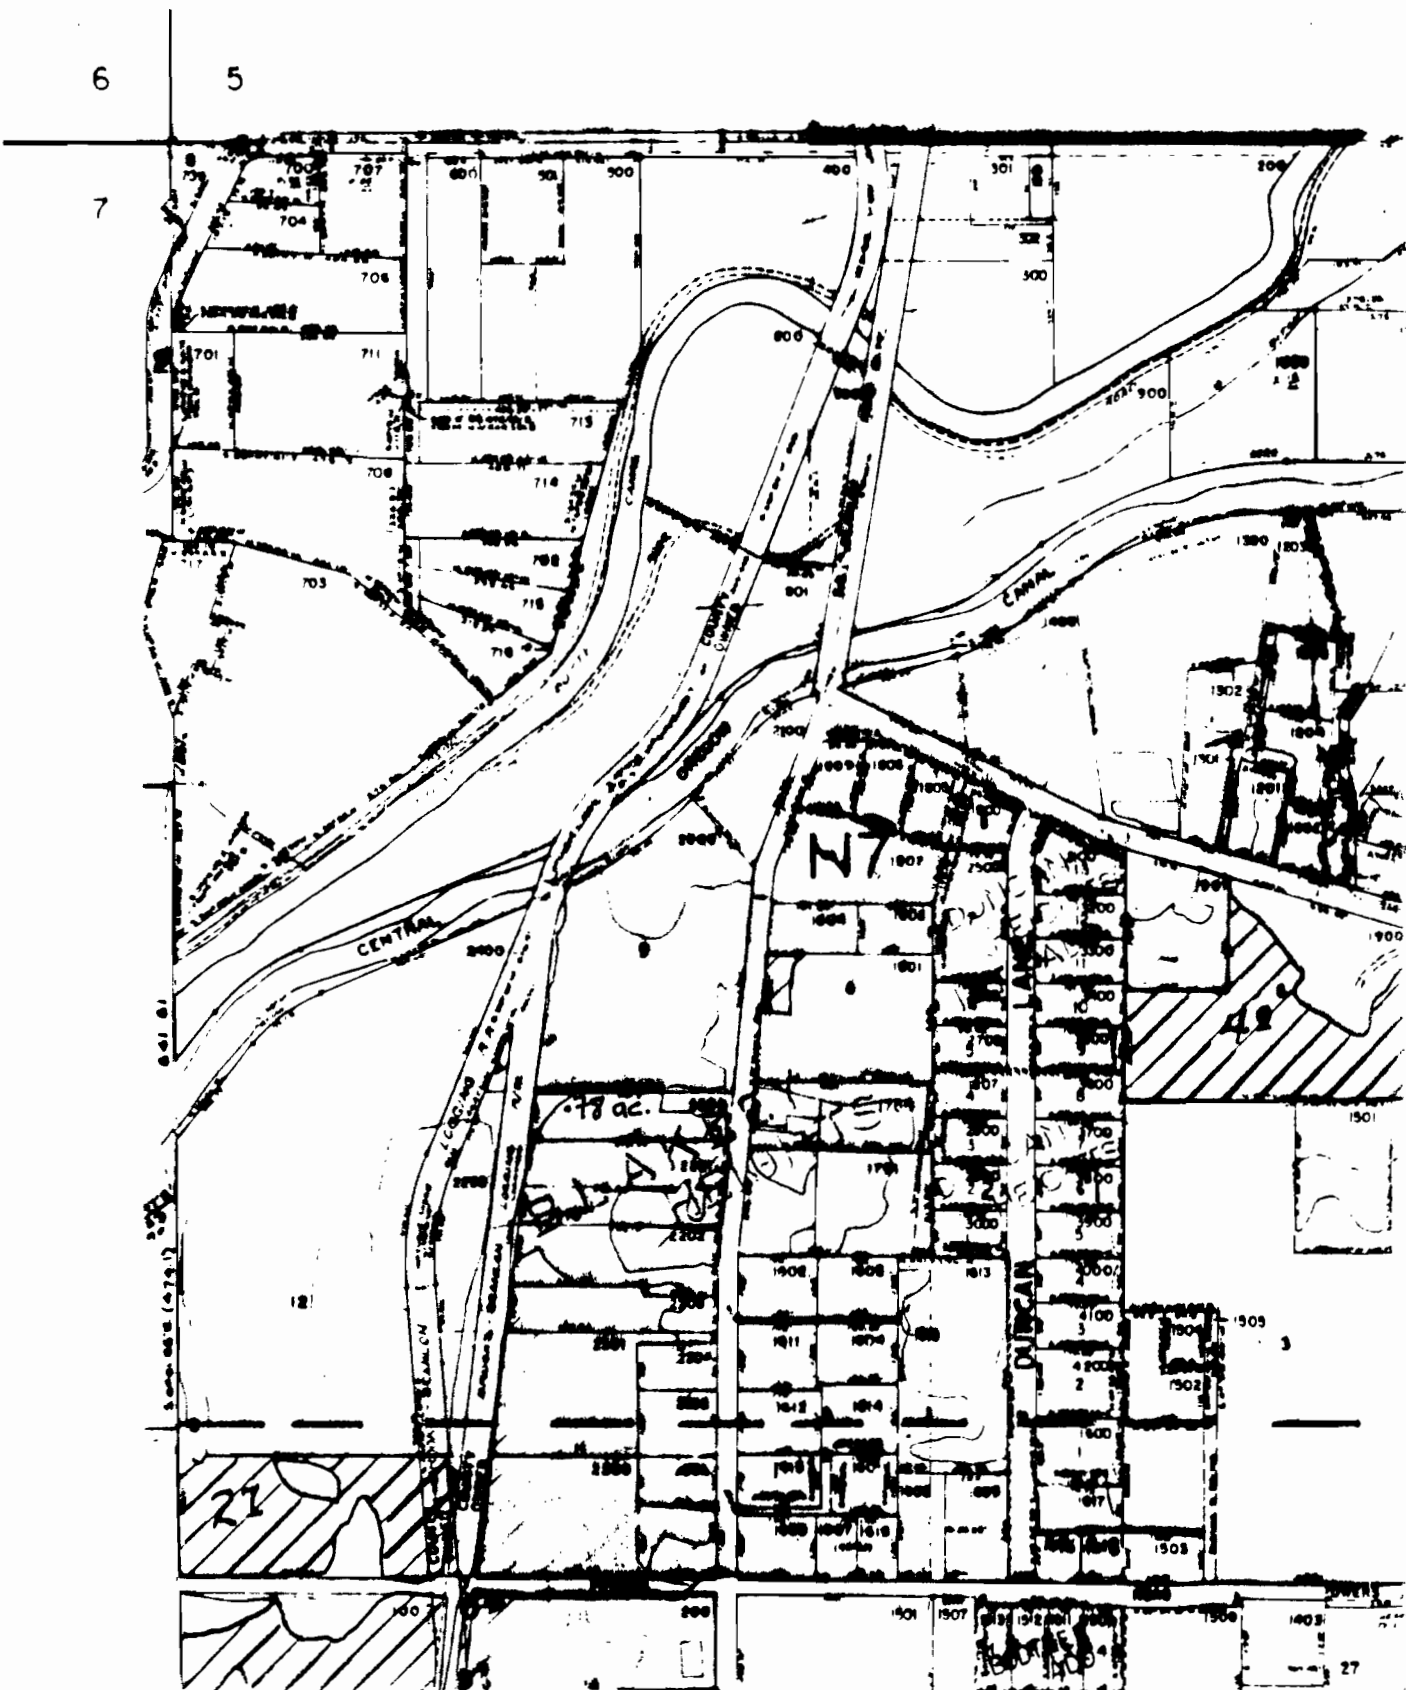


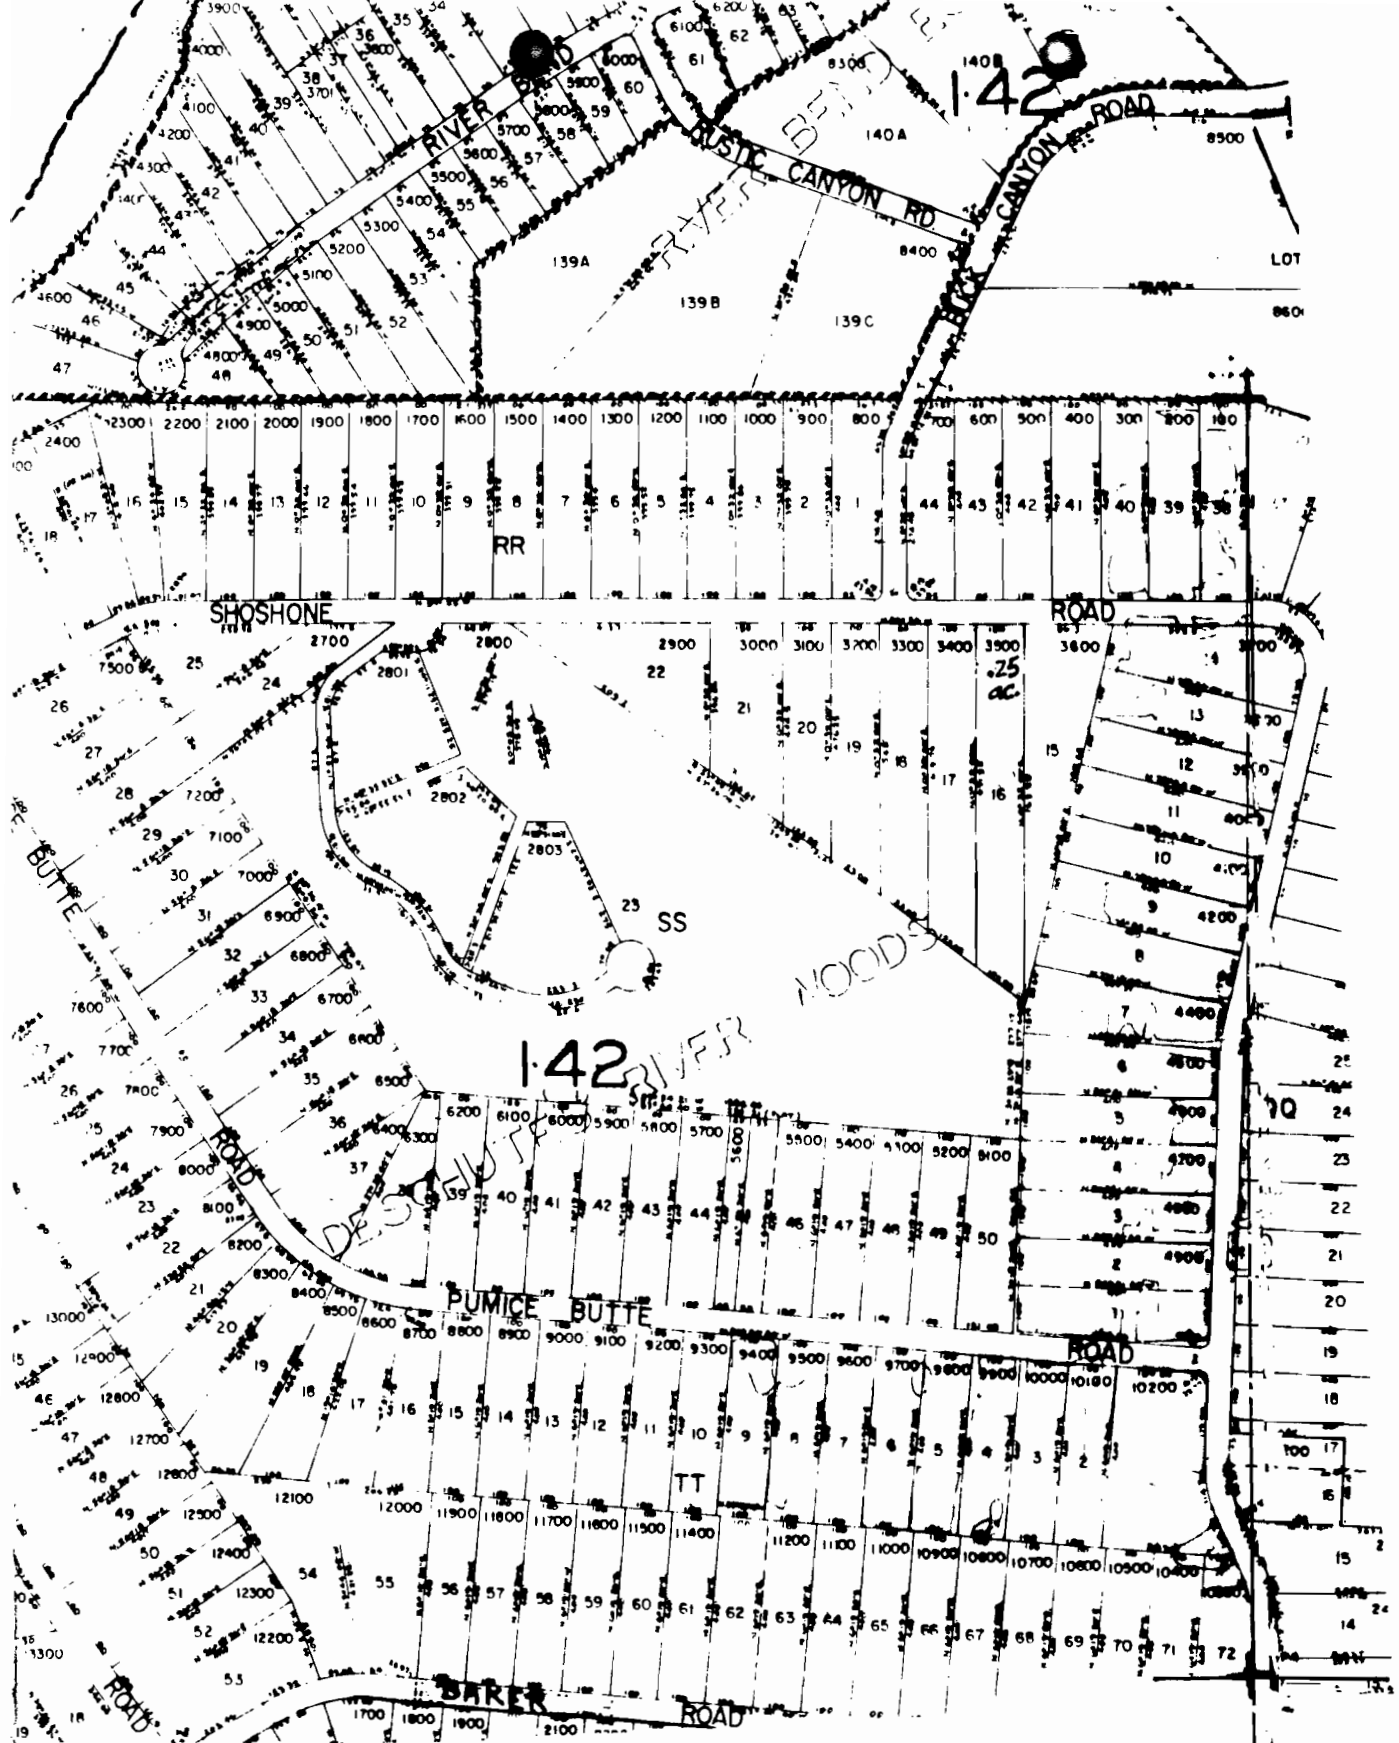

18-11-23 NESE Tax Lot # 3500

Scale 1" = 400'


Property Leasing Water

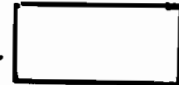


18-11-2!

19161 Shoshone Rd., Bend, OR 97702

Water Being Leased .25 ac.

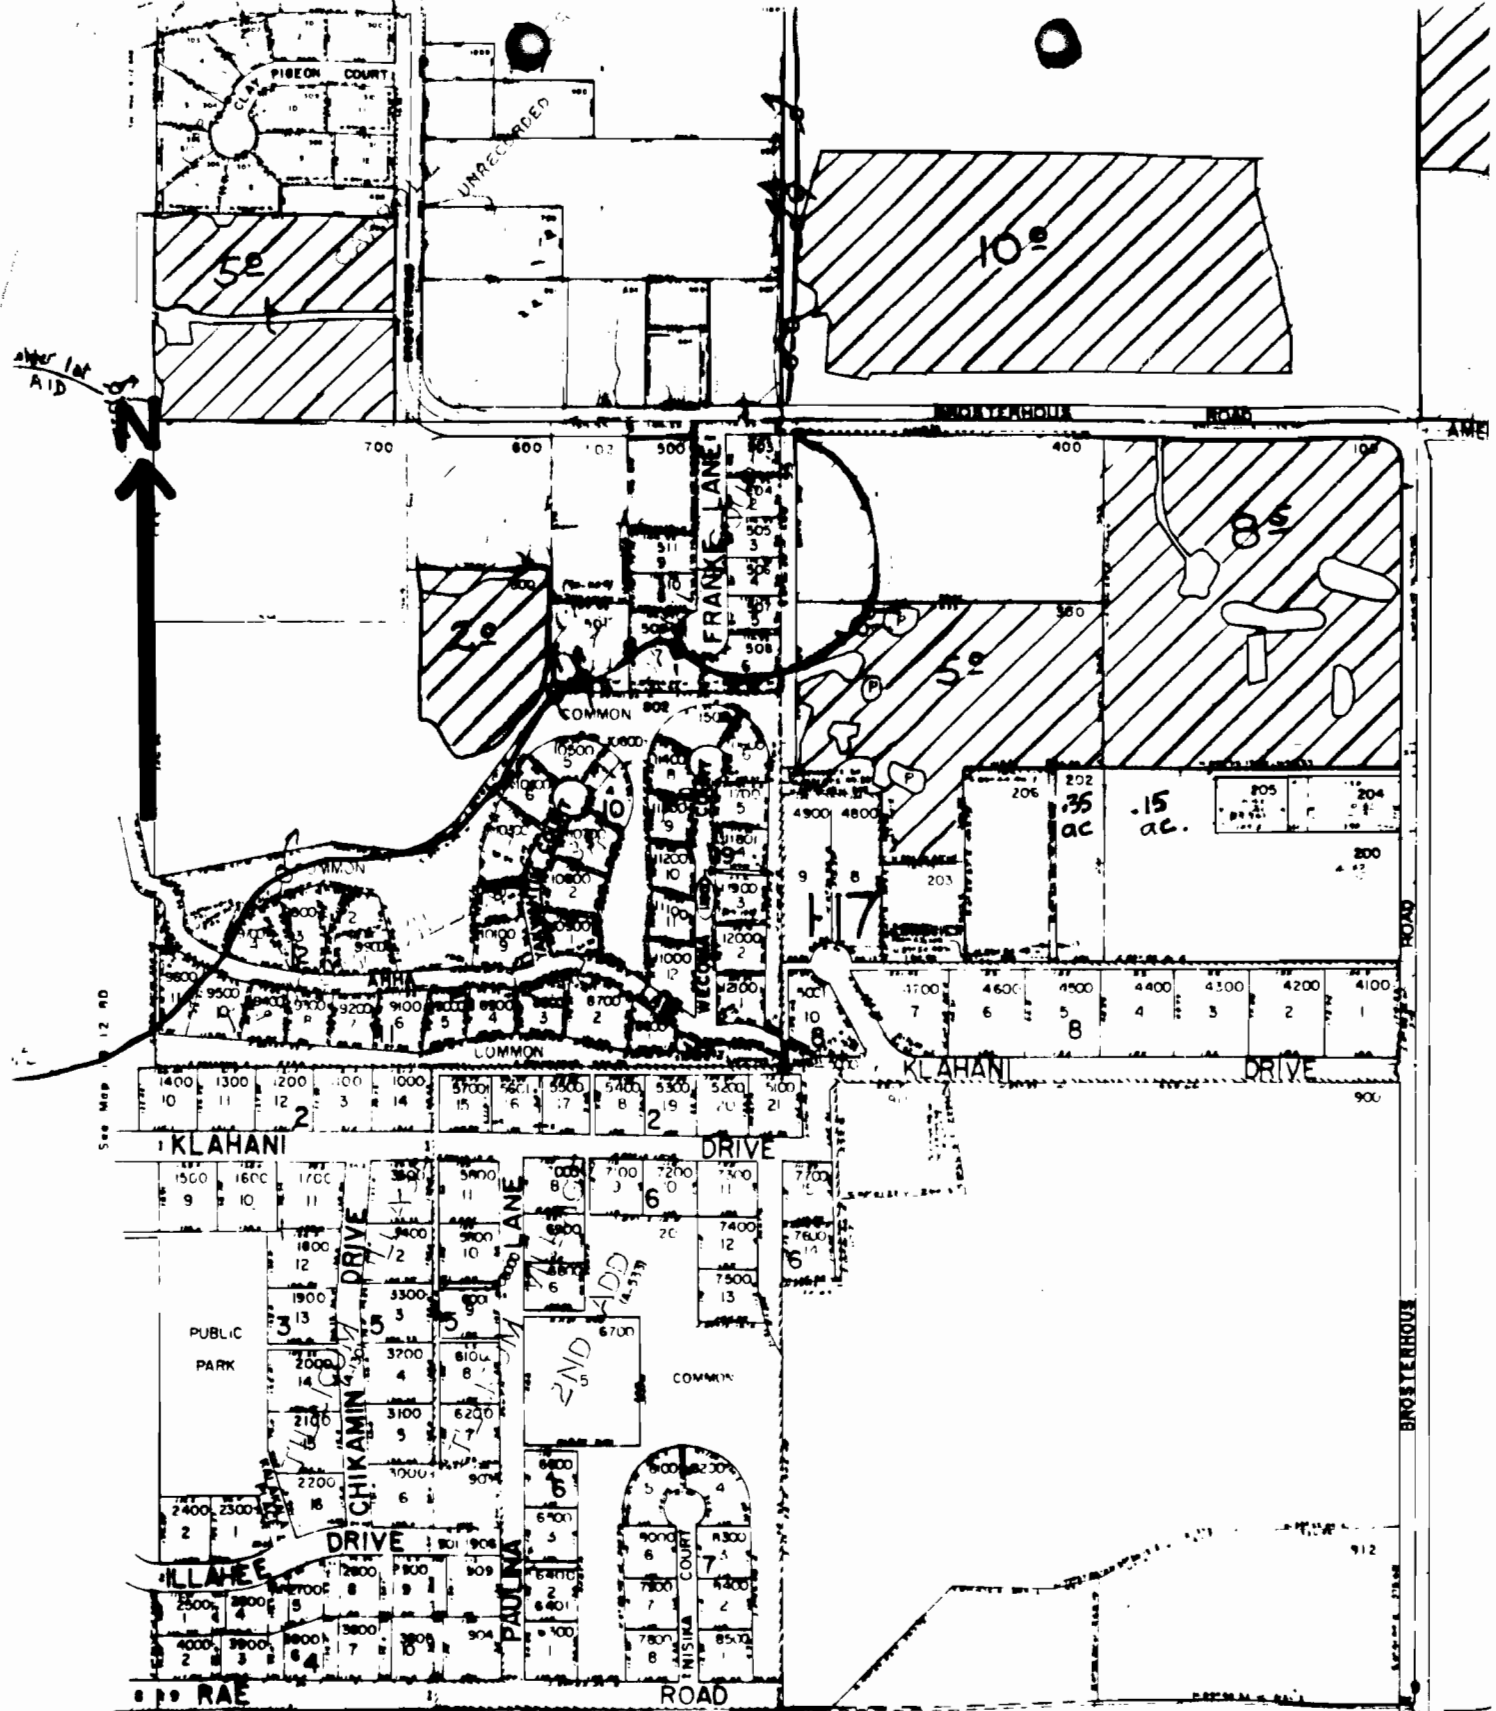

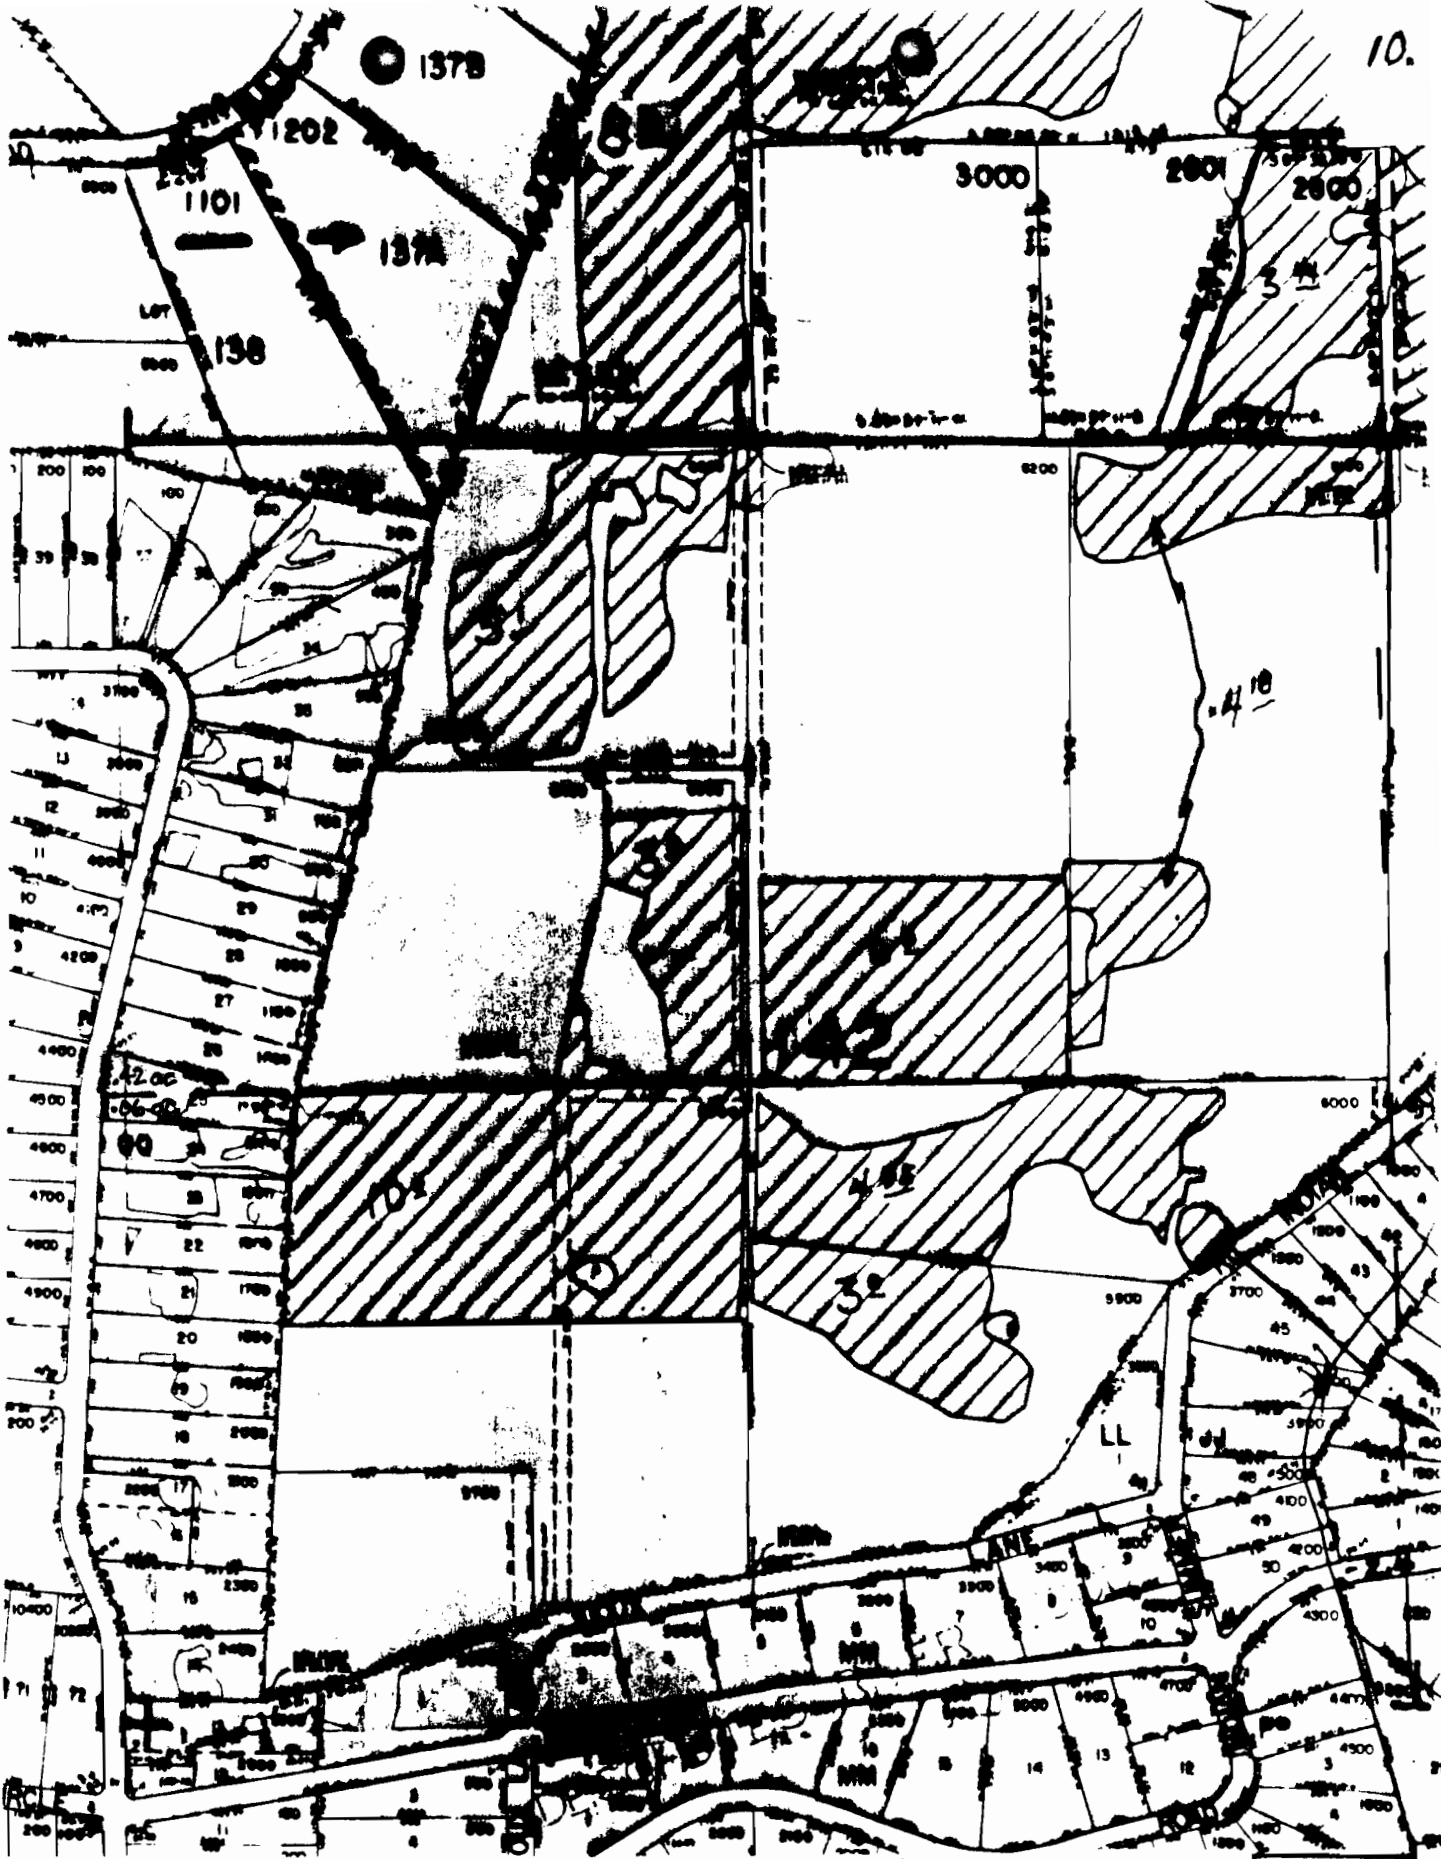

18-11-24 NWSW Tax Lot # 1300
 18-11-24 SW SW Tax Lot # 1300
 19228 Shoshone Rd., Bend, OR
 Water Being Leased 97702
 Qtr Qtr NW SW .42 ac
 Qtr Qtr SW SW .06 ac


Scale 1" = 400'
 Property Leasing Water


MAIN CANAL

N DISTRICT Y, OREGON

18 S., R. 11 E., W.M.
half

18-11-26 NE NE 5300
Scale 1"=400'
Property Leasing Water
19154 Choctaw Rd., Bend, OR 97702
Water Being Leased .24ac

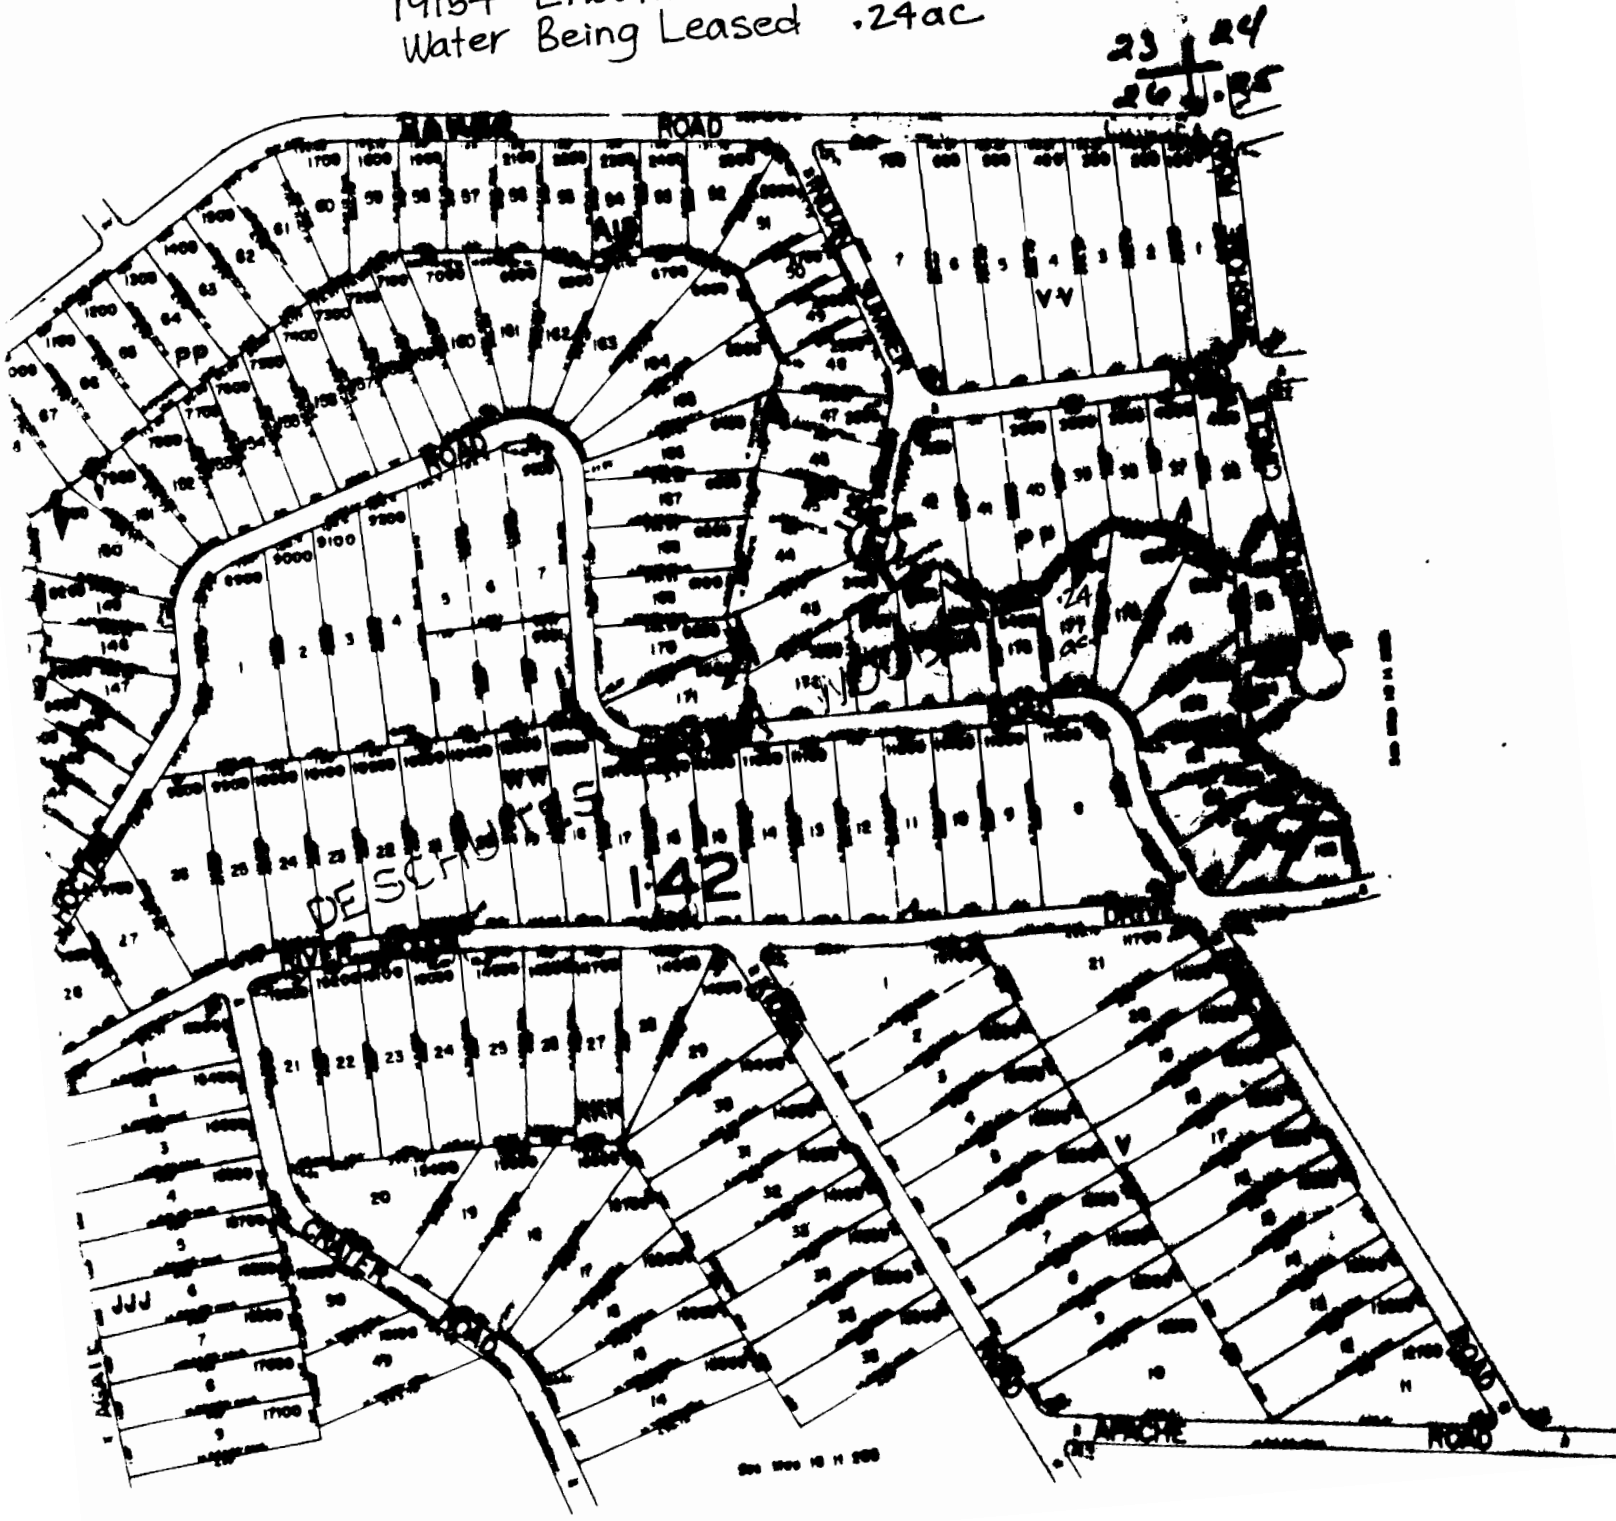

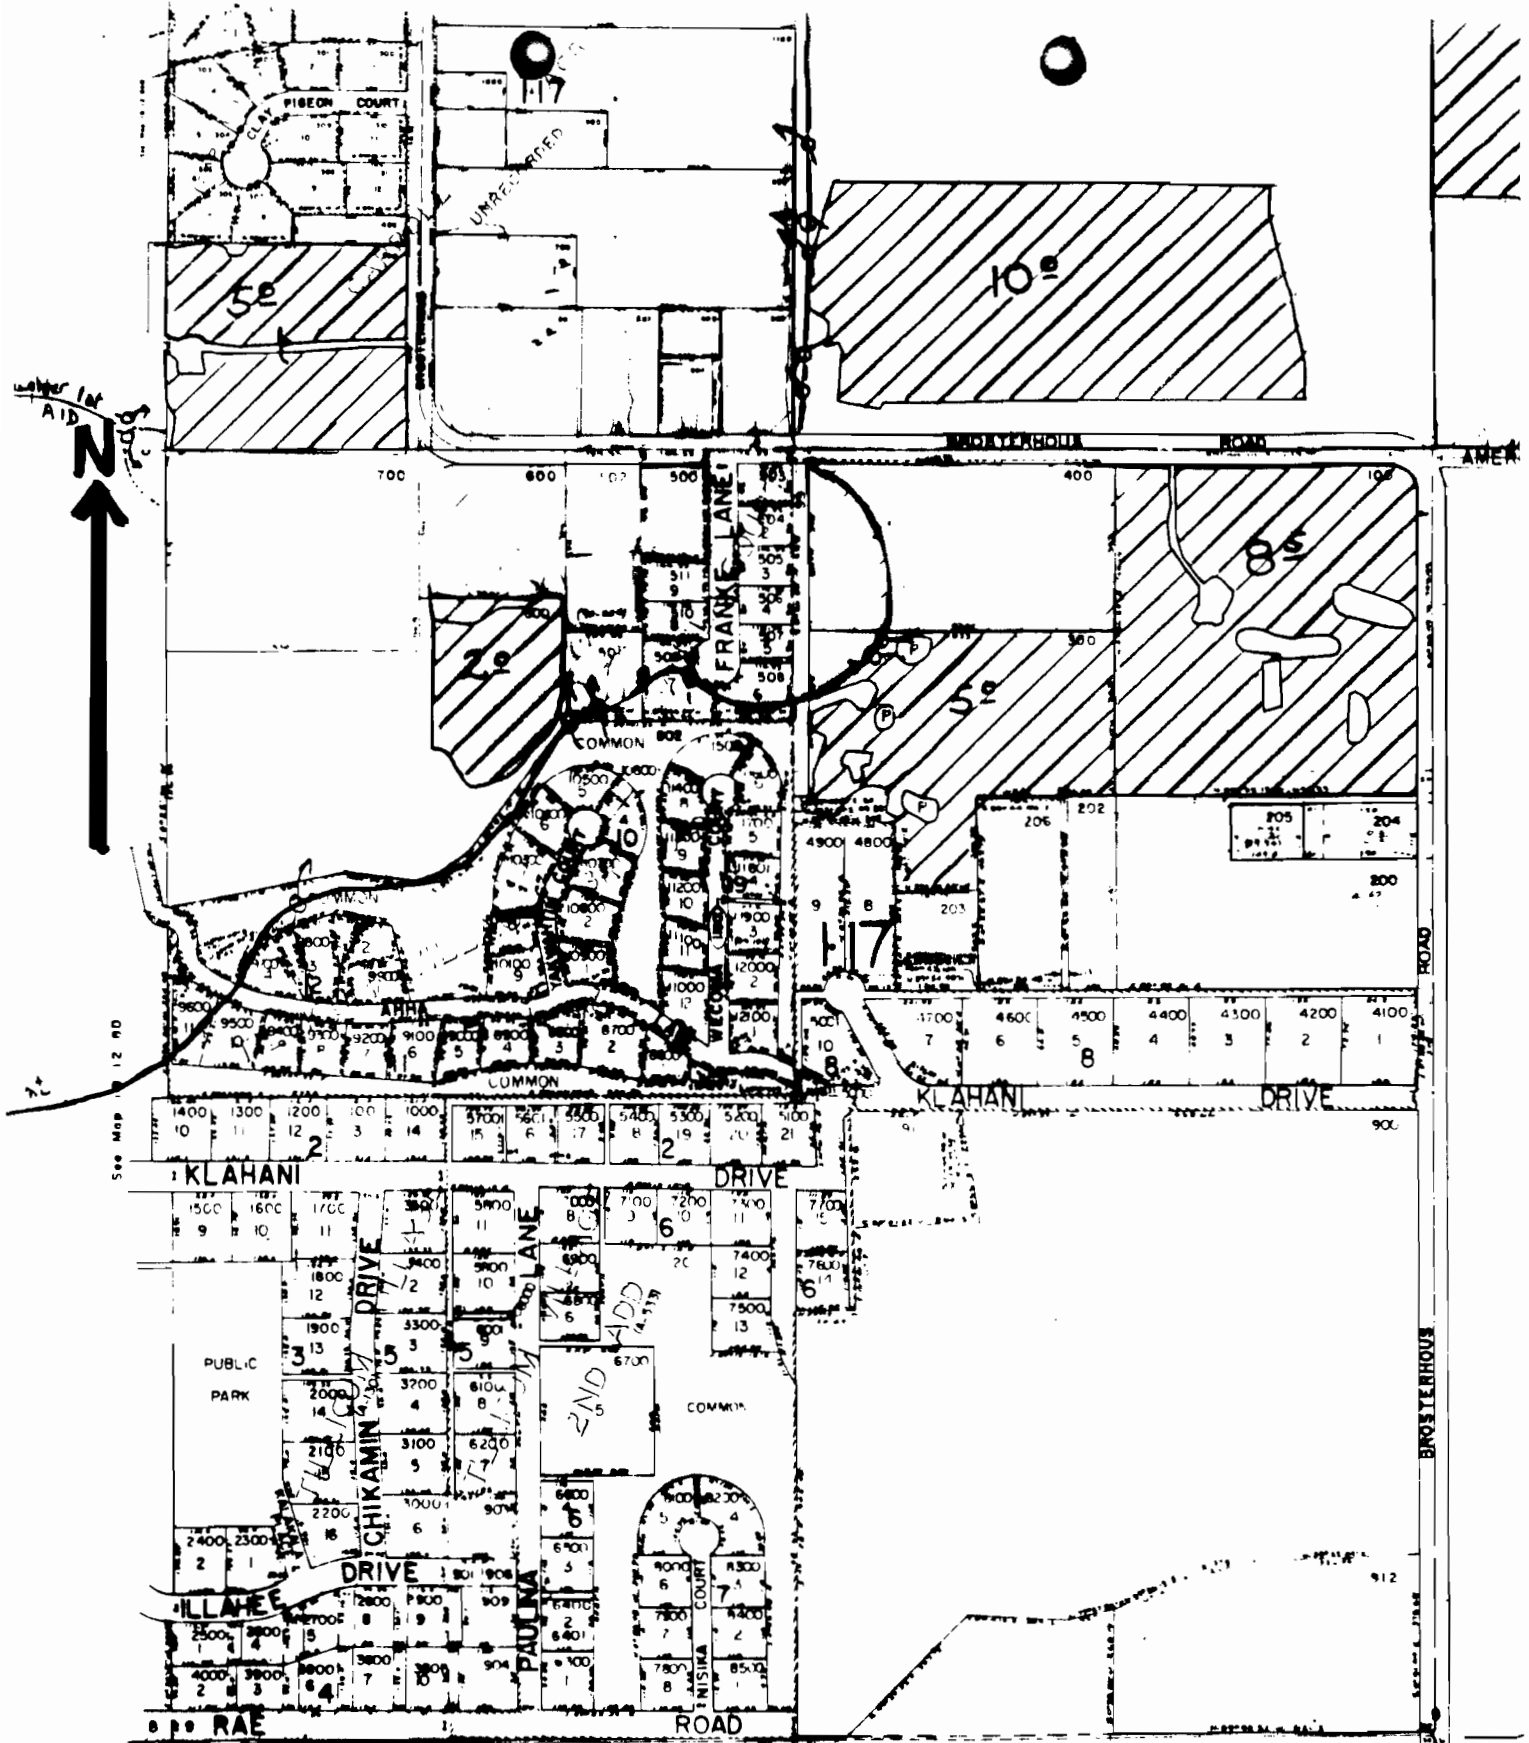



18-12-09 NE SW Tax Lot # 205
 Scale 1" = 400'
 Property Leasing Water
 61349 Brosterhouse Rd.
 Bend, OR 97702
 Water Being Leased .25 ac.

ARNOLD DESCHU

18-11-25 NW NW Tax Lot # 1200
Scale 1" = 400'
Property Leasing Water
19262 Shoshone Rd., Bend, OR 97702
Water Being Leased .40 ac.

Scale 1" = 400'

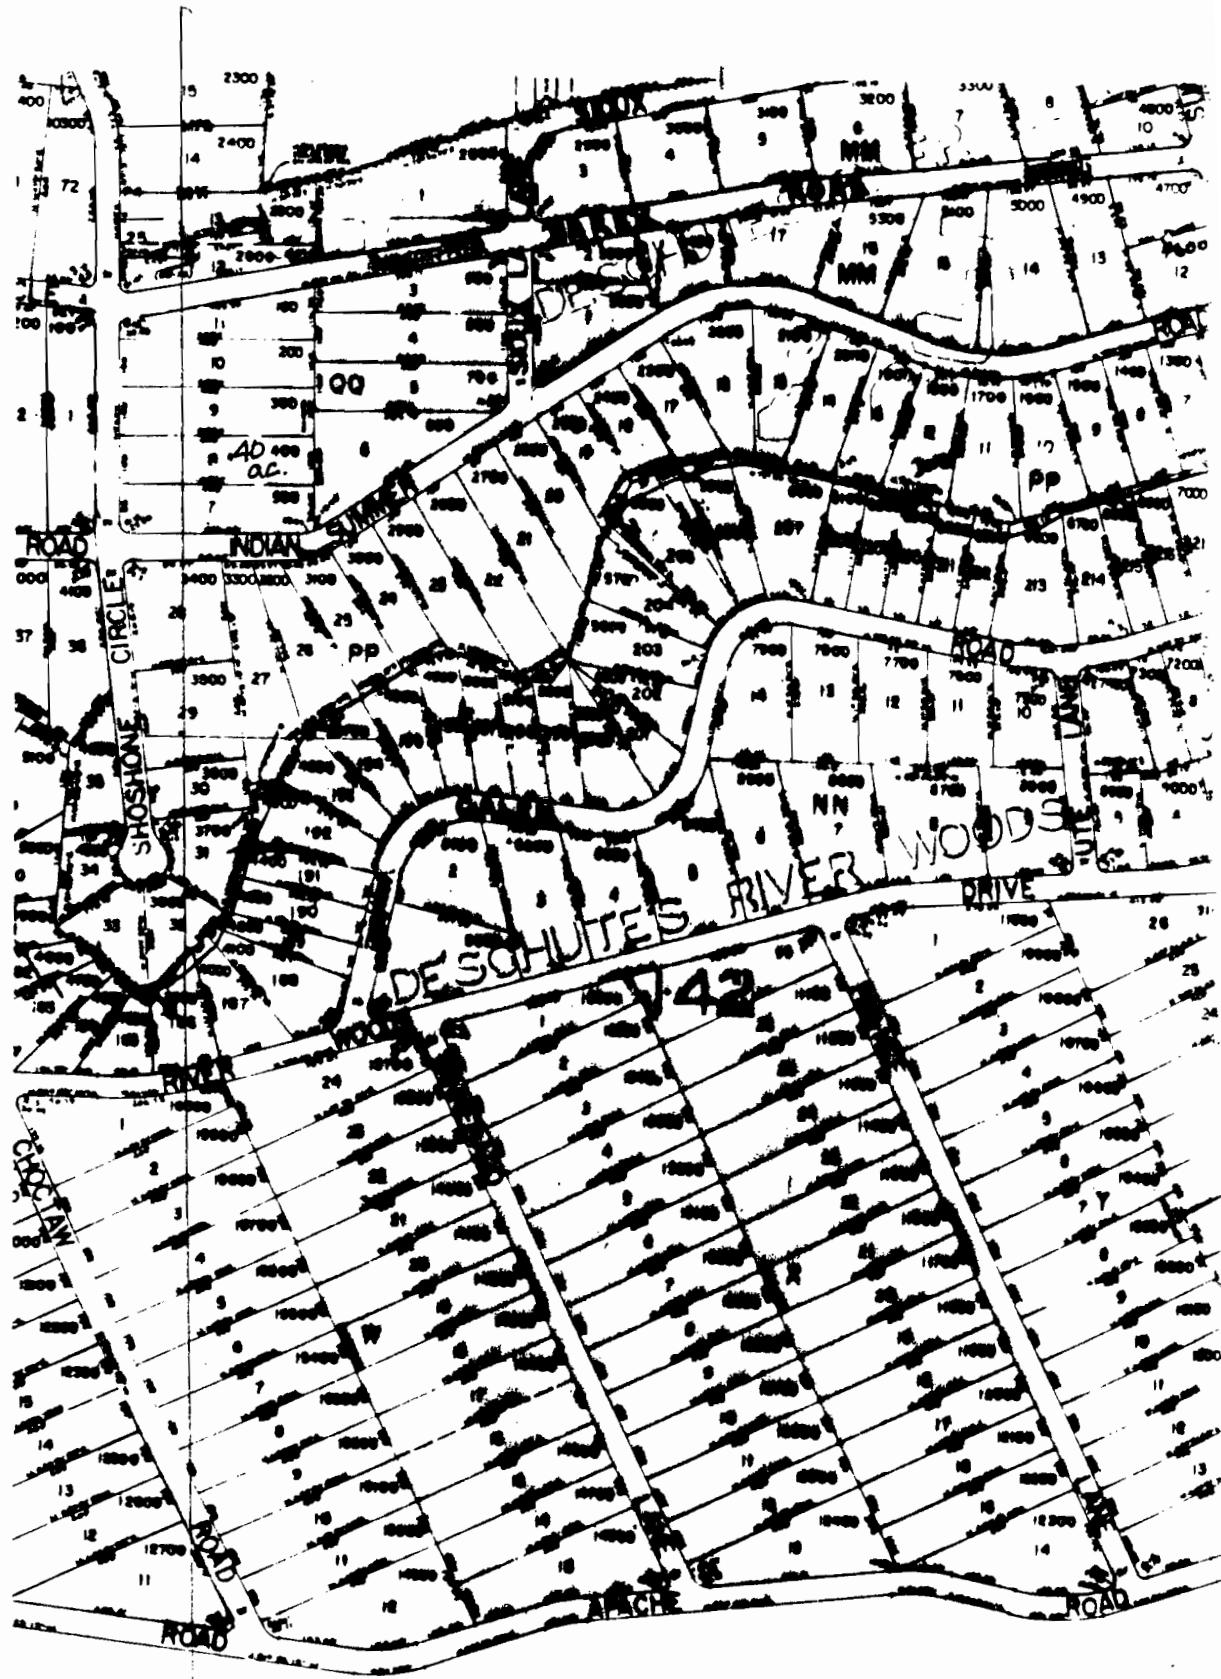


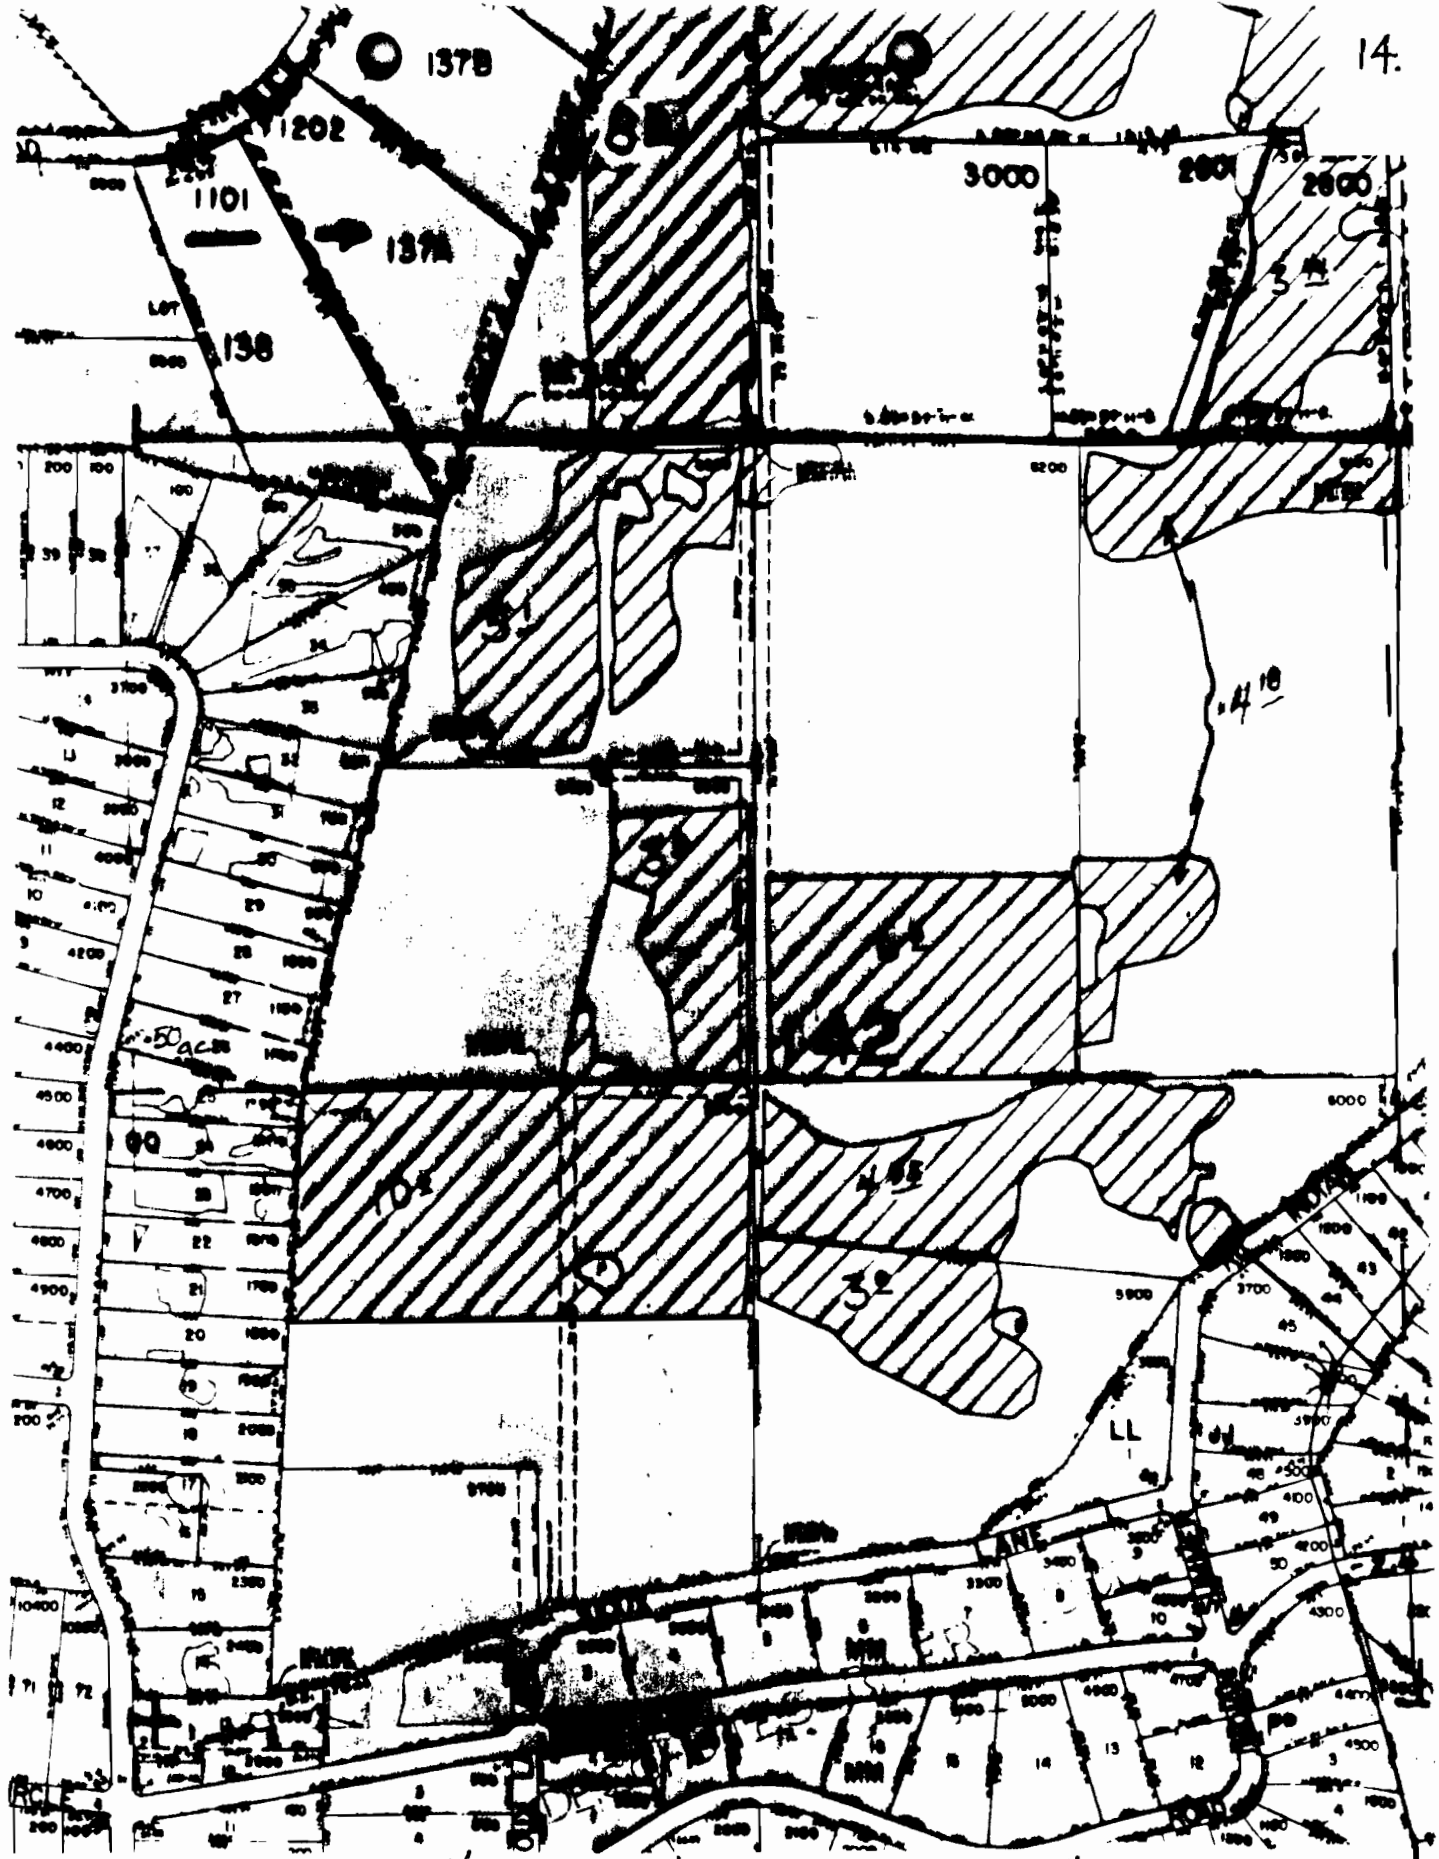

18-11-24 NW SW Tax Lot #1200
Property Leasing Water
19226 Shoshone Rd.,
Bend, OR 97702
Water Being Leased .50ac

Scale 1" = 400'


MAIN CANAL

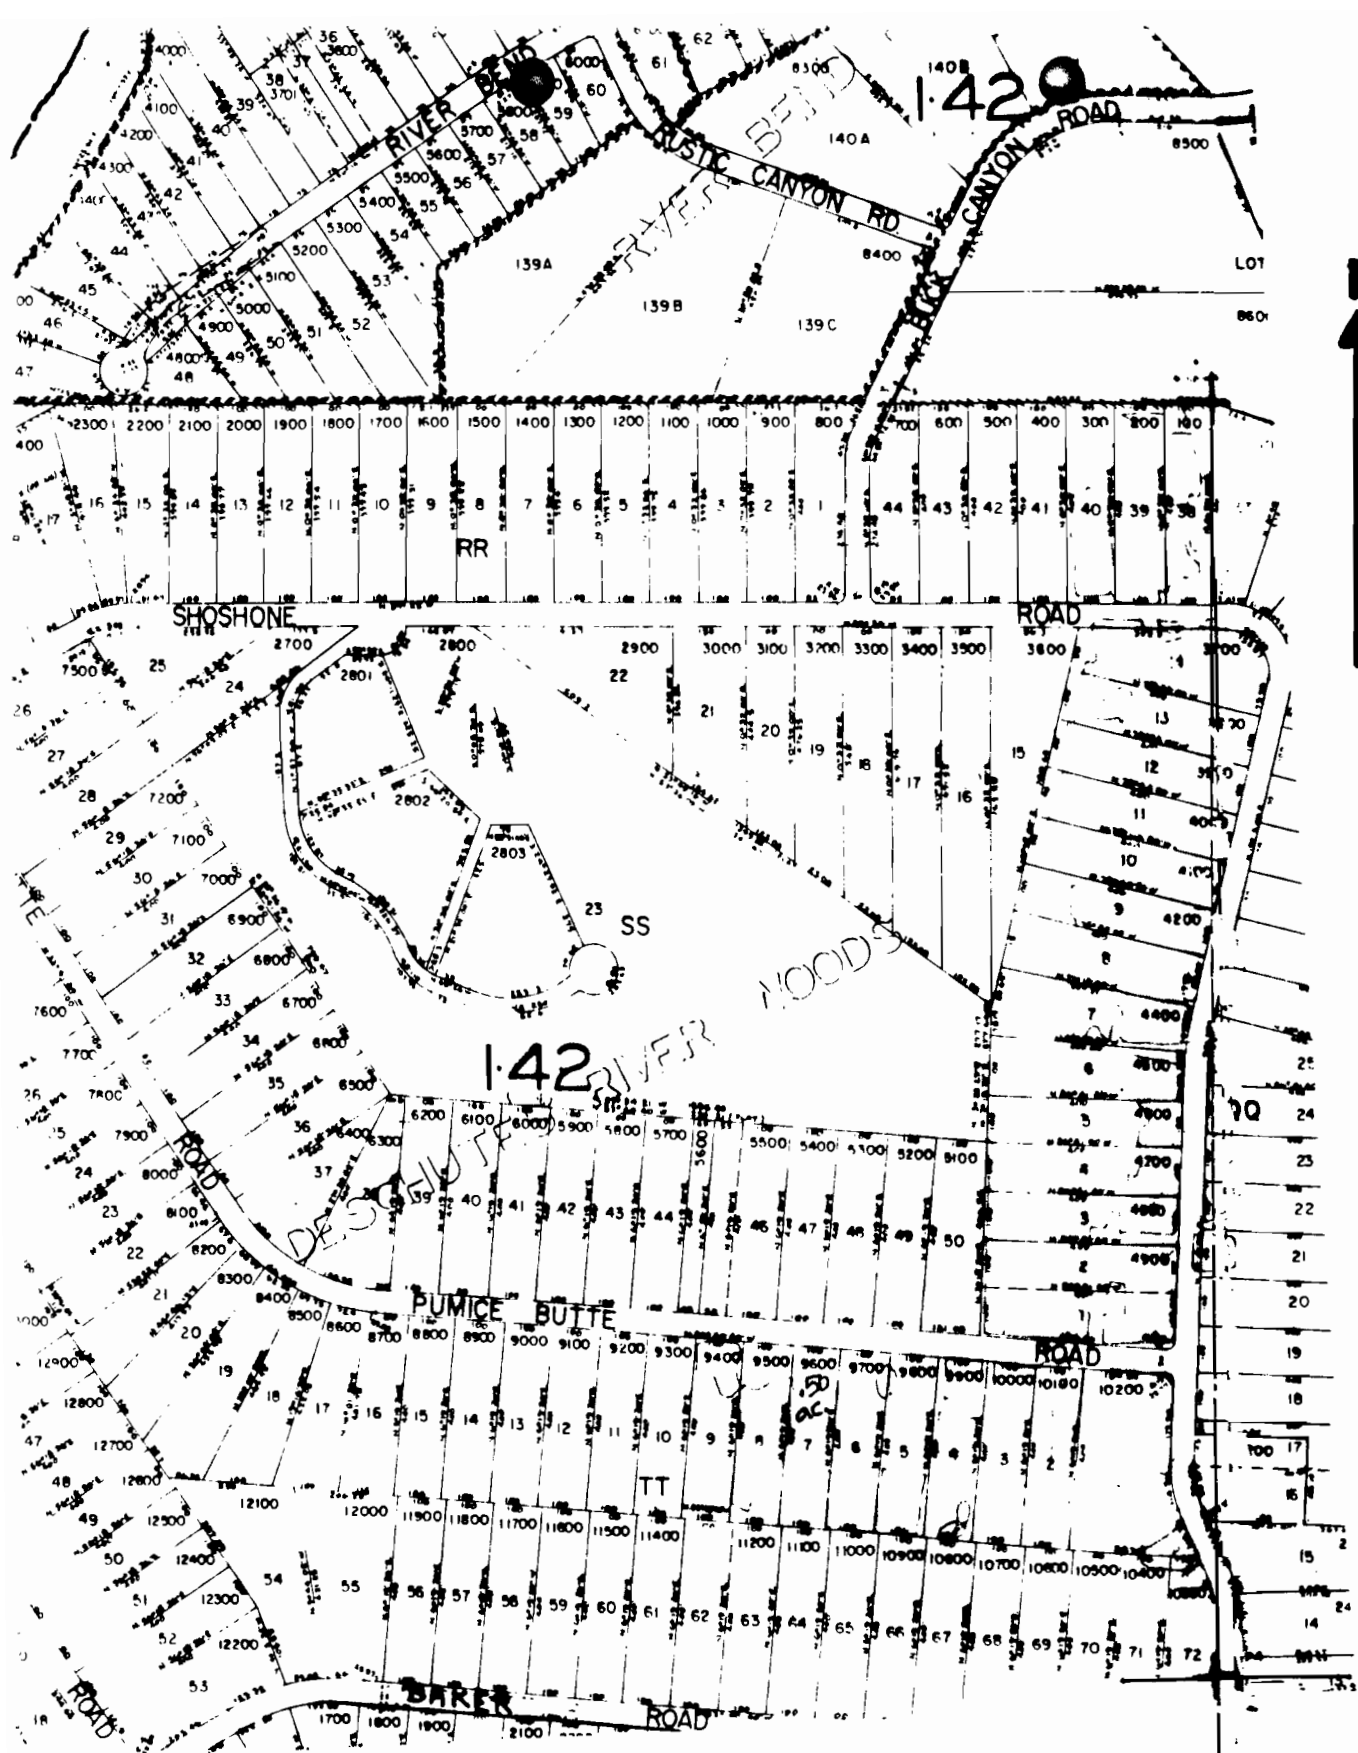

18-11-23 SESE Tax Lot#9600

Scale 1" = 400'


Property Leasing Water

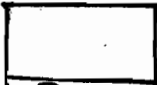

19137 Pumice Butte Rd, Bend, OR 97702

Water Being Leased .50 ac.

18-11-23

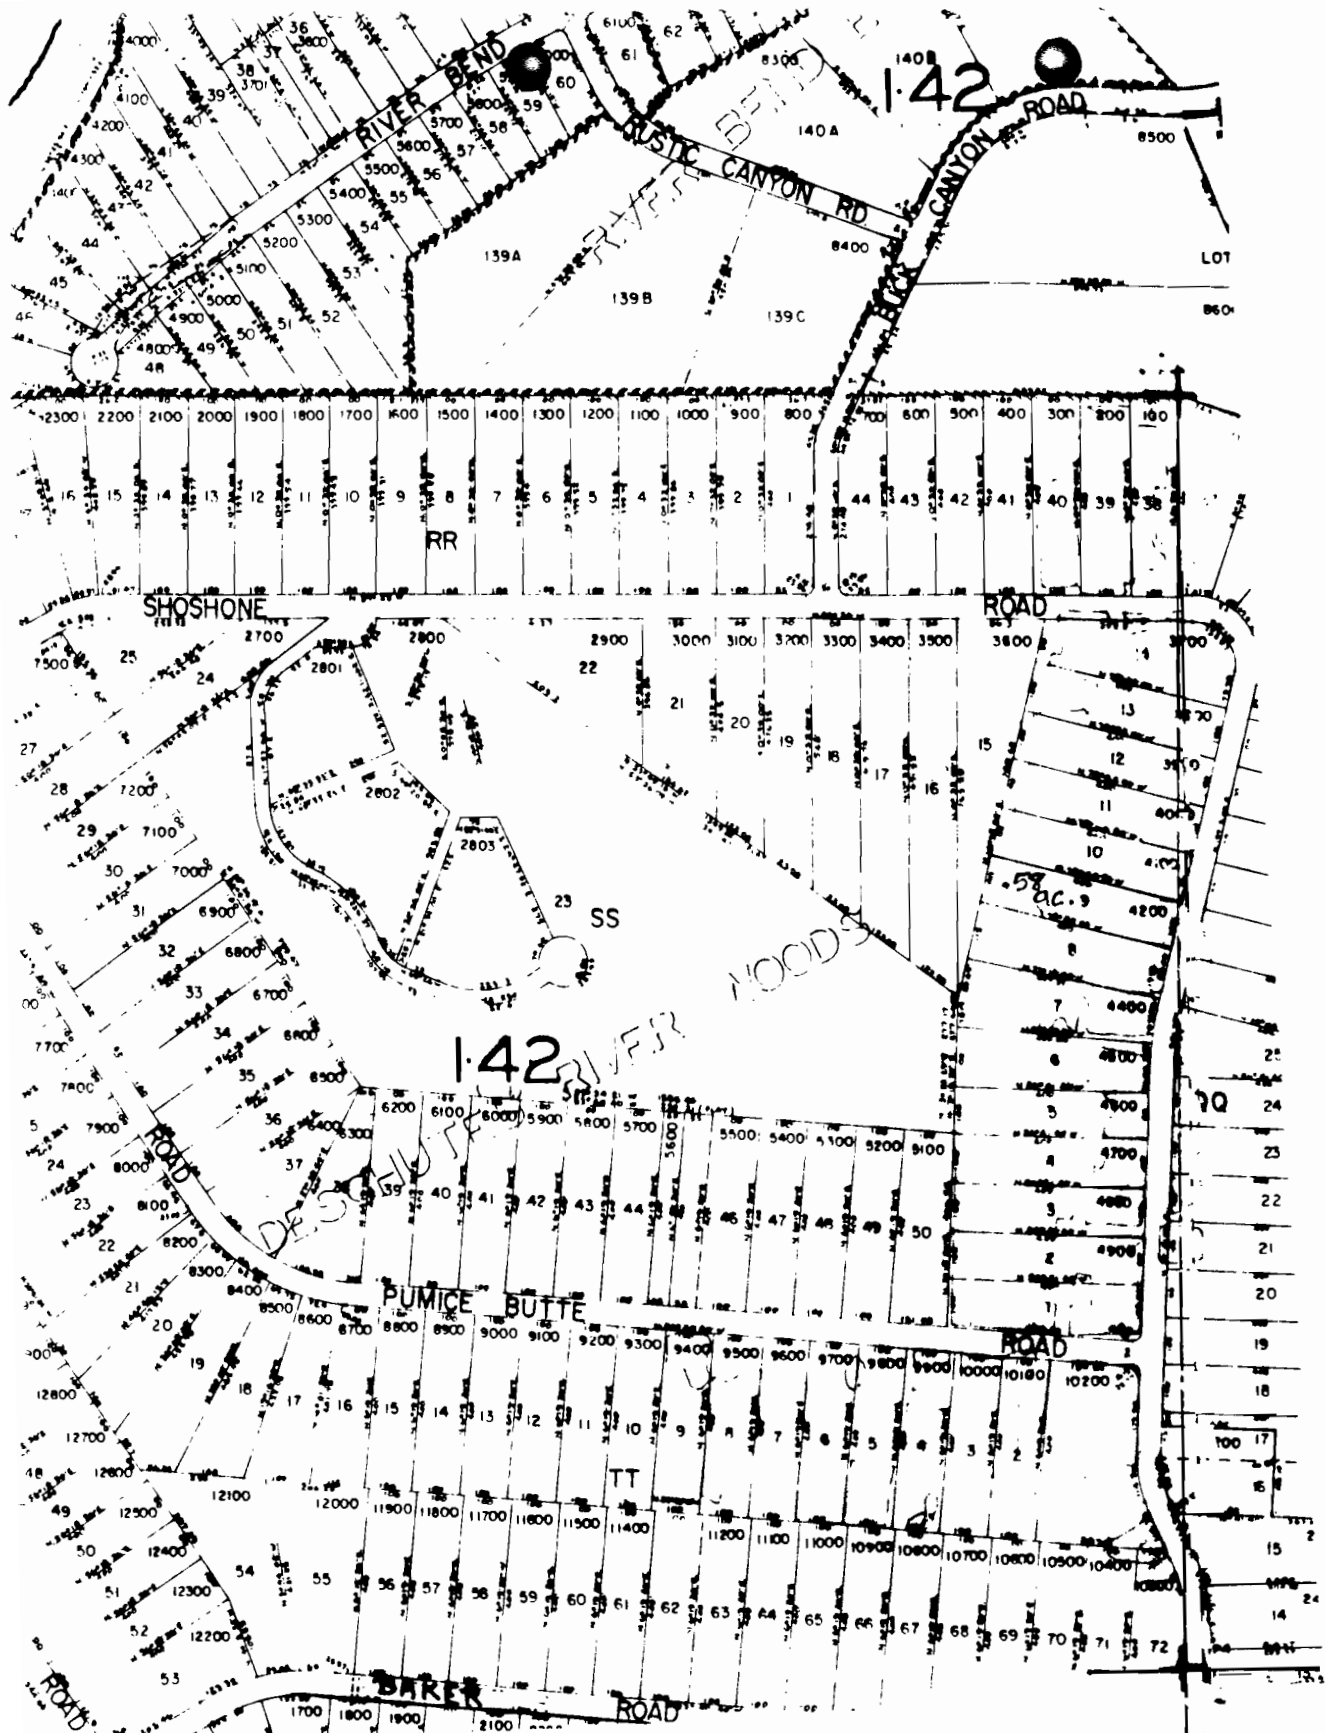

18-11-23 NESE Tax Lot # 4200


Scale 1" = 400'

Property Leasing Water

19223 Shoshone Rd., Bend, OR 97702


Water Being Leased .58 ac.

18-11-23

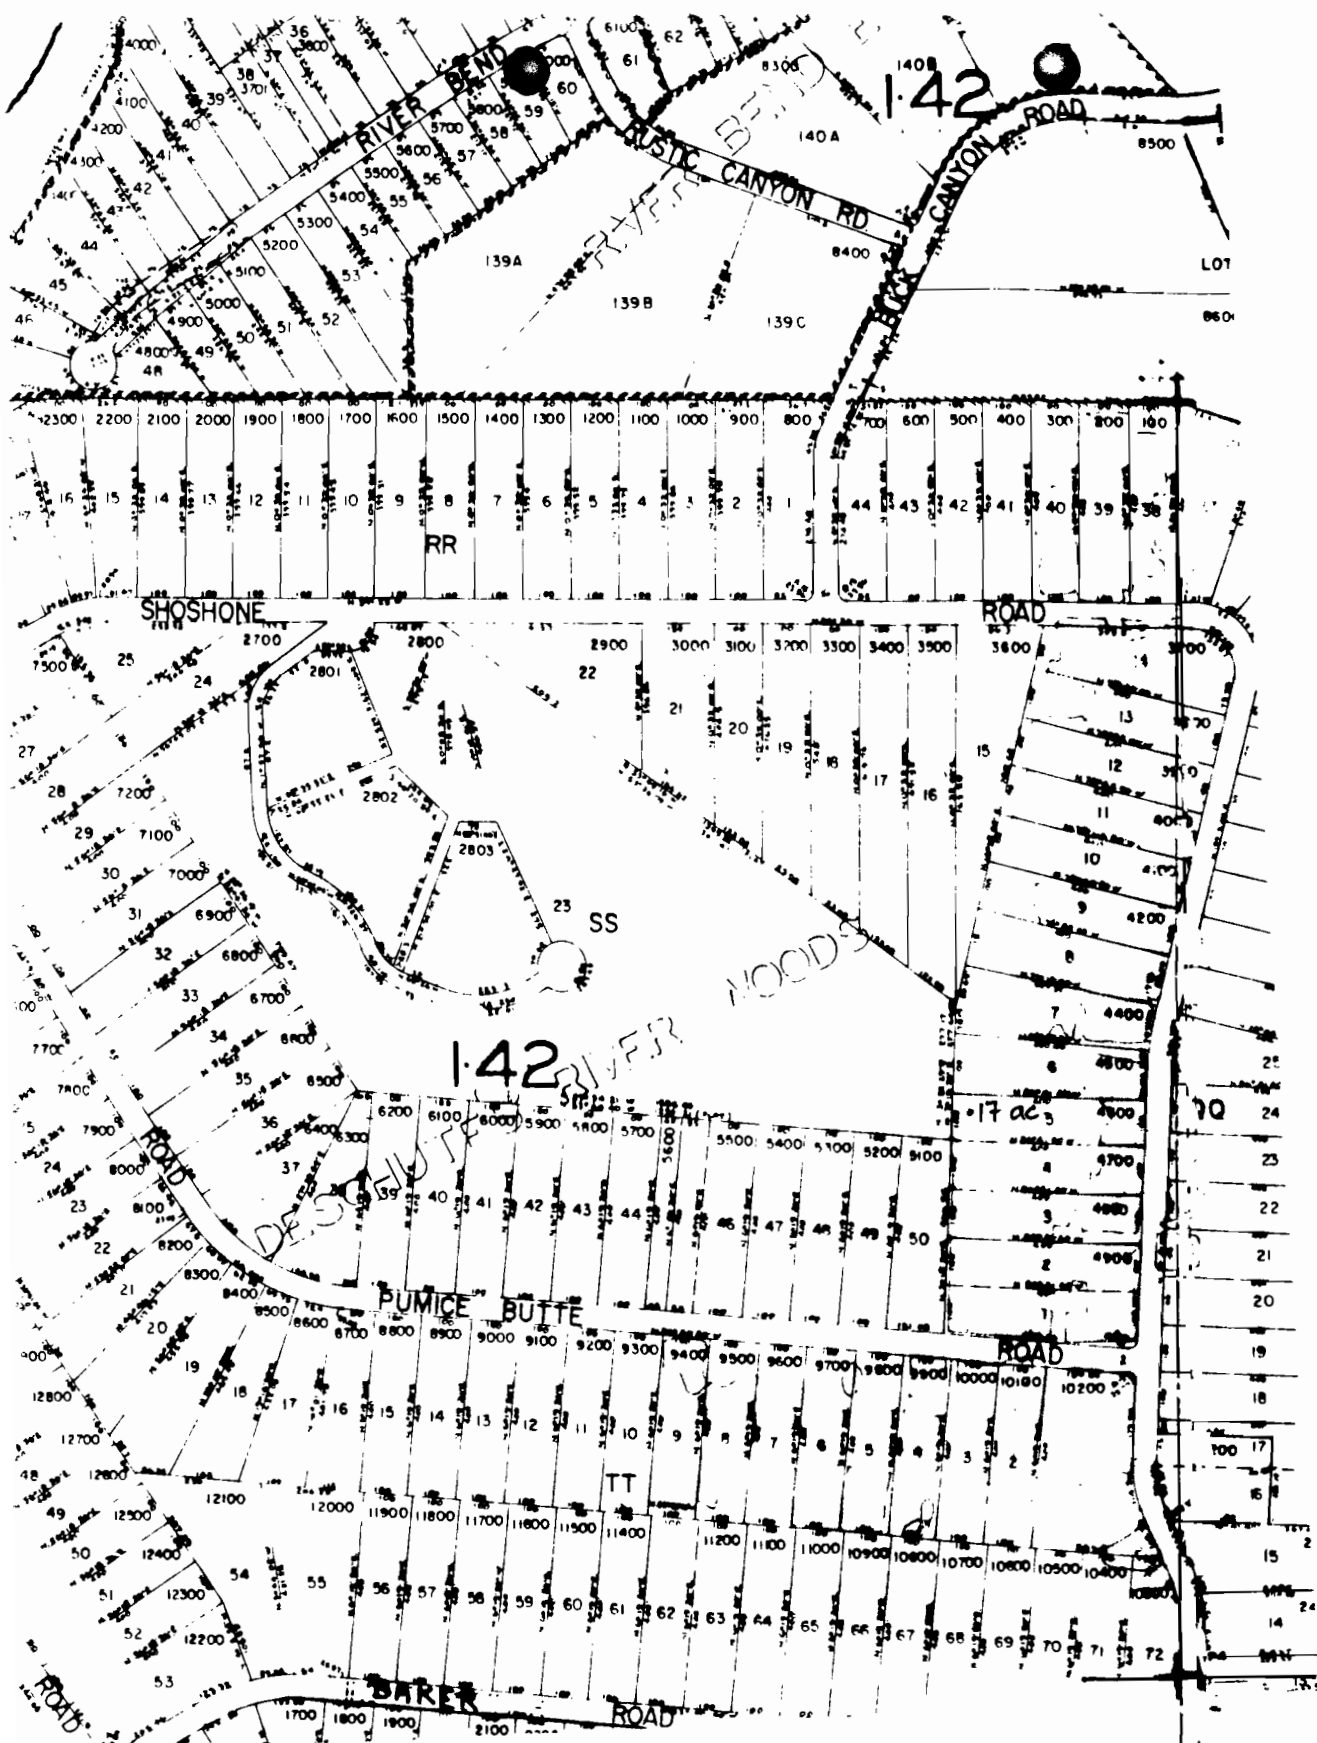

18-11-23 SESE Tax Lot #4600
 Scale 1" = 400'
 Property Leasing Water
 19231 Shoshone Rd., Bend, OR 97702
 Water Being Leased .17ac

18-11-23

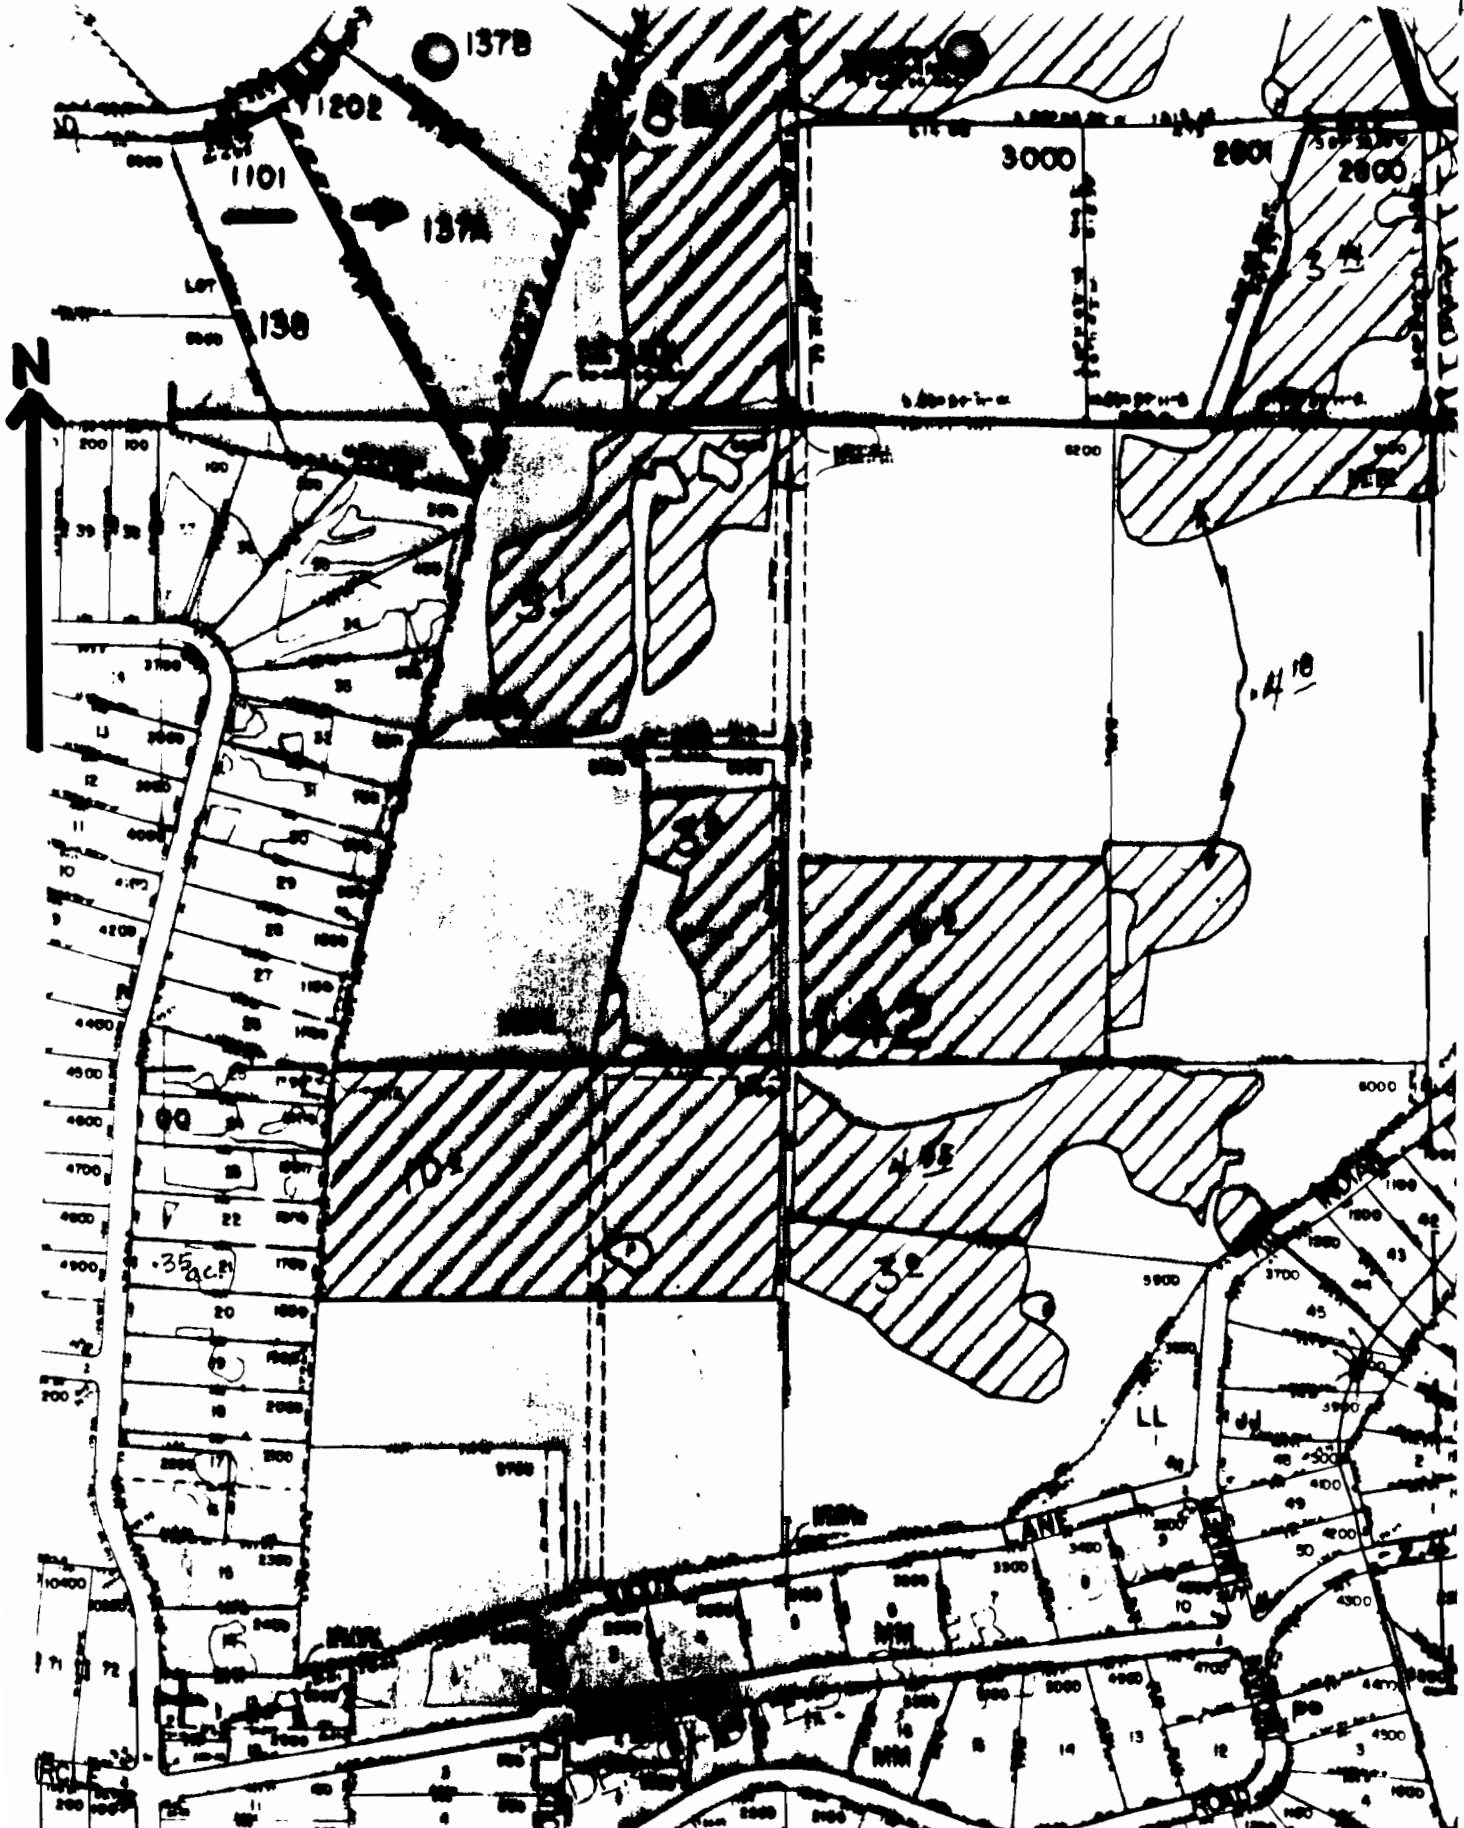

18-11-24 SWSW Tax Lot #1700 Scale 1" = 400'
 19236 Shoshone Rd., Property Leasing Water
 Bend, OR 97702
 Water Being Leased .35 ac.

AID MAIN CANAL

GATION DISTRICT COUNTY, OREGON

7 17 T. 18 S., R. 12 E., W.M.

18-12-17 NW NE Tax Lot # 1002

Scale 1" = 400'

Property Leasing Water

61165 Parrell Rd.,

Bend, OR 97702

Water Being Leased .50 ac

