


TOWNSHIP 19 S., RANGE 44 E., W.M.


IRRIGATION SYSTEM KEY

- ◆ FOUND SECTION CORNER
- ◇ SECTION CORNER, NOT FOUND
- WELLS
- BUILDING
- TL TAX LOT
- ▨ AREA REMAINING UNDER PERMIT G-1226
- ▩ AREA WITH PRIMARY WATER RIGHT PERMIT G-9198
- ▧ AREA TO BE TRANSFERRED FROM PRIMARY RIGHT UNDER PERMIT G-1226 TO PRIMARY RIGHT FROM WELLS 1&2
- ..... SPRINKLER SYSTEM RISERS
- J-H CANAL
- - - CONCRETE DITCH

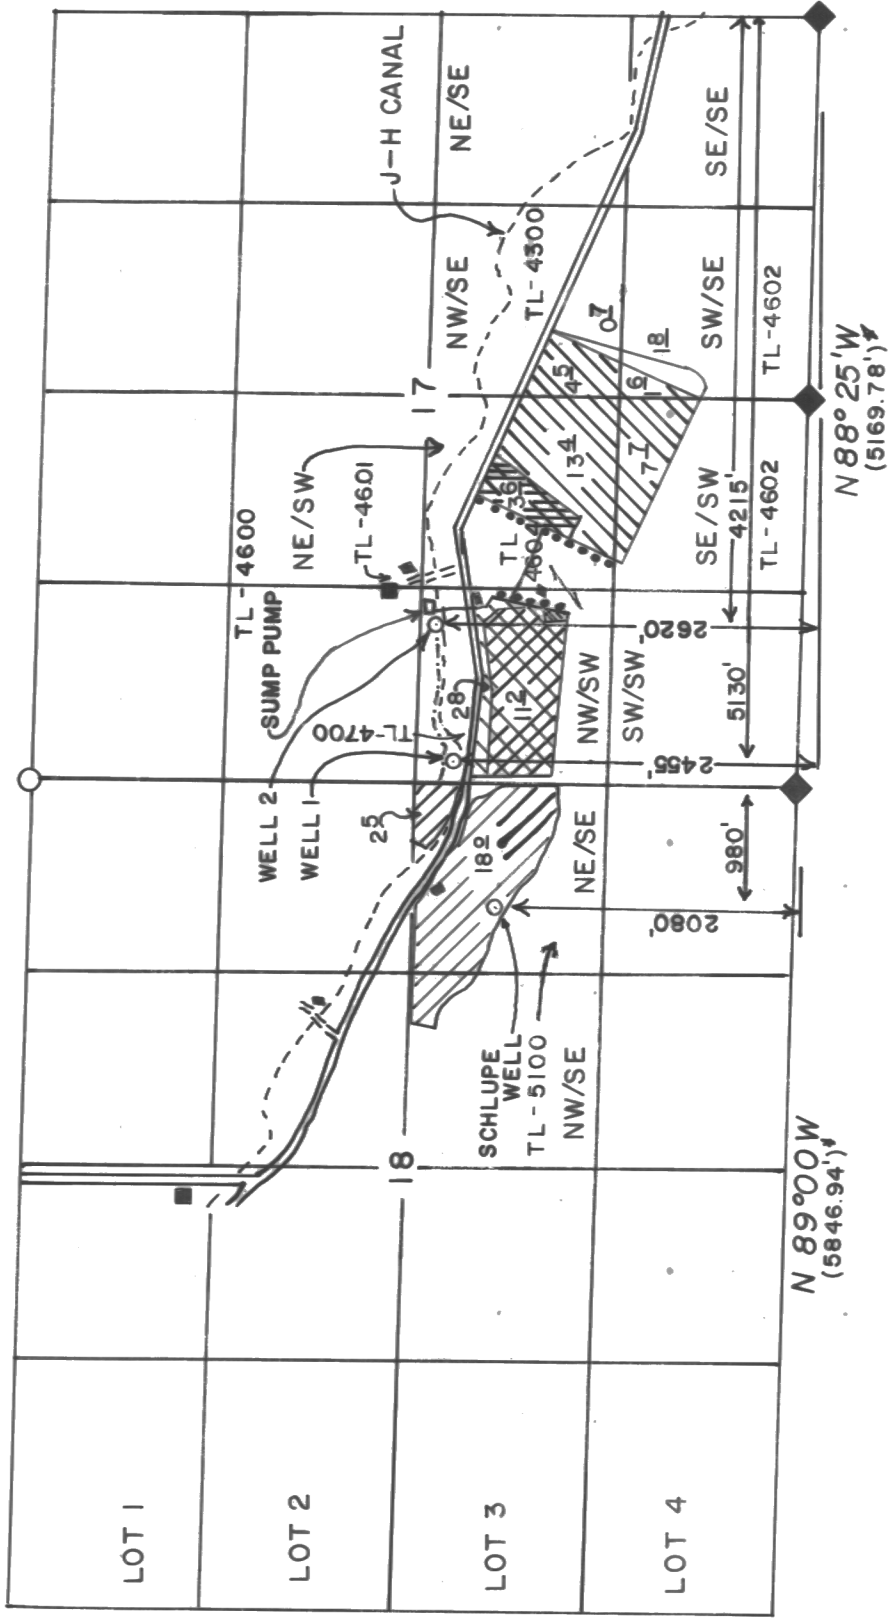

NOTES

1. THIS MAP IS FOR THE PURPOSE OF LOCATING A WATER RIGHT AND IS NOT INTENDED TO PROVIDE LEGAL DIMENSIONS FOR LOCATION OF PROPERTY BOUNDARIES.
2. DISTANCES SHOWN ON THIS WERE CALCULATED FROM FIELD SURVEYS
3. \* INDICATES BEARING AND DISTANCE OF RECORD
4. AREA SOUTH OF CANAL IN SECTION 17 IS BEING IRRIGATED BY SPRINKLERS FROM WELLS 1&2
5. SECTION 18:  
TAX LOT 5100 - HENRY & JUDY BISHOP  
SECTION 17:  
TAX LOT 4600 - JOHN & HENRY BISHOP  
TAX LOT 4601 - JOHN BISHOP  
TAX LOT 4604 - JOHN BISHOP, et al  
TAX LOT 4700 - BISHOP BROS  
TAX LOT 4602 - BISHOP BROS  
TAX LOT 4300 - ALLEN HENDERSON  
EDMOND LABBE

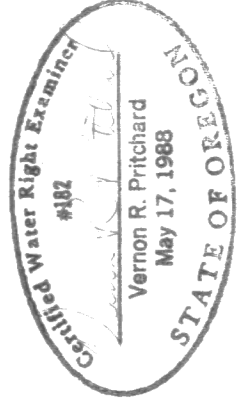

VERN PRITCHARD 503-473-3612  
P.O. BOX 134  
VALE, OREGON 97918

BISHOP BROTHERS

FINAL PROOF SURVEY  
T-6343

DRAWN *Diane M. Pritchard* SCALE 1" = 1320'  
APPROVED *John R. Pritchard* DWG NO. 008  
DATE JUNE 5, 1994 SHEET 1 OF 1