


CITY LIMITS ASHLAND, OREGON

RECEIVED  
 AUG 10 1966  
 STATE ENGINEER  
 SALEM, OREGON

SCALE 1" = 1000'



New point of diversion  
 for City of Ashland

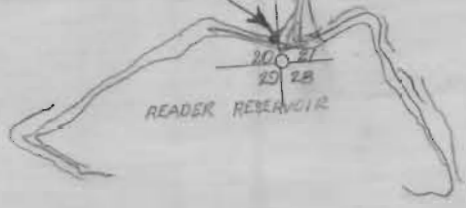

RECEIVED  
 NOV 15 1966  
 STATE ENGINEER  
 SALEM, OREGON