


T. 1 N. R. 42 E. W. M.

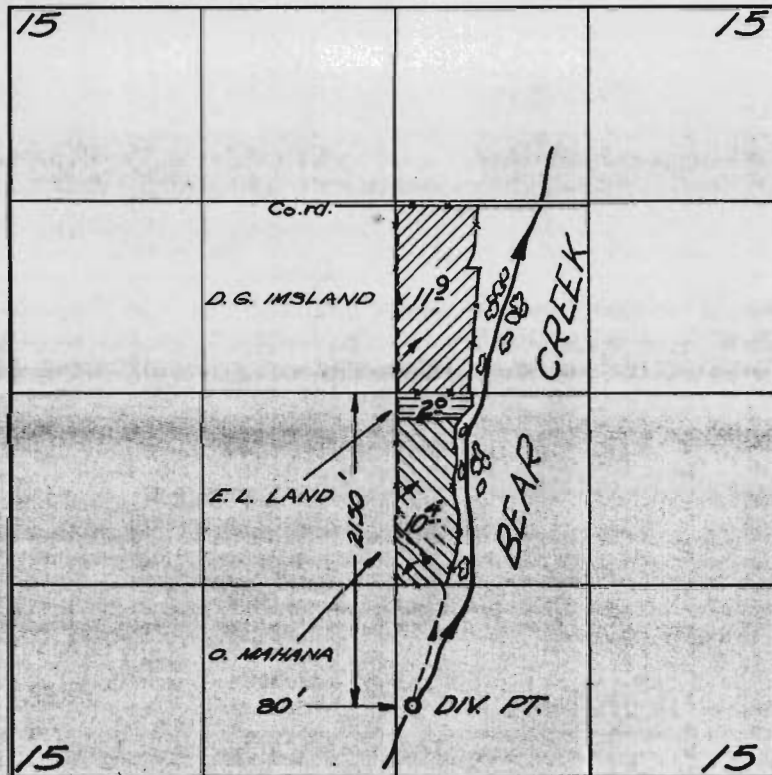

FINAL PROOF SURVEY UNDER

TRANSFER - T-1

Application No. Permit No.
IN NAME OF

DON G. IMSLAND — EARL L. LAND — ORIE MAHANA

Surveyed *June 24 1966*, by *V. GARNER*