


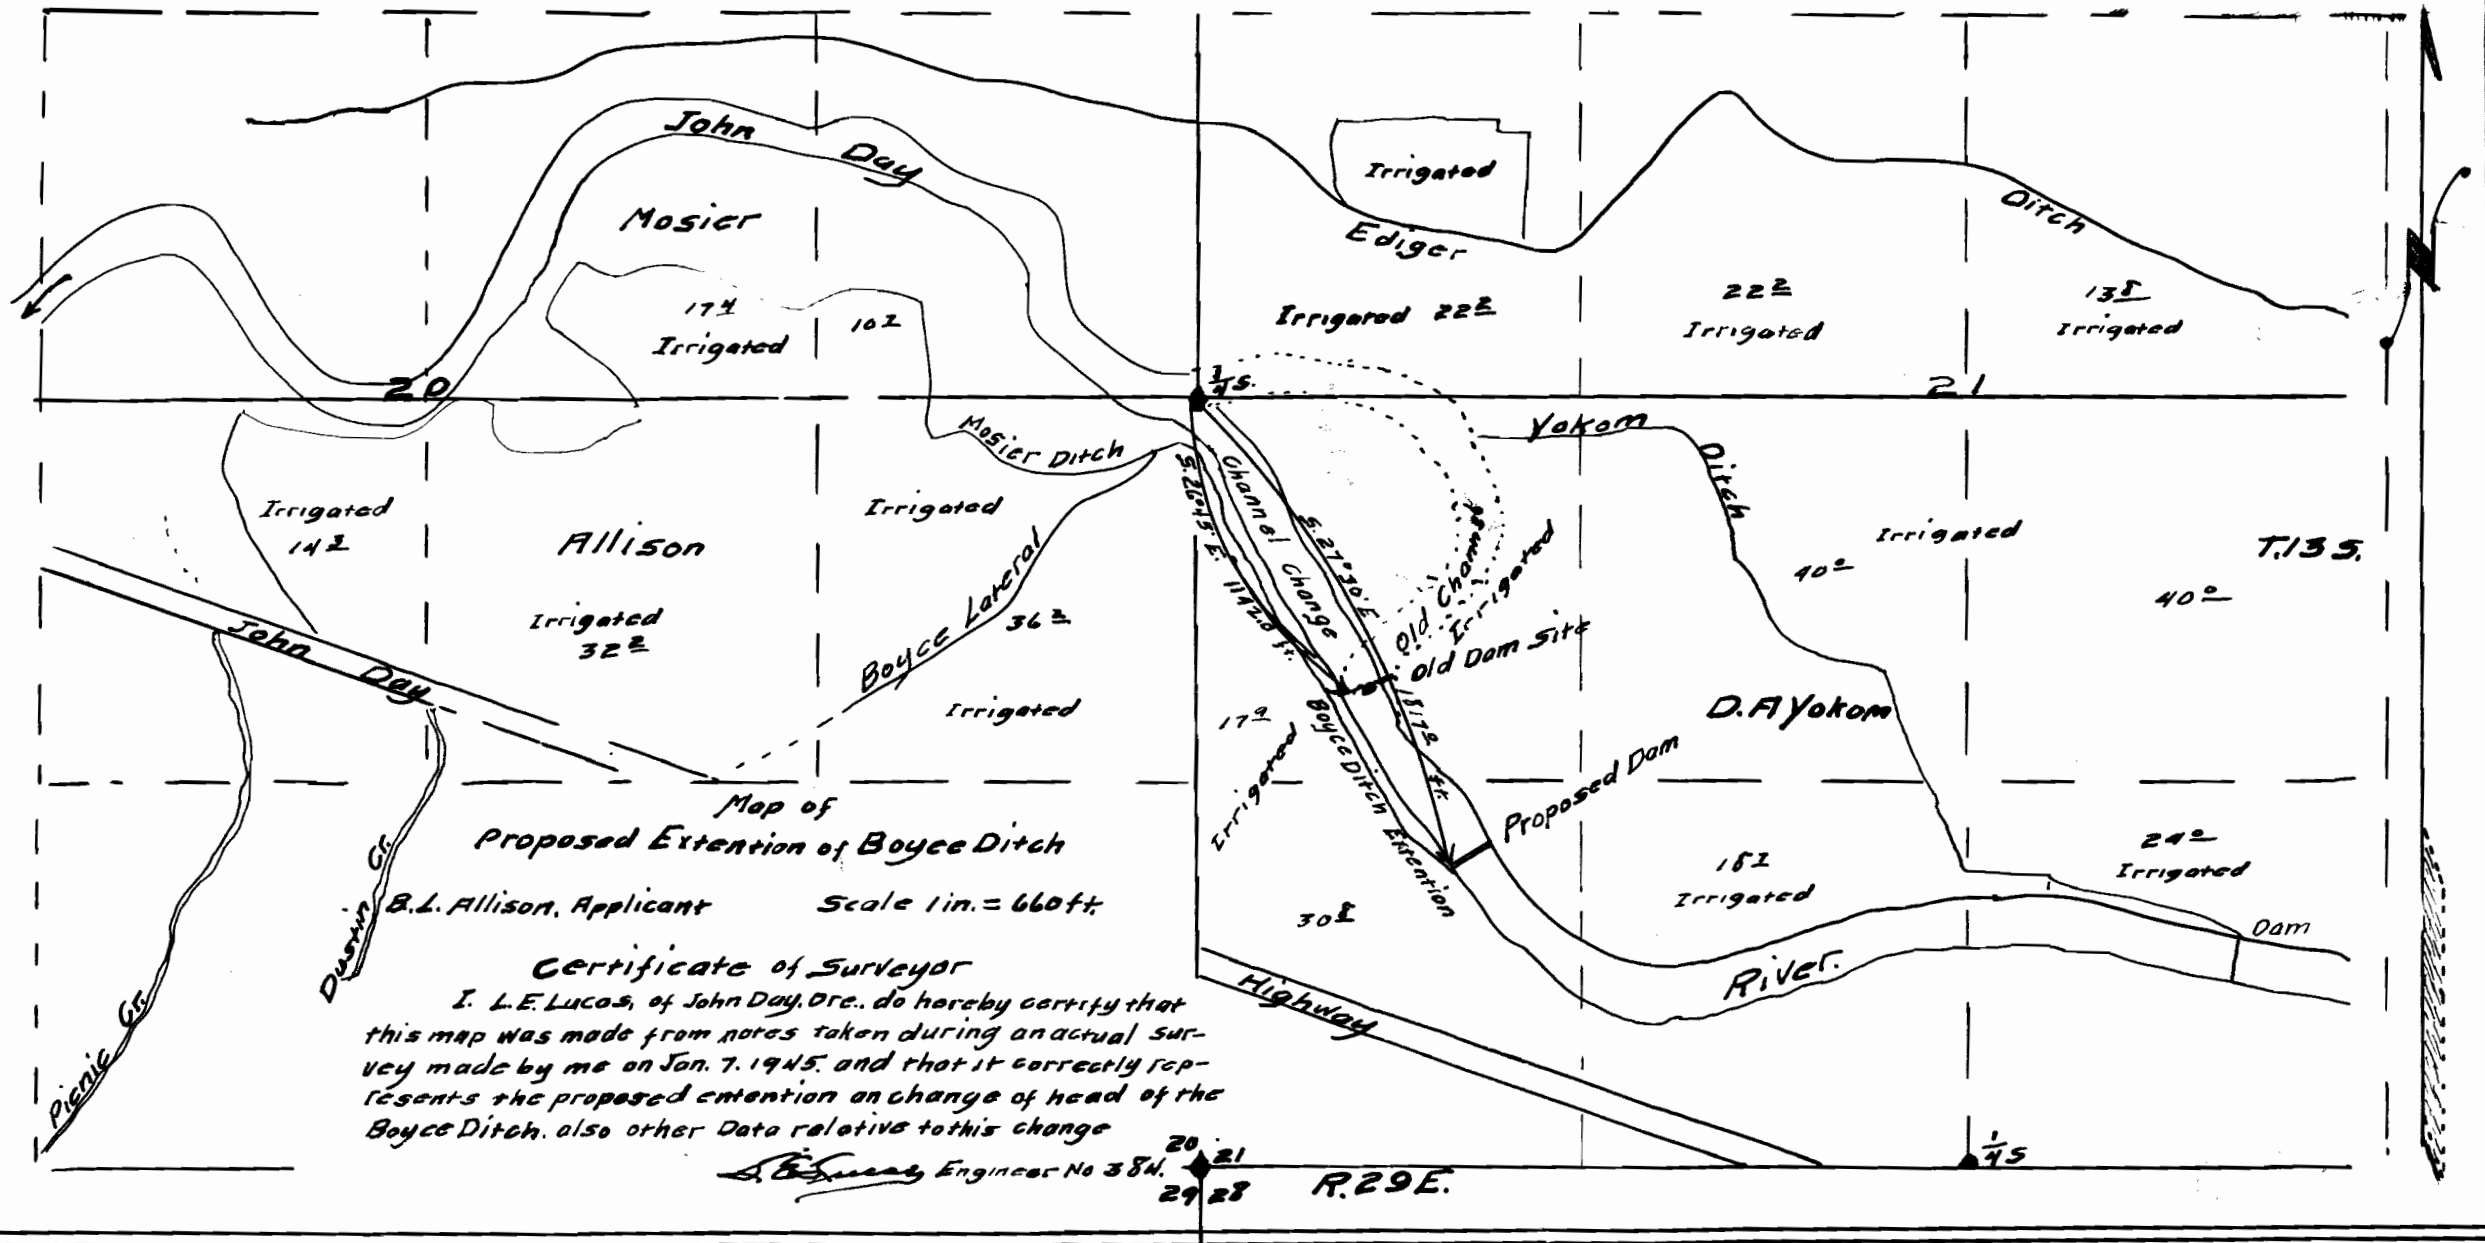

Map of
Proposed Extension of Boyce Ditch

B.L. Allison, Applicant

Scale 1 in. = 660 ft.

Certificate of Surveyor

I, L. E. Lucas, of John Day, Ore., do hereby certify that this map was made from notes taken during an actual survey made by me on Jan. 7, 1945, and that it correctly represents the proposed extension on change of head of the Boyce Ditch, also other data relative to this change

L. E. Lucas, Engineer No. 384.
29 28 R.29E.