


Sec 10

T.5S.R.31E.W.M.

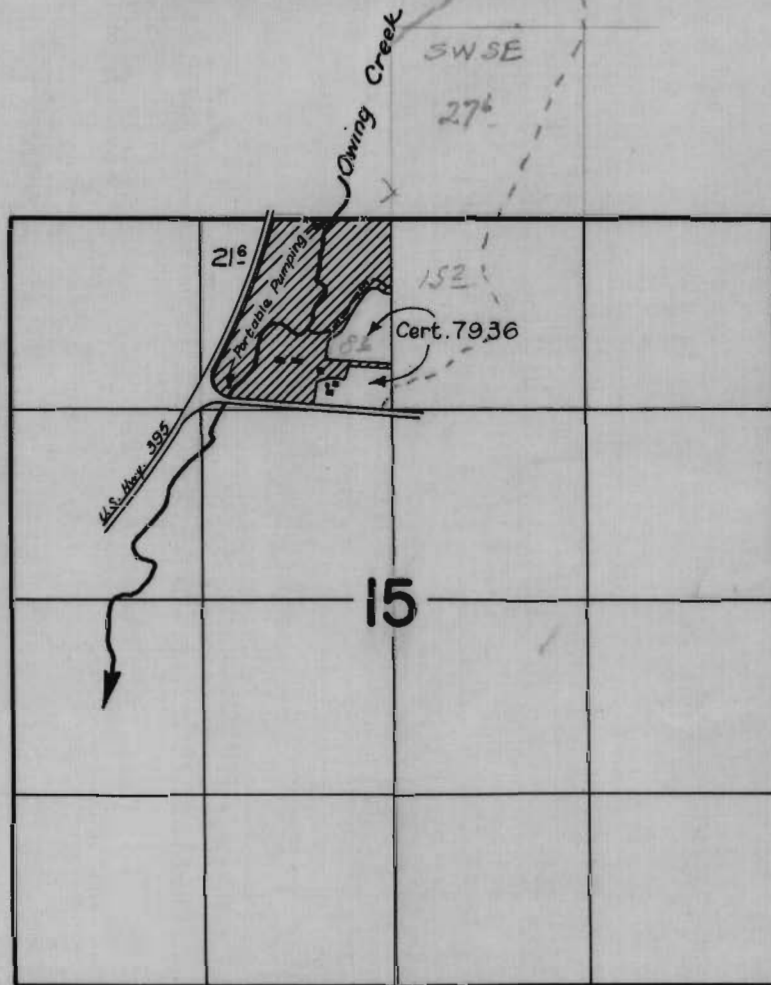

FINAL PROOF SURVEY UNDER

TRANSFER A-17

Application No. _____ Permit No. _____
IN NAME OF

WALTER W. WAGNER

Surveyed June 6, 1962, by *Al Peterson*