


T.4S.R.2E.W.M.

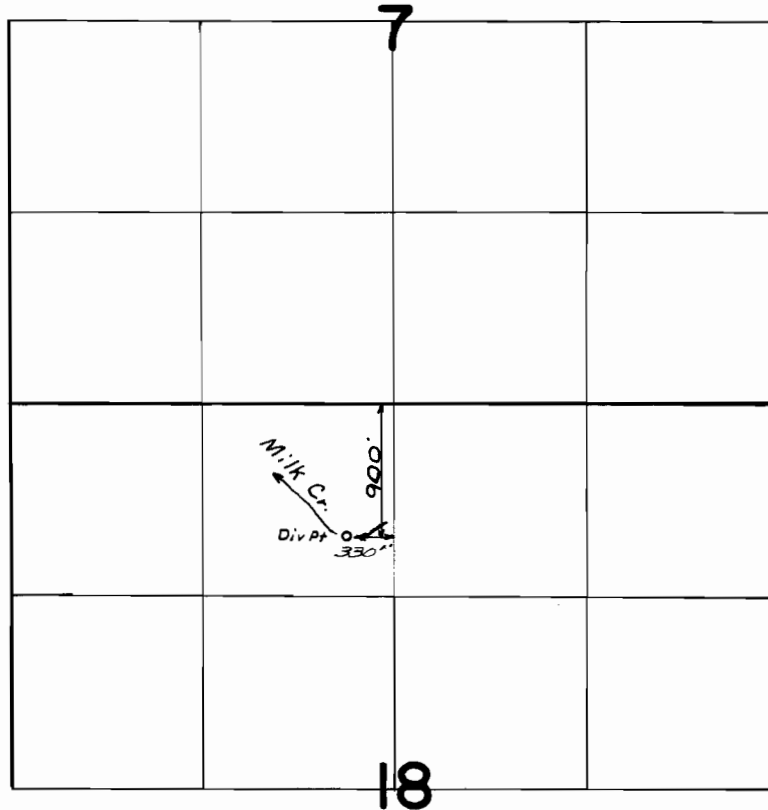

FINAL PROOF SURVEY
UNDER

Transfer *A-33*
Application No. Permit No.
IN NAME OF

.....*Oscar Alber*.....

Surveyed *Oct. 17, 1967,* by *W.J. Ruppert.*