


Scale: 1" = 1320'
 T 2 N R 27 E W. M.

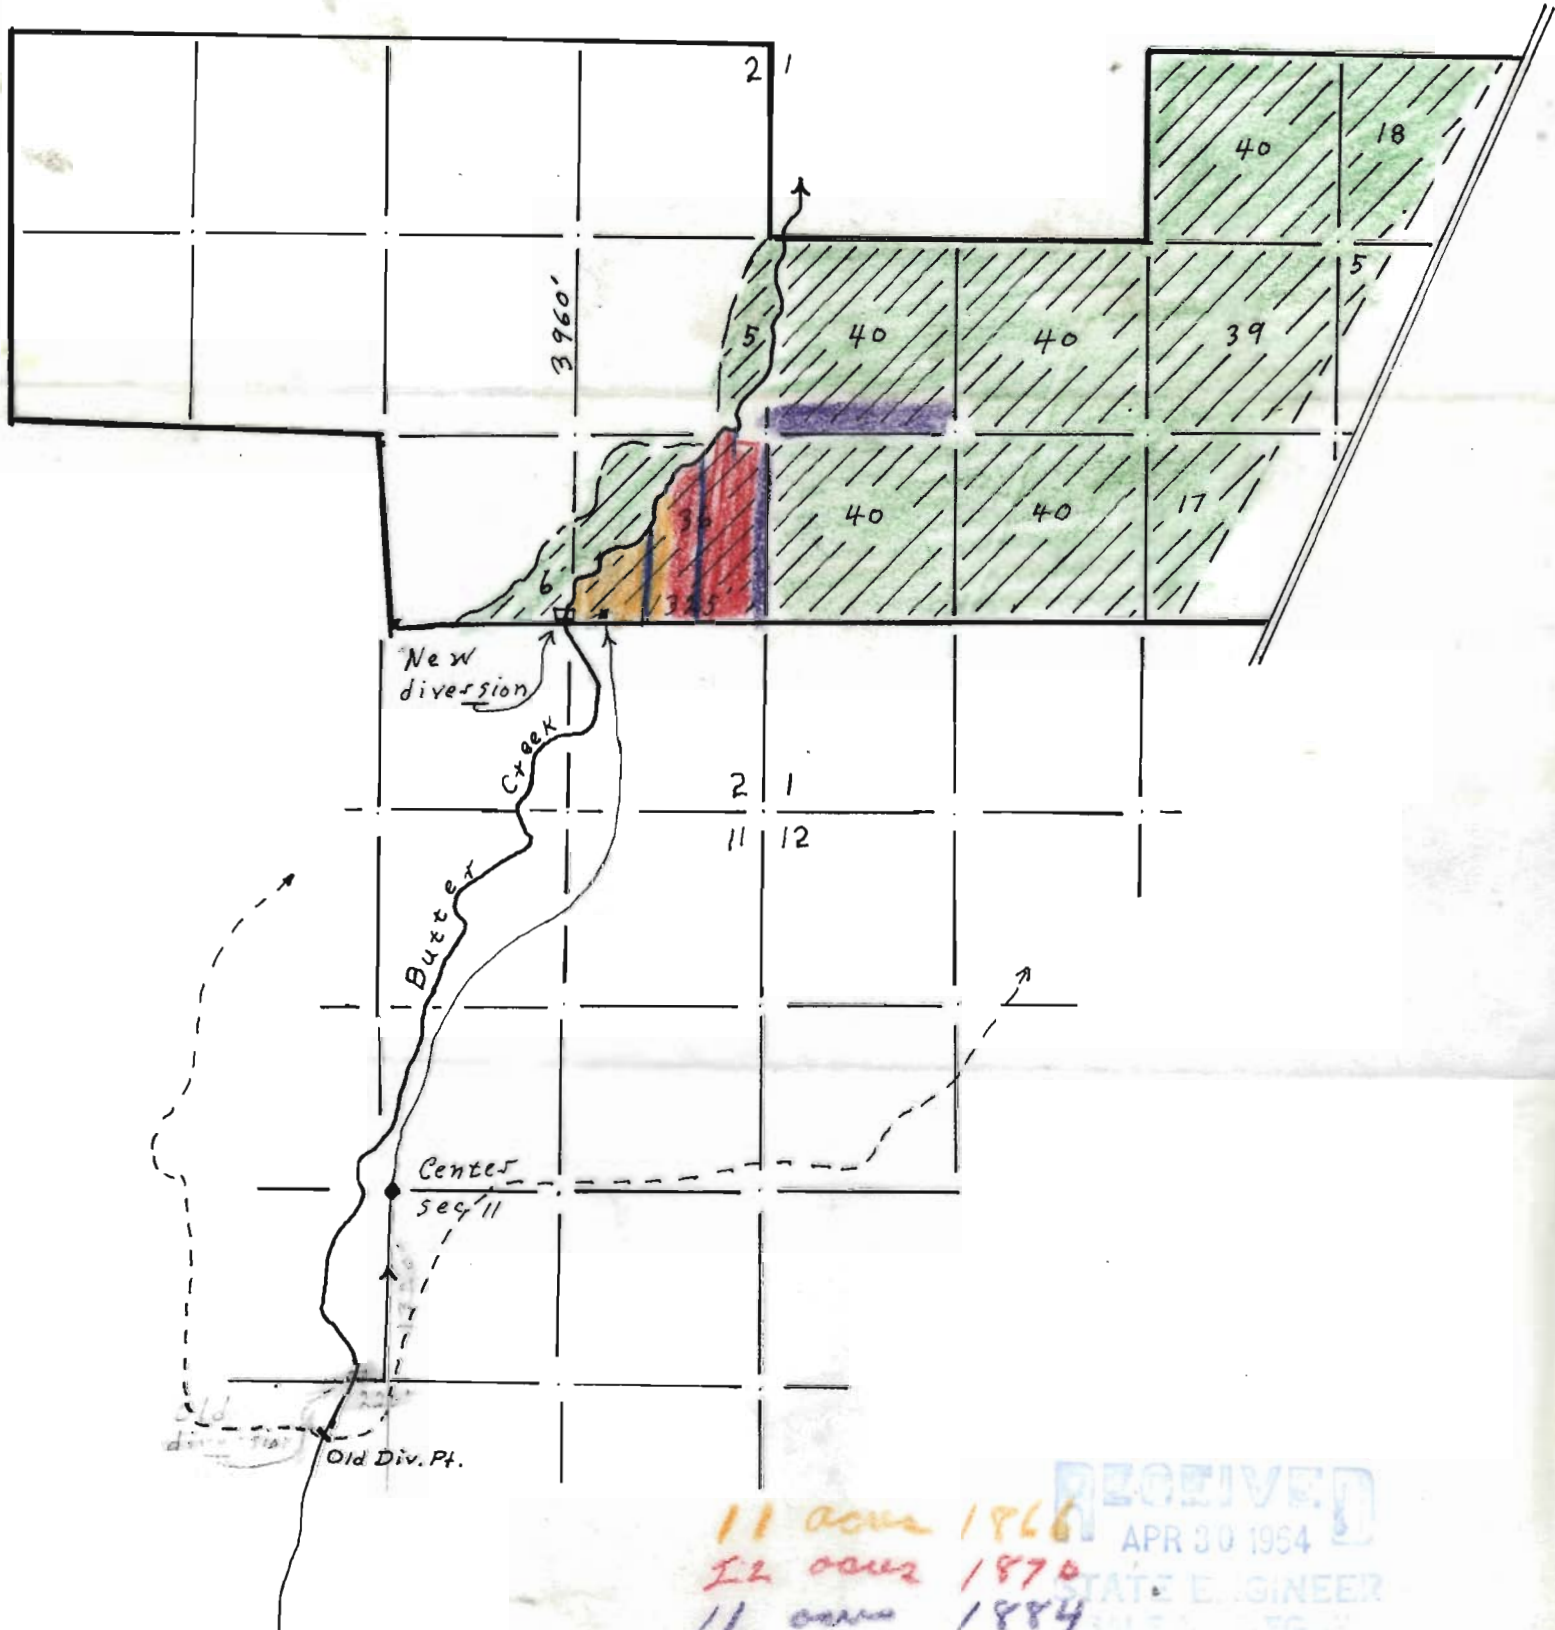

11 acres 1866
 12 acres 1870
 11 acres 1884
 182 acres 1896

RECEIVED
 APR 30 1954
 STATE ENGINEER
 RALPH W. BRIGGS