


T. 1 S. R. 13 E. W.M.

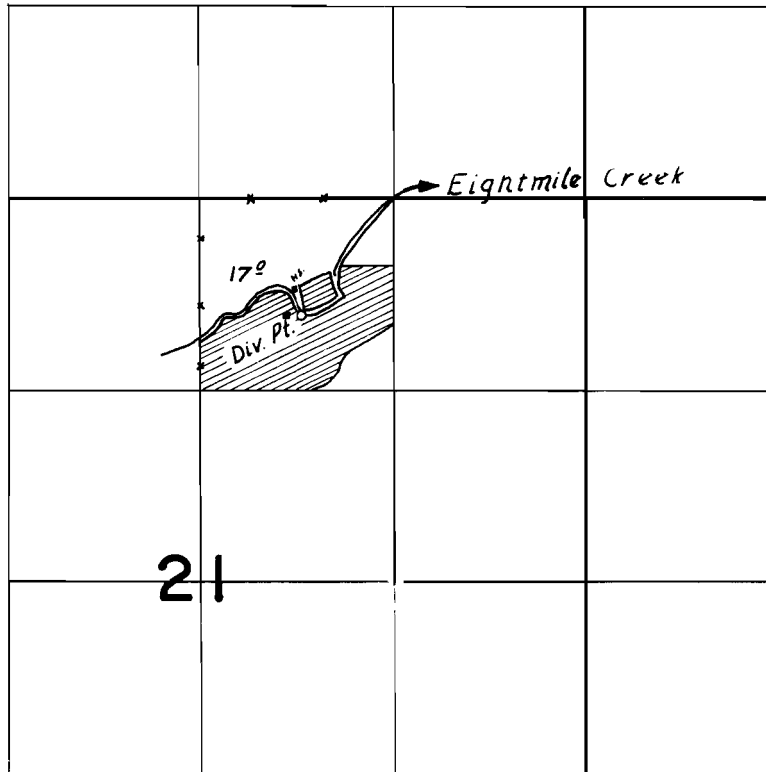

Transfer No. A-35
IN NAME OF

Arthur & Elizabeth Appling

Surveyed Dec. 9, 1964 by *Arny W. Ghousek*