


T.35 S., R.1 W., W.M.

SEC. 31

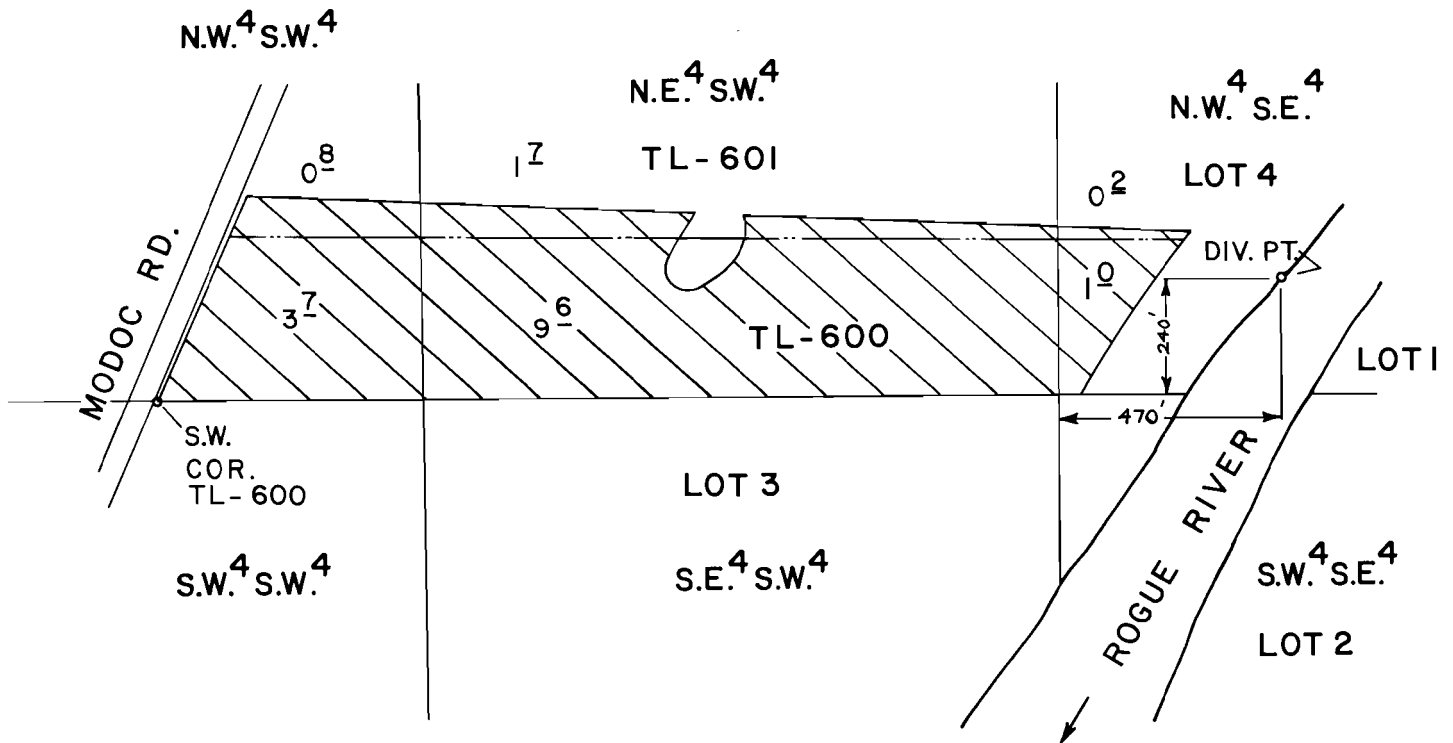

SCALE : 1" = 400 FT.

FINAL PROOF SURVEY UNDER

Transfer No. A-44

Application No. Permit No.

IN NAME OF

WILLIAM L. MILLER & T. B. WILKINS

Surveyed DEC. 13 1979, by B. SUND

D.H.M.
PHOTO: 49(E.P.I.D.)