


T.29S. R.5W. W.M.

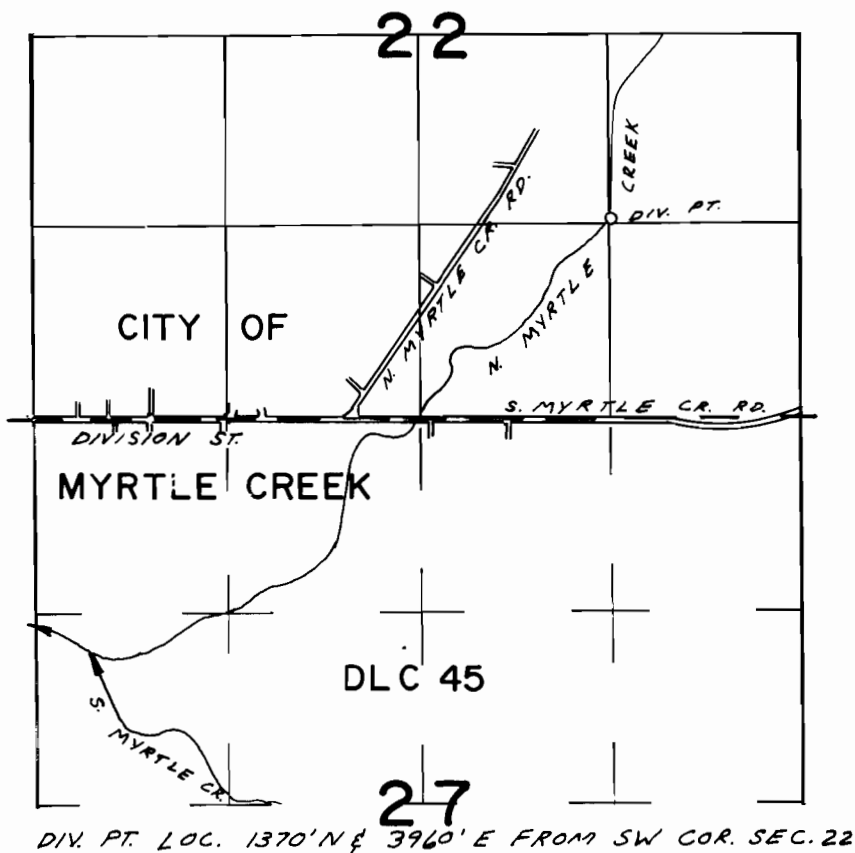

FINAL PROOF SURVEY
UNDER

TRANSFER NO. A-50
Application No. Permit No.
IN NAME OF

..... LEROY JUELKE

Surveyed JULY 12, 1974, by L.H. NUNN